



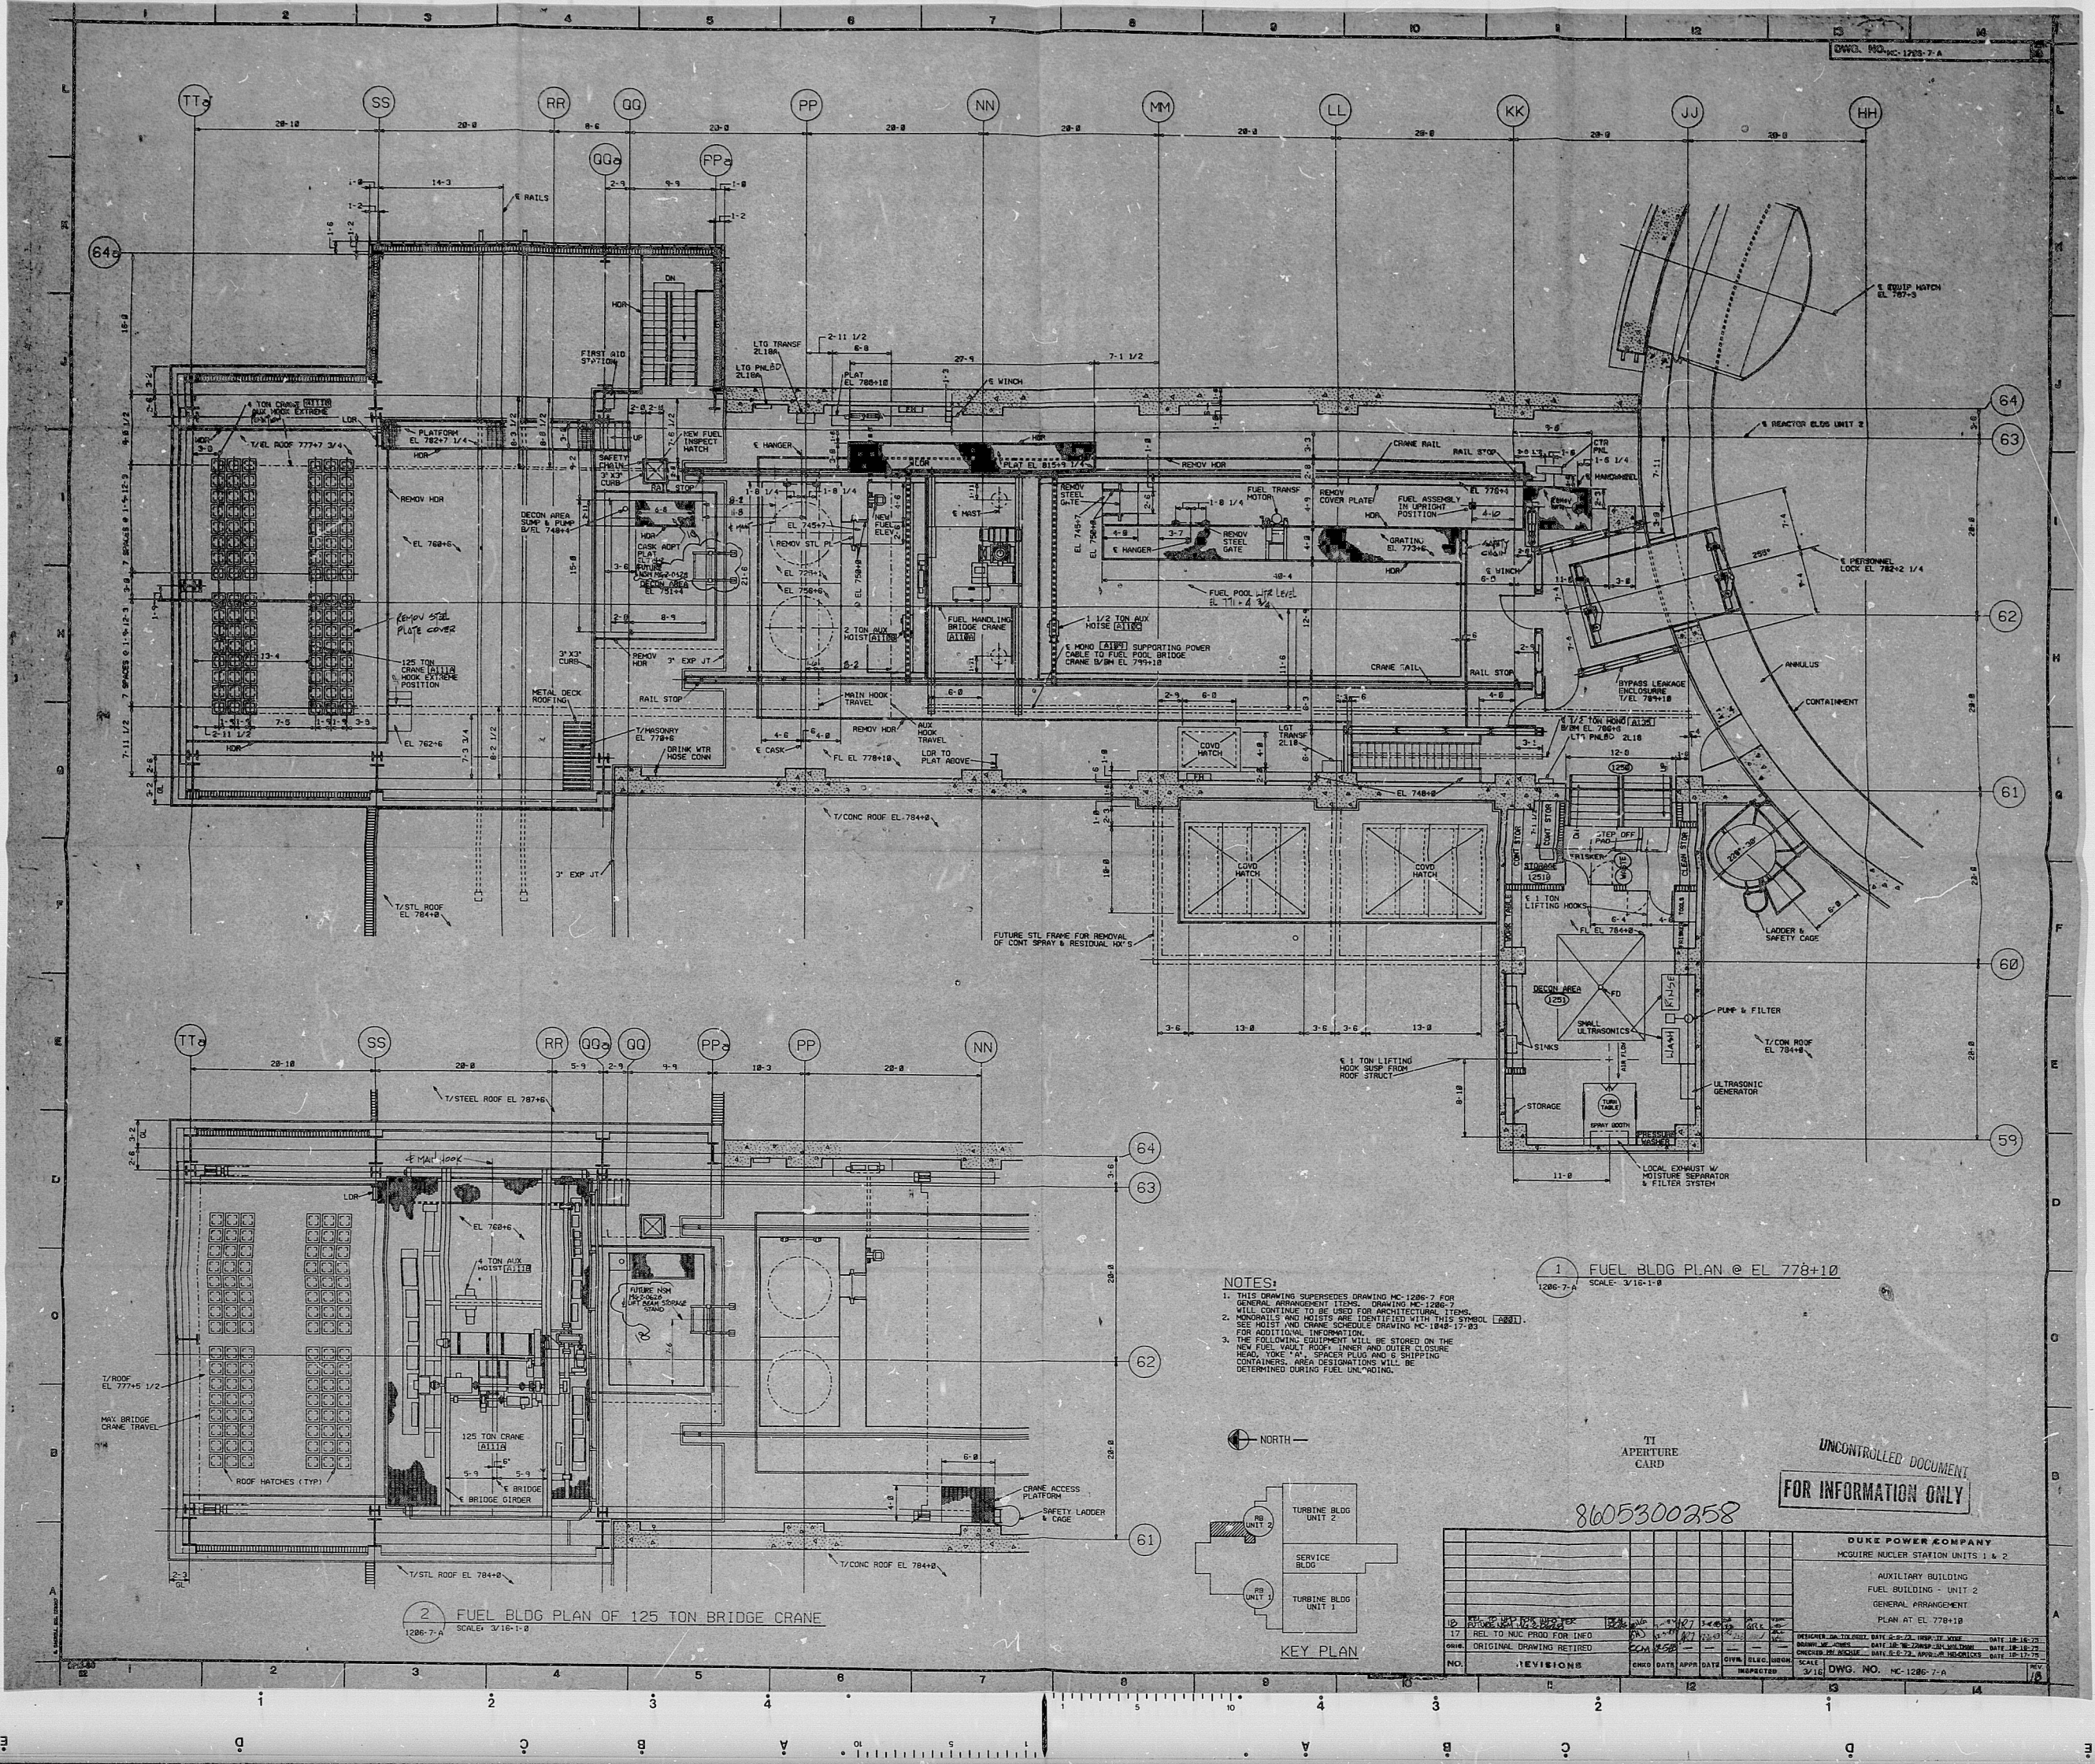

NOTES:  
1. THIS DRAWING SUPERSEDES DRAWING MC-1286-7 FOR GENERAL ARRANGEMENT ITEMS. DRAWING MC-1286-7 WILL CONTINUE TO BE USED FOR ARCHITECTURAL ITEMS.  

1 FUEL BLDG PLAN @ EL 778+10  
1286-7-A SCALE: 3/16"=1'-0"

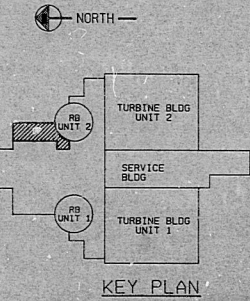

UNCONTROLLED DOCUMENT  
FOR INFORMATION ONLY

8605300258

| DUKE POWER COMPANY                |                          |           |             |
|-----------------------------------|--------------------------|-----------|-------------|
| AUXILIARY BUILDING                |                          |           |             |
| FUEL BUILDING - UNIT 2            |                          |           |             |
| GENERAL ARRANGEMENT               |                          |           |             |
| PLAN AT EL 778+10                 |                          |           |             |
| NO.                               | REVISIONS                | CHG. DATA | APPRO. DATA |
PDR RIDS

8605300258

