

	CONSTRUCTION	
	LIMITED CONSTRUCTION: AS NOTED	
	PRELIMINARY NOT FOR CONSTRUCTION	
	BIDDING PURPOSES	
3/26/86	REFERENCE	MBF
DATE	RELEASED FOR	ENGR.


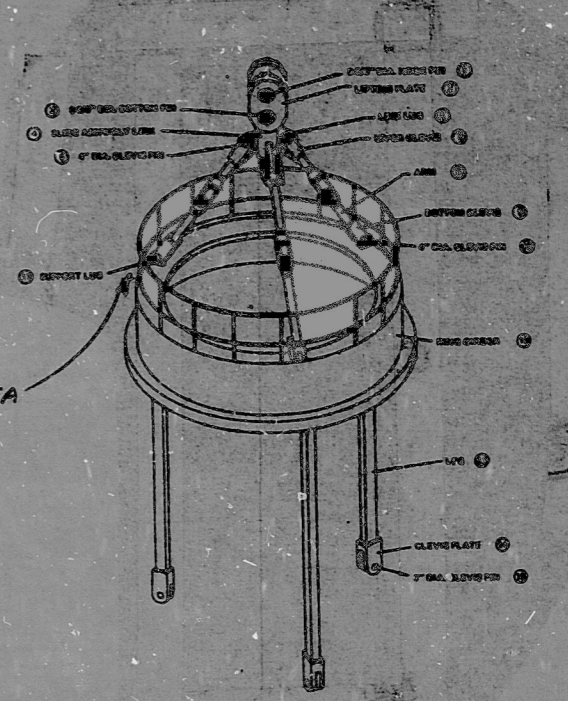



Figure 2 - Reactor Vessel Hoist (TYP) 81g

SUPPORT LUG, RING GIRDER, LEG ASSEMBLY
(VIEW ROTATED 90° FOR CLARITY)

XXX WELD OF SUPPORT LUG TO RING GIRDER
 ||||| WELD OF LEG TO SUPPORT LUG

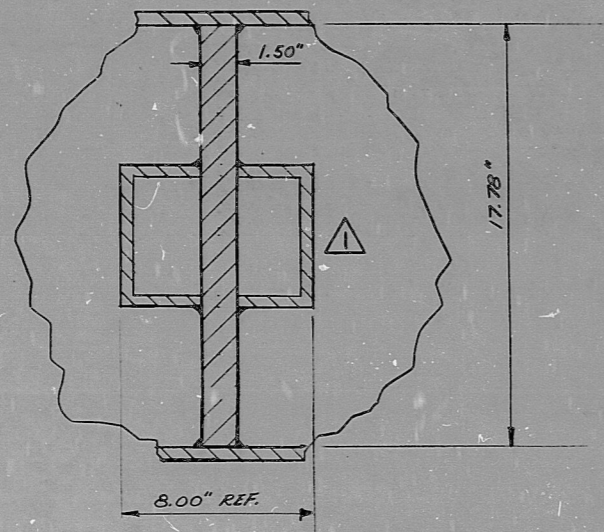

SECTION A-A

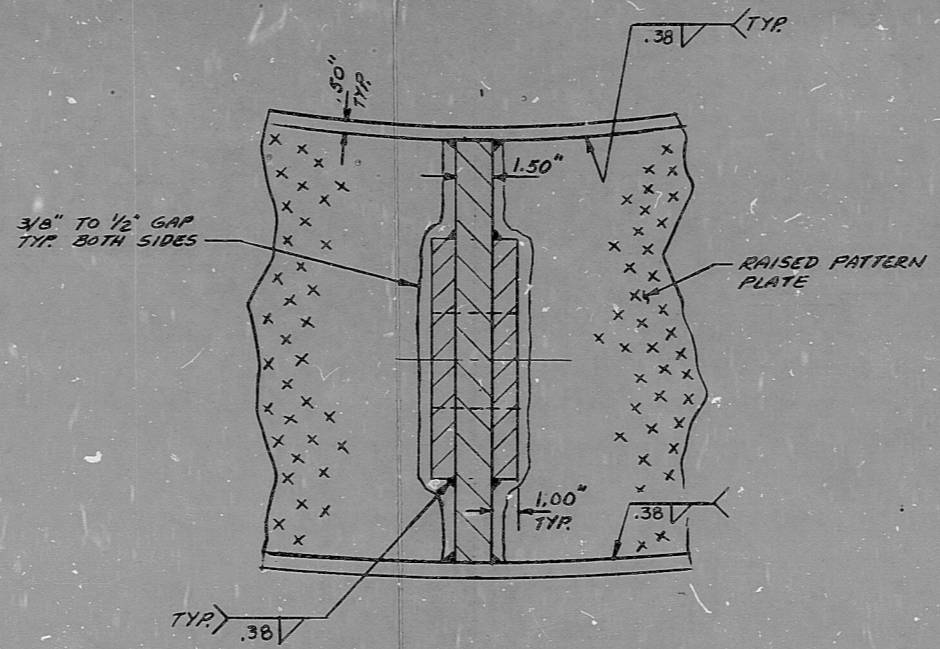

SECTION B-B

REFERENCE DWGS.
 WESTINGHOUSE - 54F385
 WESTINGHOUSE - 684J718
 R.G.&E - 33013-1391

△					
△					
△	REVISED AS NOTED	NJA			
△	ORIGINAL	NJA	MBF		
	DATE	3/21/86	3-24-86	3/23/86	3-2-86
NUMBER	REVISION	DRAWN BY	CHECKED	RESP. ENGR.	ENG. MANG'R.
FACILITY GINNA STA.		ROCHESTER GAS & ELECTRIC CORP. ROCHESTER, NEW YORK			
SCALE 1" = 5"					
GINNA STATION - CONTAINMENT REACTOR VESSEL LIFT RIG ASSEMBLY LEG, RING GIRDER AND SUPPORT LUG WELD ASSEMBLIES					
JOB No.	DRAWING No.		REV.		
EWR 3059	21489-0549		△		

TI
 APERTURE
 CARD

8606040172

ATTACHMENT #3

CONTACT SUPPLY

PDR RIDS

8606040172

