



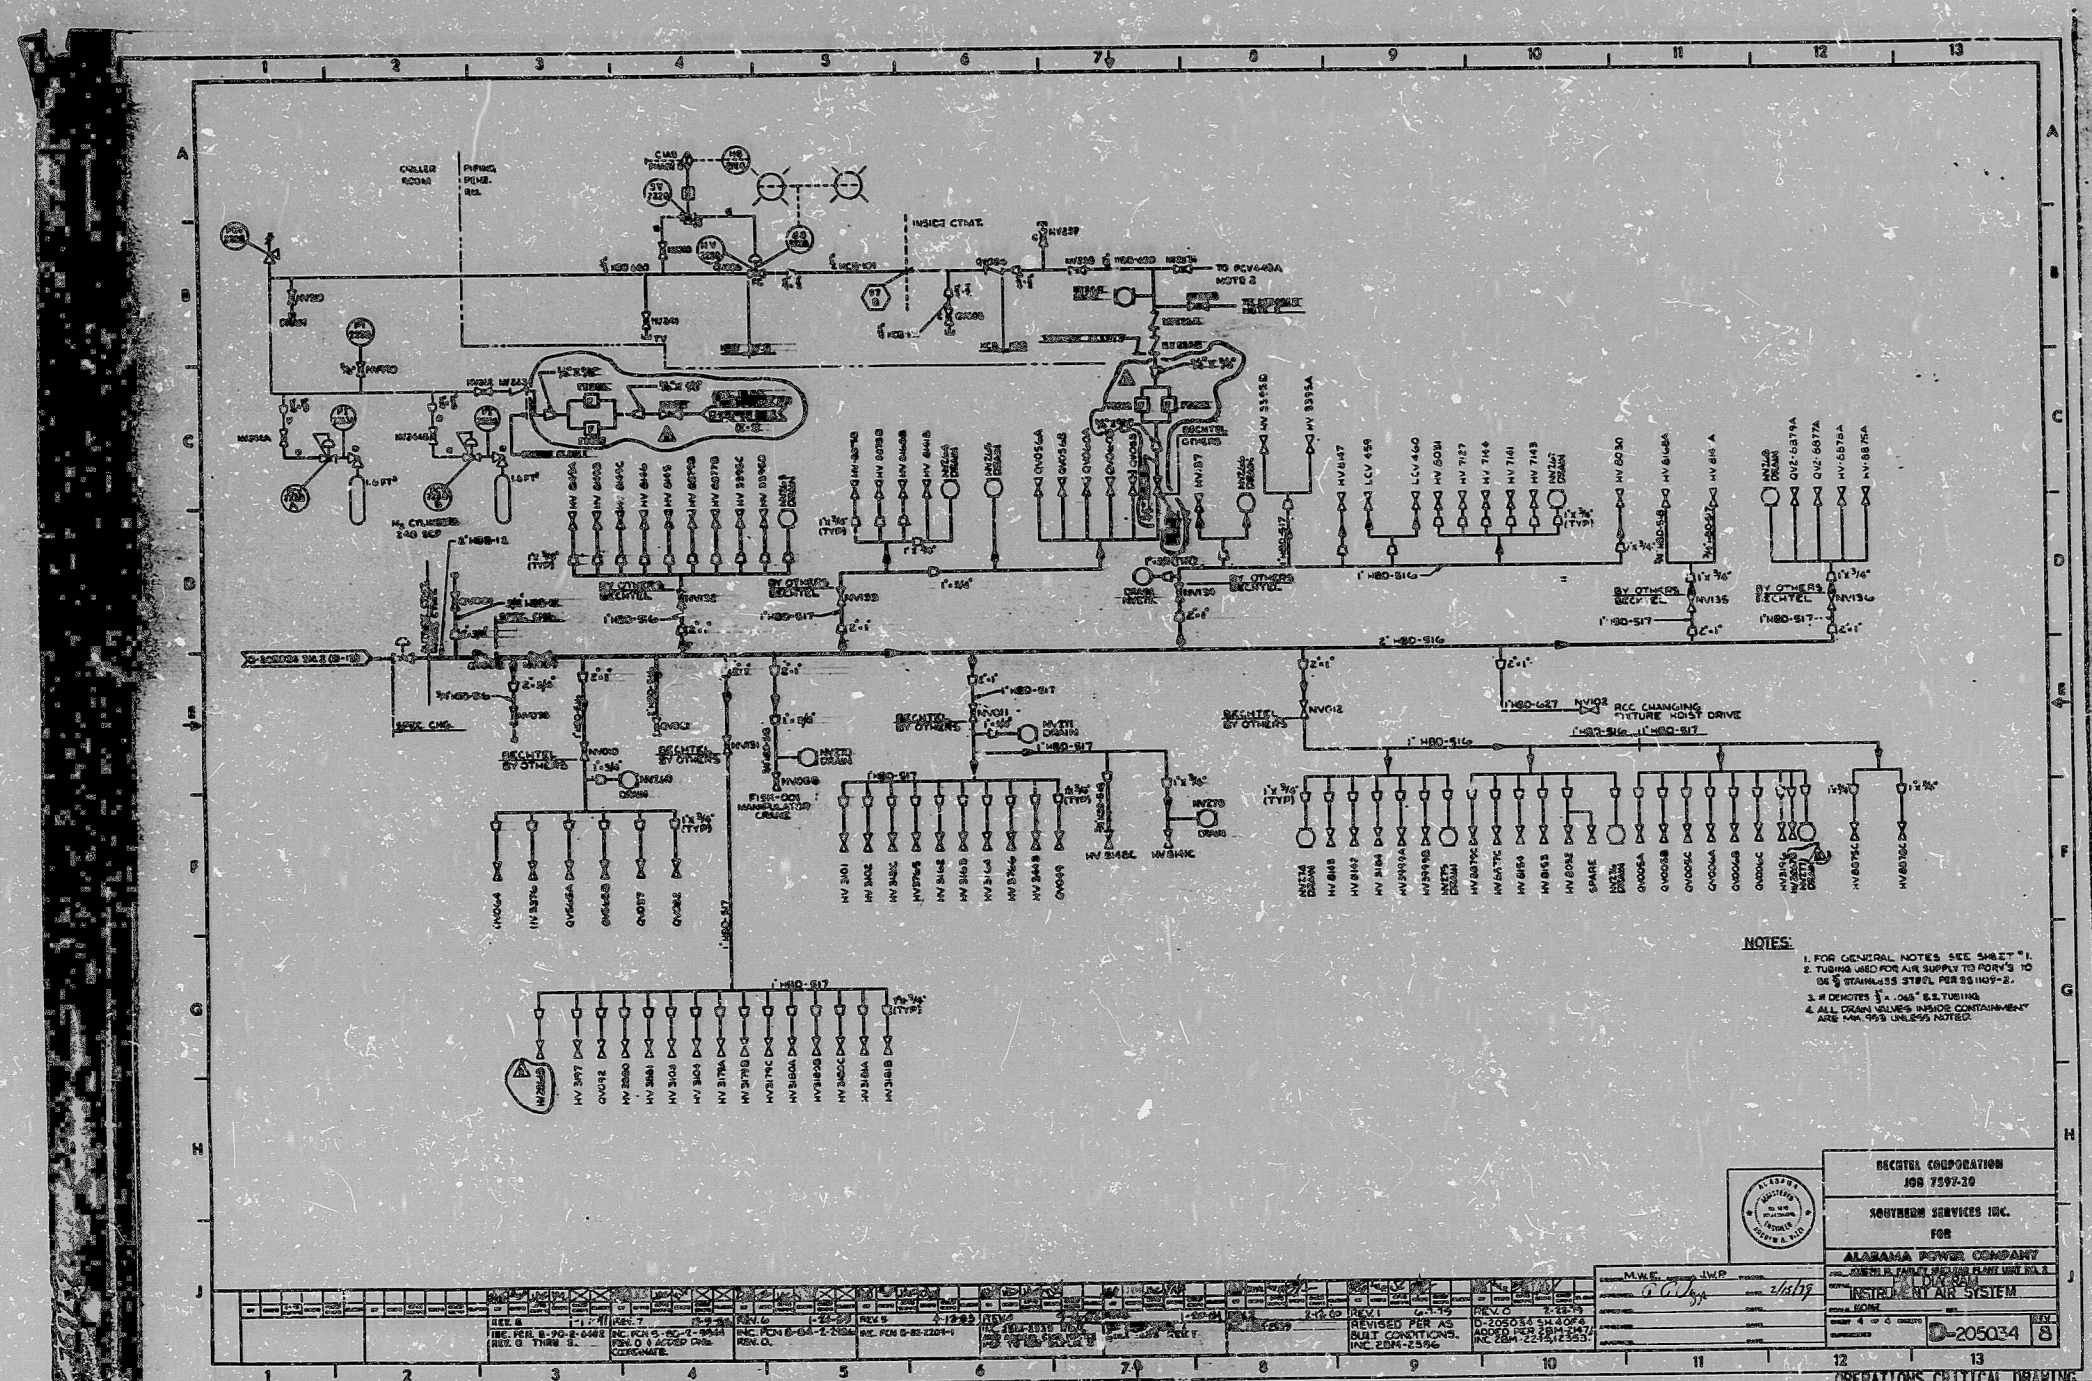

NOTES:
1. FOR GENERAL NOTES SEE SHEET "1".

ANSTEC
APERTURE
CARD

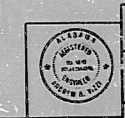

JOB 7597-20
SOUTHERN SERVICES INC.
FOR
ALABAMA POWER COMPANY
REV 8


PDR RIDS

9605200406

