


D-205039 SH 3 P&ID, CHEM. & VOL. CONTROL SYSTEM

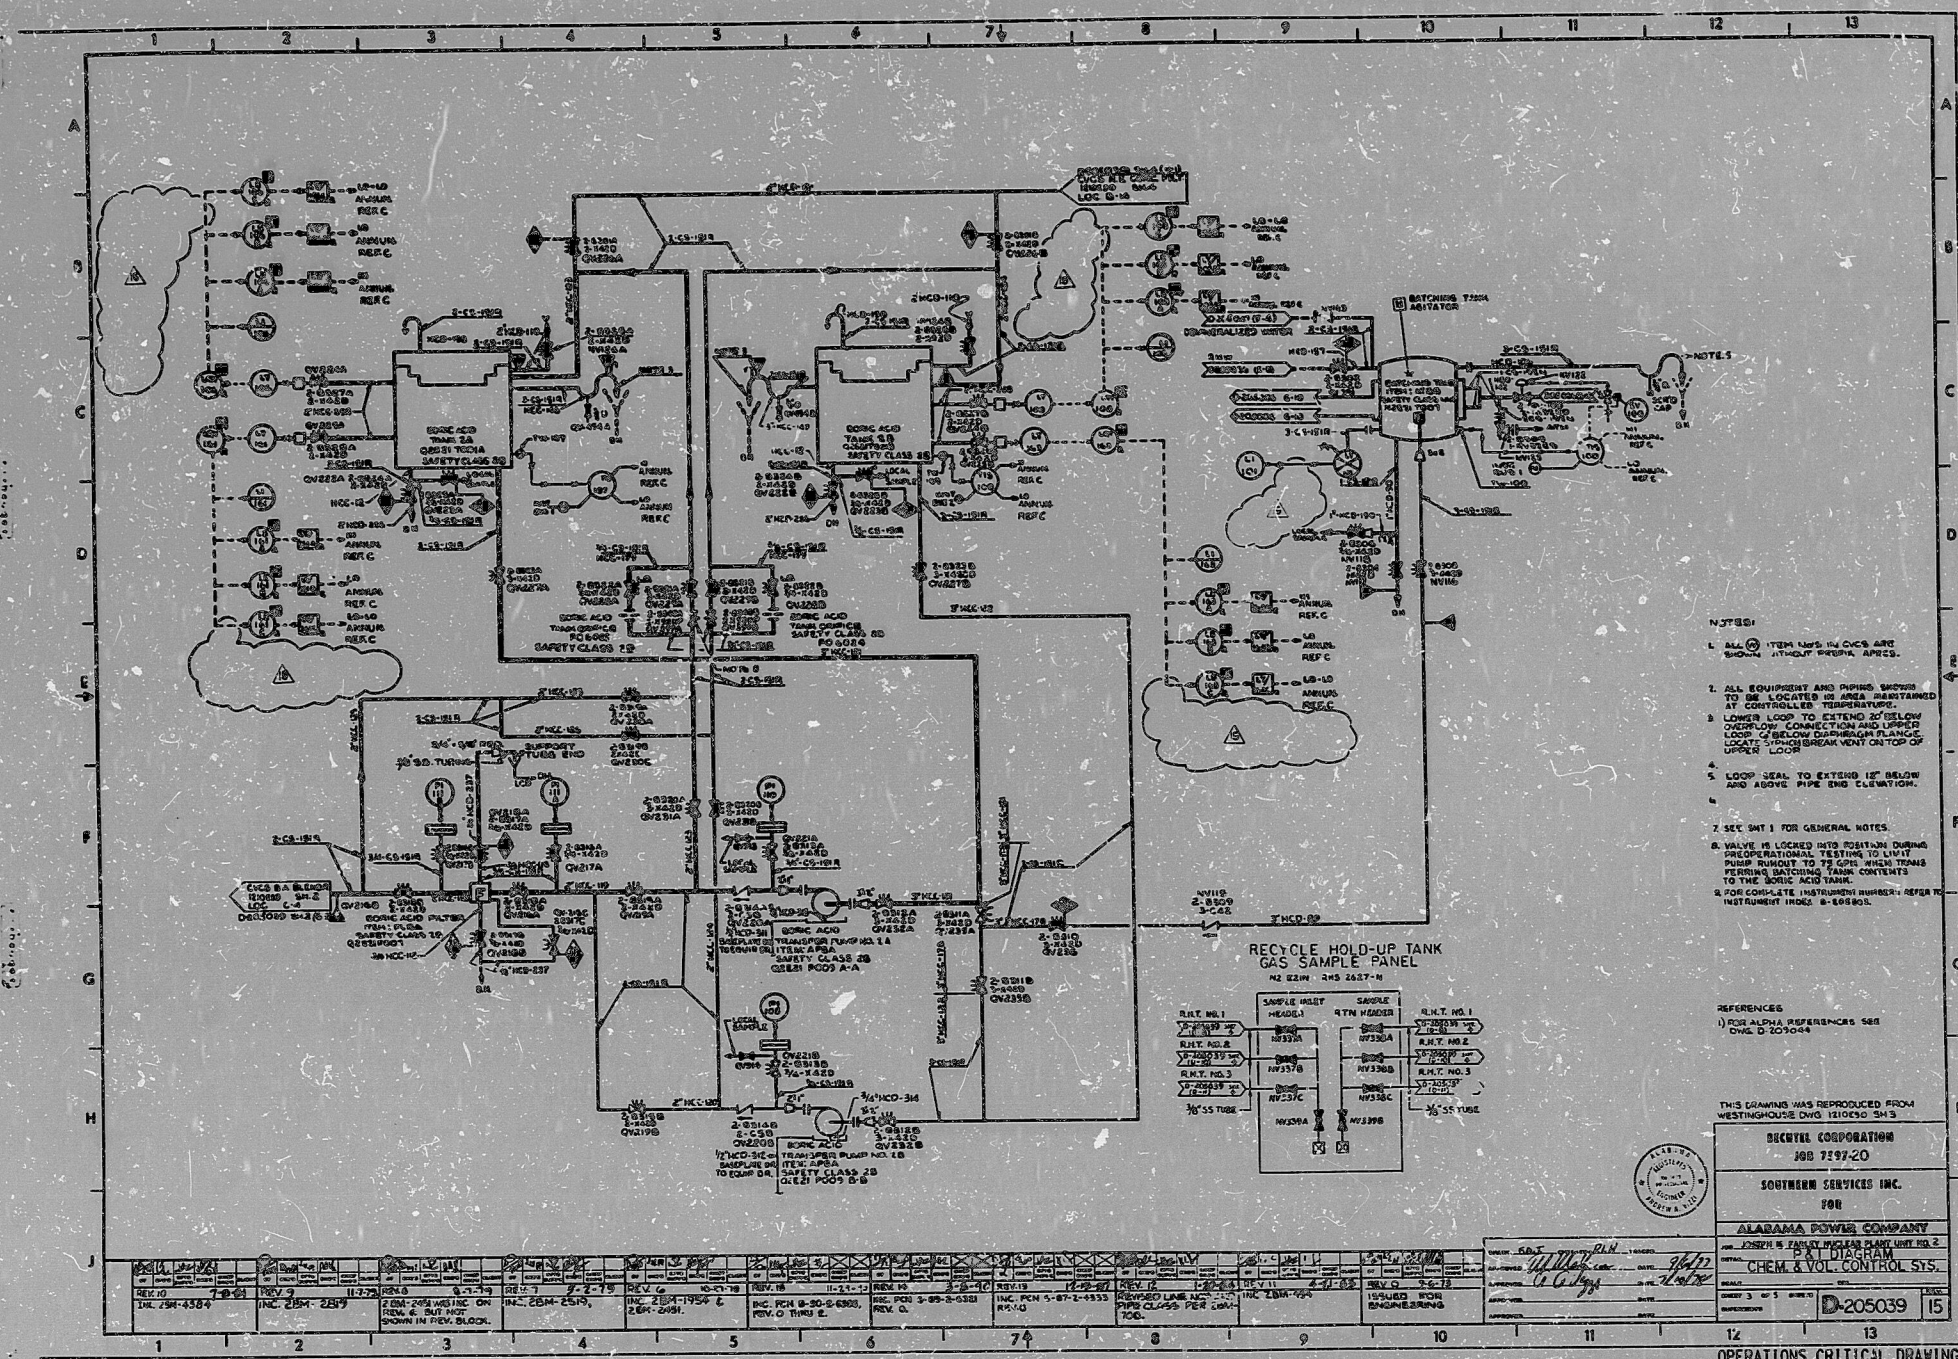

ANSTEC
APERTURE
CARD

OPERATIONS CRITICAL DRAWING

PDR RIDS

9605200490

