
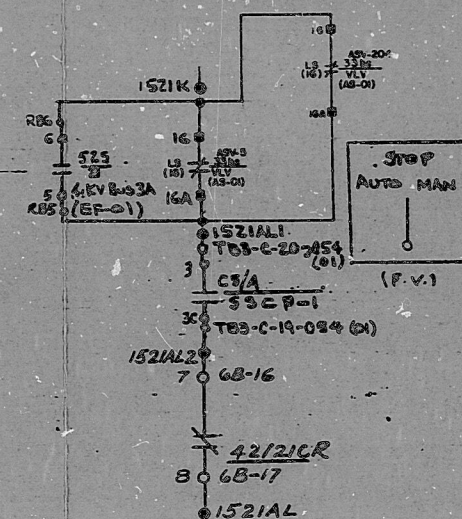
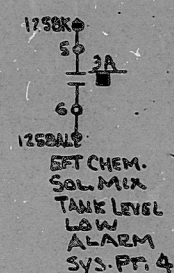


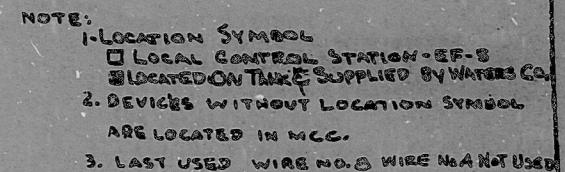

CS- SSCP-1						
CONTACTS HANDLE END			POSITIONS (REAR VIEW)			
ODD	EVEN		MAM	STDP	AERO	
10-11-12	25-11-0		X		X	
20-11-23C	45-11-0A	1	X		X	
		4	X		X	

WE TYPE 50M
MODEL NO. 10AA041
PISTOL GRIP HANDLE
MAINTAINED

TI
APERTURE
CARD

5	REVISED PER DCN 86-255	PER	
+	AS BUILT PER MAR 77-42-02		
3	AS BUILT PER MAR 77-7-112	3 EN	79
REV-2	MISCELLANEOUS CHANGES		1-1676
REV-1	AS PER F.C. 75-646		1-176
APPROVED FOR CONCEPT			

EF-12

FLORIDA POWER CORPORATION
ST. PETERSBURG, FLORIDA
CRYSTAL RIVER PLANT

ELEMENTARY DIAGRAM
E.F. CHEMICAL ADDITION PUMP (EPP-3)
WTR. TREAT M.C.C. 3B UNIT 6B

4203	B-208-0265		
WORK ORDER	SIZE	DRAWING	APP.
GILBERT ASSOCIATES, INC. ENGINEERS AND CONSULTANTS READING, PENNA.			APPROVED FOR CONSTRUCTION BY FLORIDA POWER CORPORATION
DRAFTING	ENGINEER APPROV.		
MADE BY PKL	DATE 7-26-59	BY 1-10-59	ALG
REVISION	DATE	BY	REASON

8703190328

PDR RIDS

