


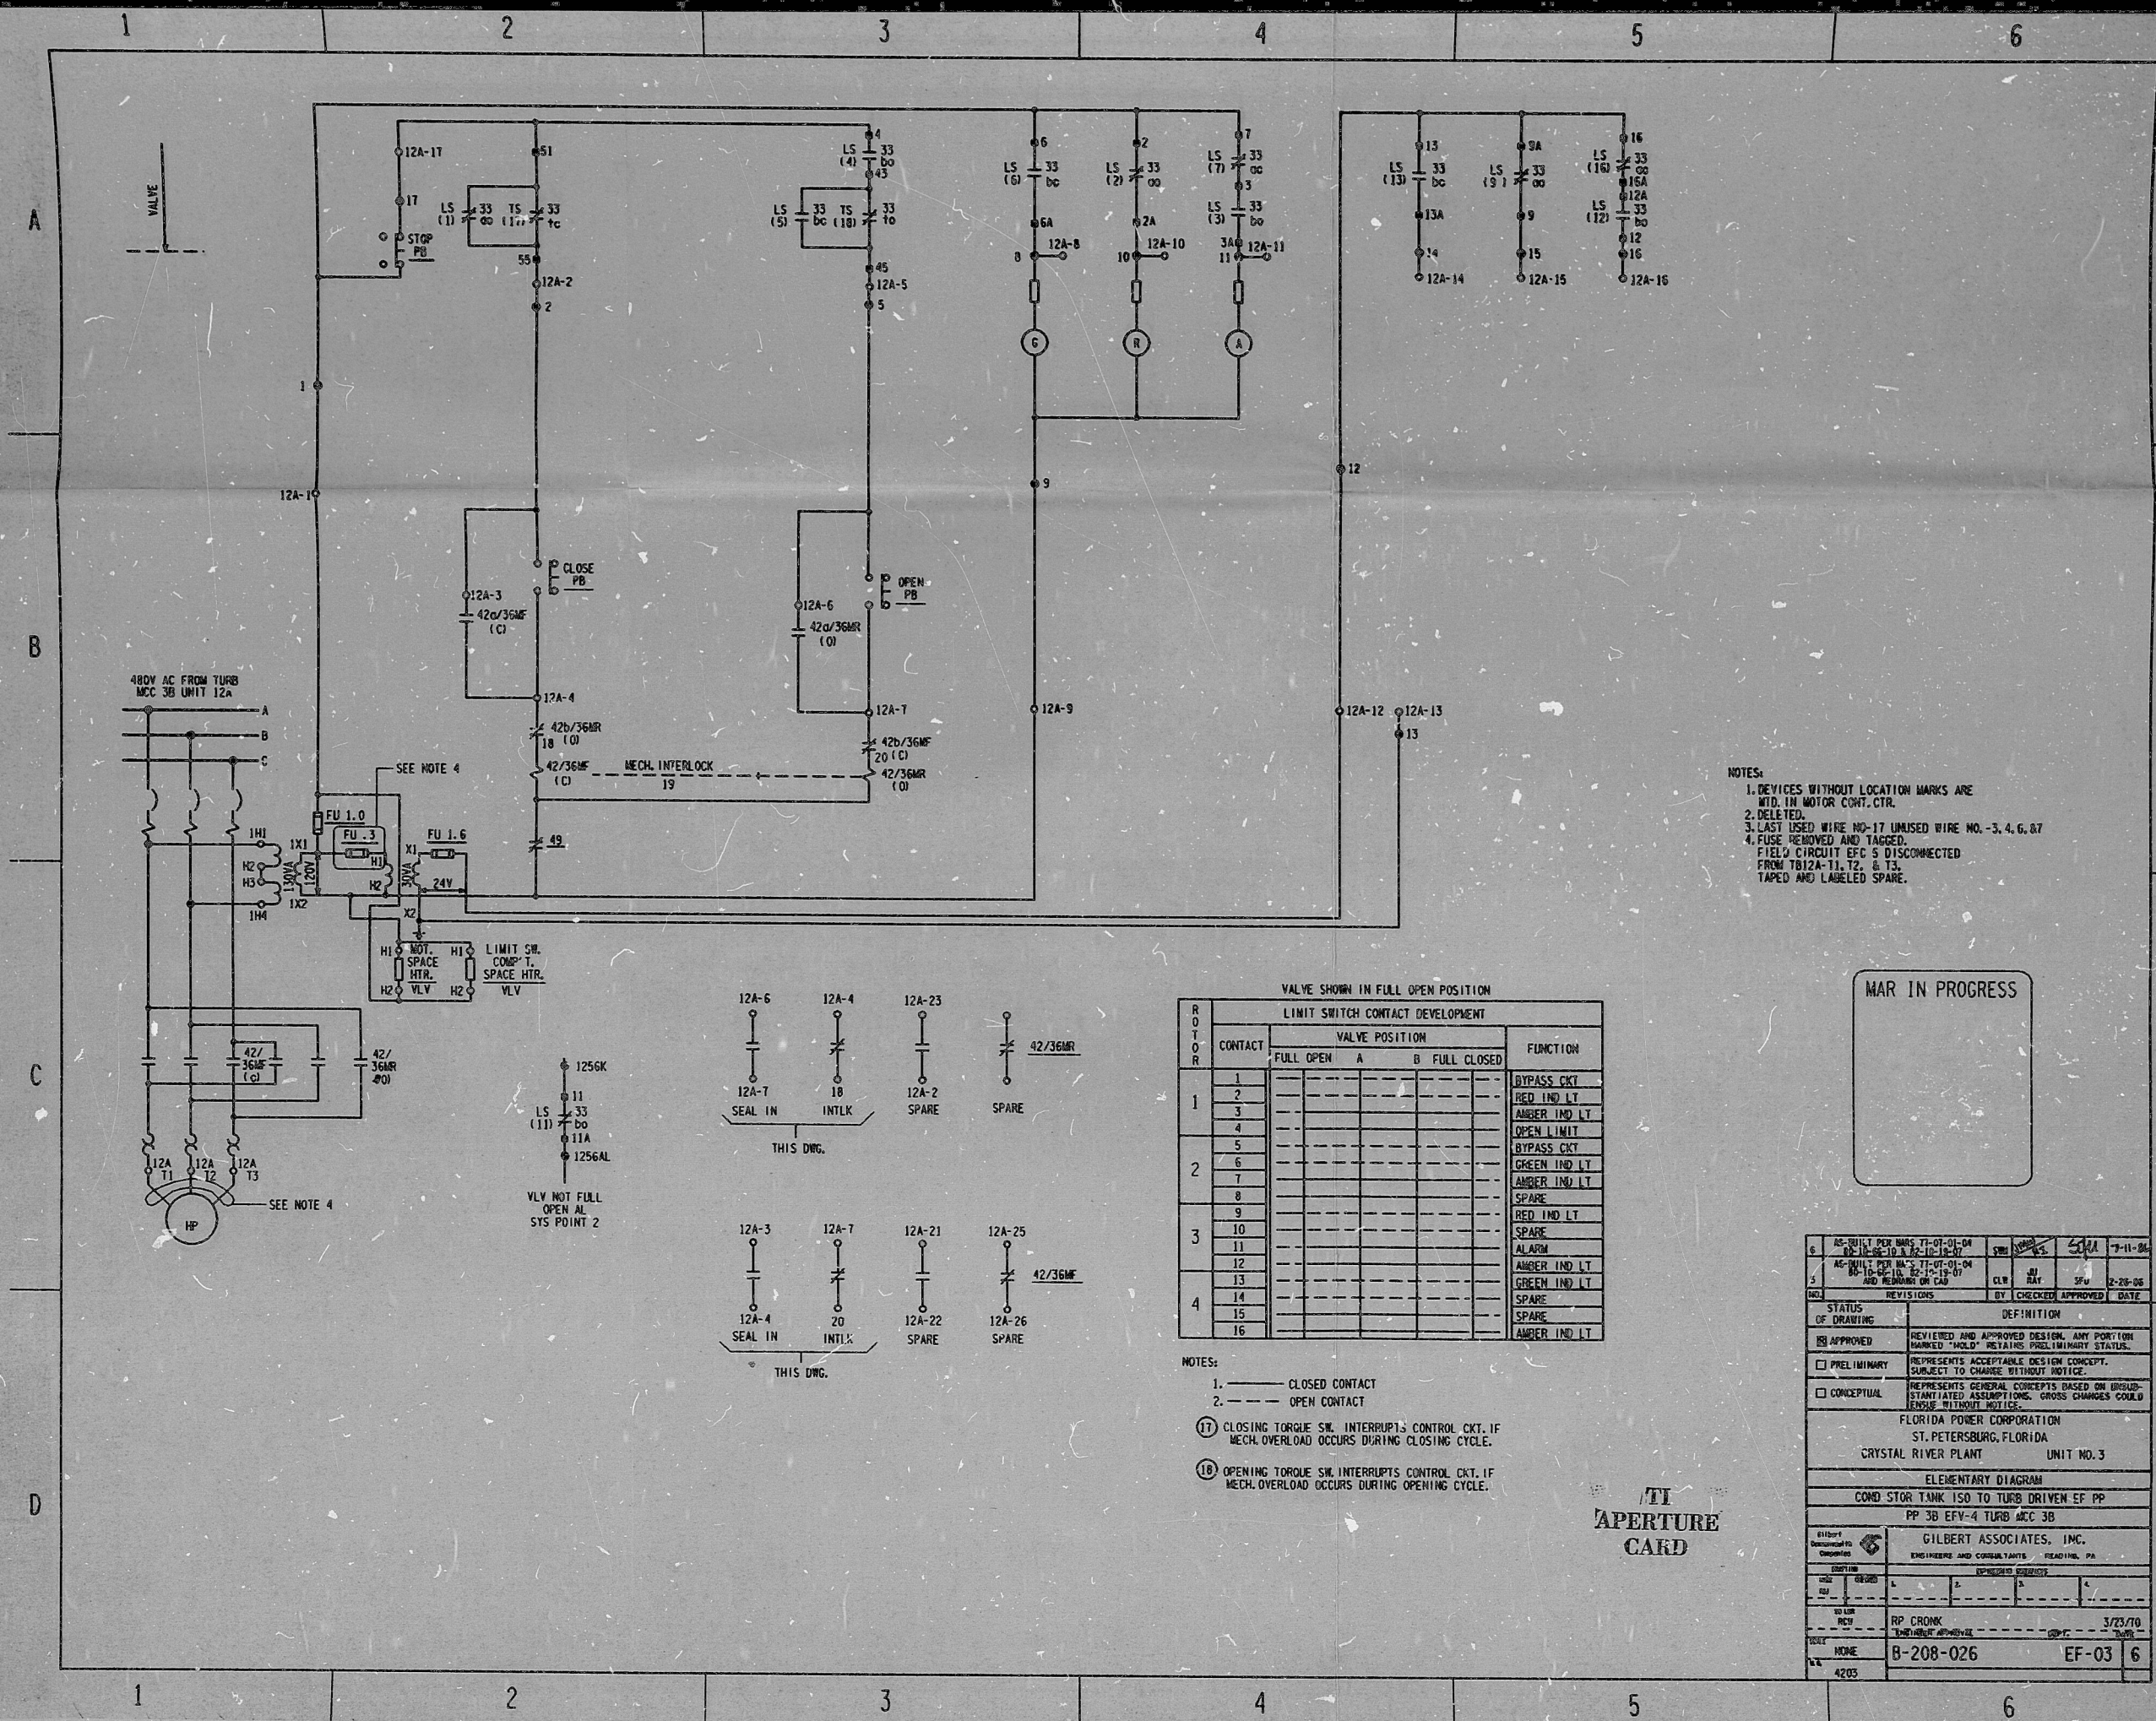

- NOTES:
- 1. DEVICES WITHOUT LOCATION MARKS ARE WITH IN MOTOR CONT. CTR.
 - 2. DELETED.
 - 3. LAST USED WIRE NO-17 UNUSED WIRE NO.-3, 4, 6, 8, 7
 - 4. FUSE REMOVED AND TAGGED.
 - 5. FIELD CIRCUIT EFC 5 DISCONNECTED FROM T812A-11, T2, & T3.
 - 6. TAPED AND LABELED SPARE.

MAR IN PROGRESS

VALVE SHOWN IN FULL OPEN POSITION					
LIMIT SWITCH CONTACT DEVELOPMENT					
ROW	CONTACT	VALVE POSITION			FUNCTION
		FULL OPEN	A	B FULL CLOSED	
1	1				BYPASS CKT
	2				RED IND LT
	3				AMBER IND LT
	4				OPEN LIMIT
	5				BYPASS CKT
2	6				GREEN IND LT
	7				AMBER IND LT
	8				AMBER IND LT
	9				SPARE
	10				RED IND LT
3	11				SPARE
	12				ALARM
	13				AMBER IND LT
	14				GREEN IND LT
	15				SPARE
4	16				SPARE
	17				AMBER IND LT

- NOTES:
- 1. ——— CLOSED CONTACT
 - 2. - - - - - OPEN CONTACT
 - (17) CLOSING TORQUE SW. INTERRUPTS CONTROL CKT. IF MECH. OVERLOAD OCCURS DURING CLOSING CYCLE.
 - (18) OPENING TORQUE SW. INTERRUPTS CONTROL CKT. IF MECH. OVERLOAD OCCURS DURING OPENING CYCLE.

TI
APERTURE
CARD

6	AS-BUILT PER MARS T1-01-01-04 RE-12-02-10 A RE-12-12-07	5/11/86	7-11-86
5	AS-BUILT PER MARS T1-01-01-04 RE-12-02-10 A RE-12-12-07 AND REWORK ON CAD	2-20-86	
4	STATUS OF DRAWING	DEFINITION	
3	APPROVED	REVIEWED AND APPROVED DESIGN. ANY PORTION MARKED "HOLD" REMAINS PRELIMINARY STATUS.	
2	PRELIMINARY	REPRESENTS ACCEPTABLE DESIGN CONCEPT. SUBJECT TO CHANGE WITHOUT NOTICE.	
1	CONCEPTUAL	REPRESENTS GENERAL CONCEPTS BASED ON UNSUBSTANTIATED ASSUMPTIONS. GROSS CHANGES COULD REQUIRE REWORK NOTICES.	
FLORIDA POWER CORPORATION ST. PETERSBURG, FLORIDA CRYSTAL RIVER PLANT UNIT NO. 3			
ELEMENTARY DIAGRAM			
COND. STOR. TANK ISO TO TURB. DRIVEN EF PP			
PP 3B EFV-4 TURB. ACC 3B			
GILBERT ASSOCIATES, INC. ENGINEERS AND CONSULTANTS - READING, PA.			
8703190393

PDR RIDS

