


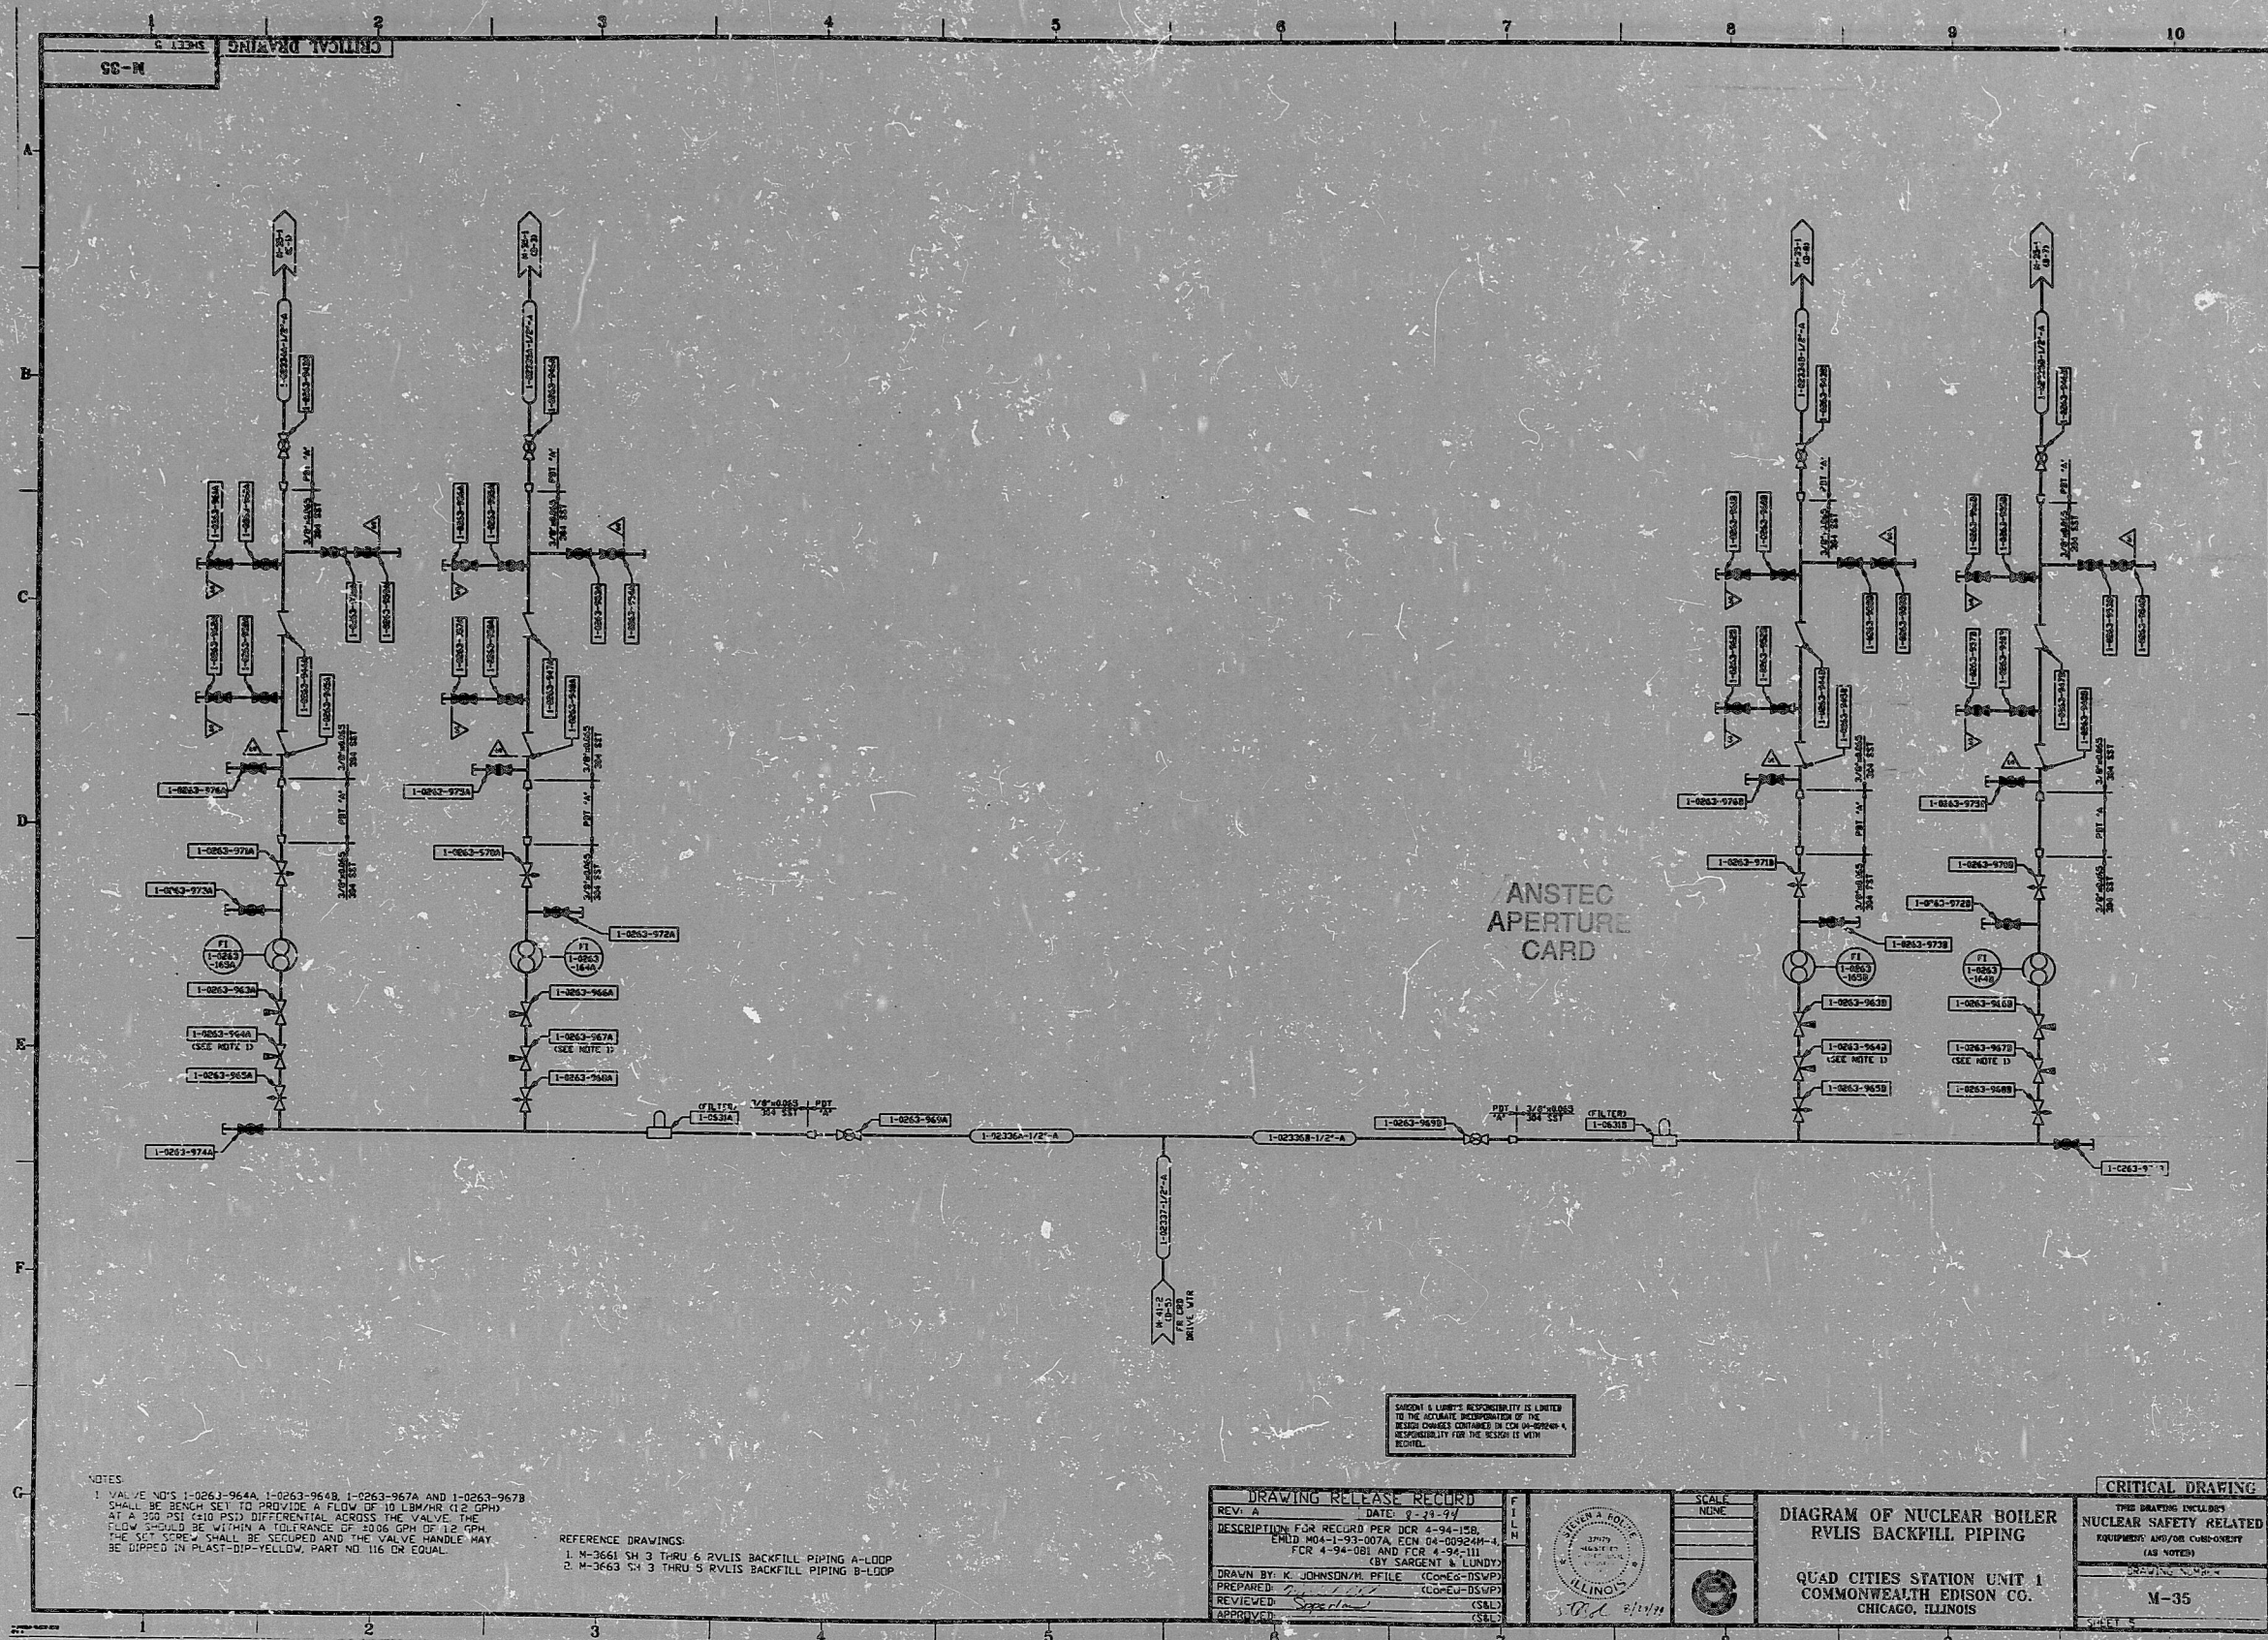

NOTES

REFERENCE DRAWINGS
1. W-3661 ON 3 THRU 6 RVLS BACKFILL PIPING A-LOOP
2. W-3663 ON 3 THRU 5 RVLS BACKFILL PIPING B-LOOP

SAFETY & LUMPS RESPONSIBILITY IS LIMITED TO THE ACTUAL REPRESENTATION OF THE DESIGN CHANGES CONTAINED IN THIS DRAWING. RESPONSIBILITY FOR THE DESIGN IS WITH ECHILL.

DRAWING RELEASE RECORD	
DESCRIPTION FOR RECORD PER DCR 4-94-150, ENCL 104-1-93-007A, ECH 04-00924M-4, FOR 4-94-001 AND FOR 4-94-111 (BY SARGENT & LUNDY)	
DRAWN BY: K. JOHNSON/P. FILE	(CONCERN-BSVP)
PREPARED BY: [Signature]	(CONCERN-BSVP)
REVIEWED BY: [Signature]	(SAE)
APPROVED BY: [Signature]	(SAE)



SCALE: NONE
DIAGRAM OF NUCLEAR BOILER RVLS BACKFILL PIPING
QUAD CITIES STATION UNIT 1
COMMONWEALTH EDISON CO.
CHICAGO, ILLINOIS

CRITICAL DRAWING	
THIS DRAWING INCLUDES NUCLEAR SAFETY RELATED EQUIPMENT AND/OR CONSTRUCTION (SEE NOTES)	
DRAWING NO. M-35	

FOR REFERENCE
VOID AFTER
30 MAY 11 PM 6:20

CENTRAL DRAWING FACILITY

30 X

PDR RIDS

9505150280

