




PDR RIDS

9505190266

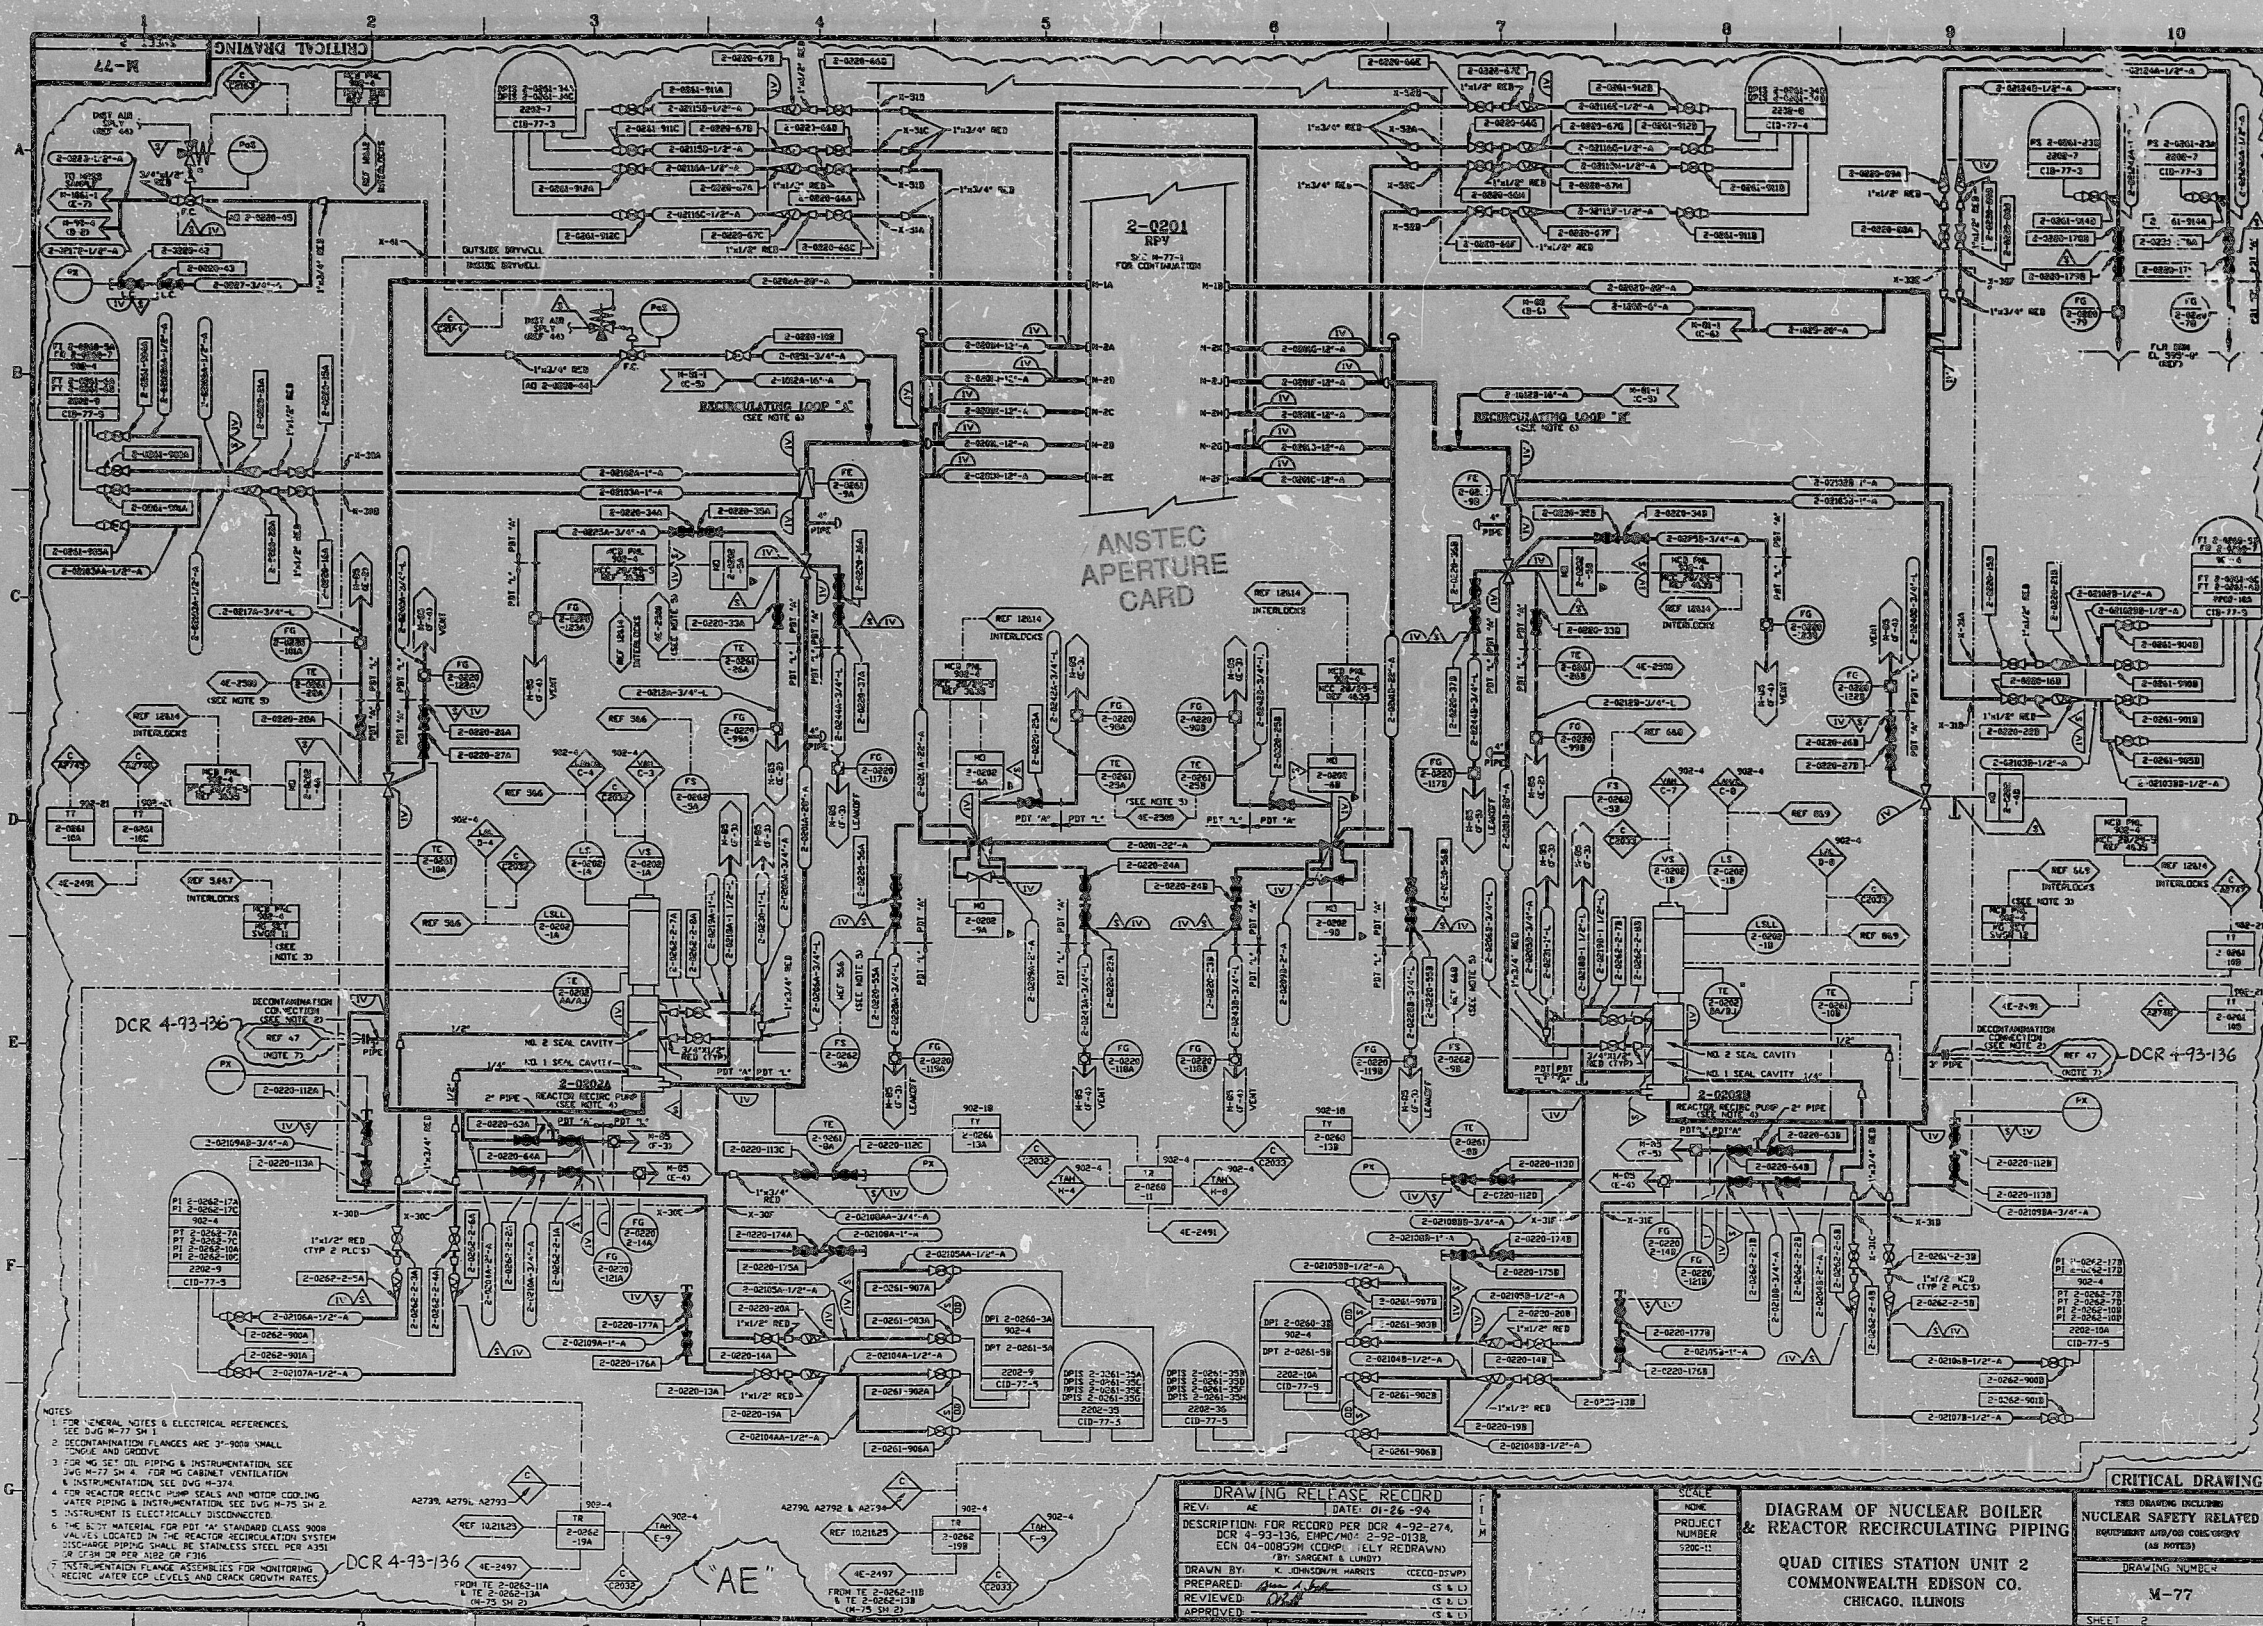