


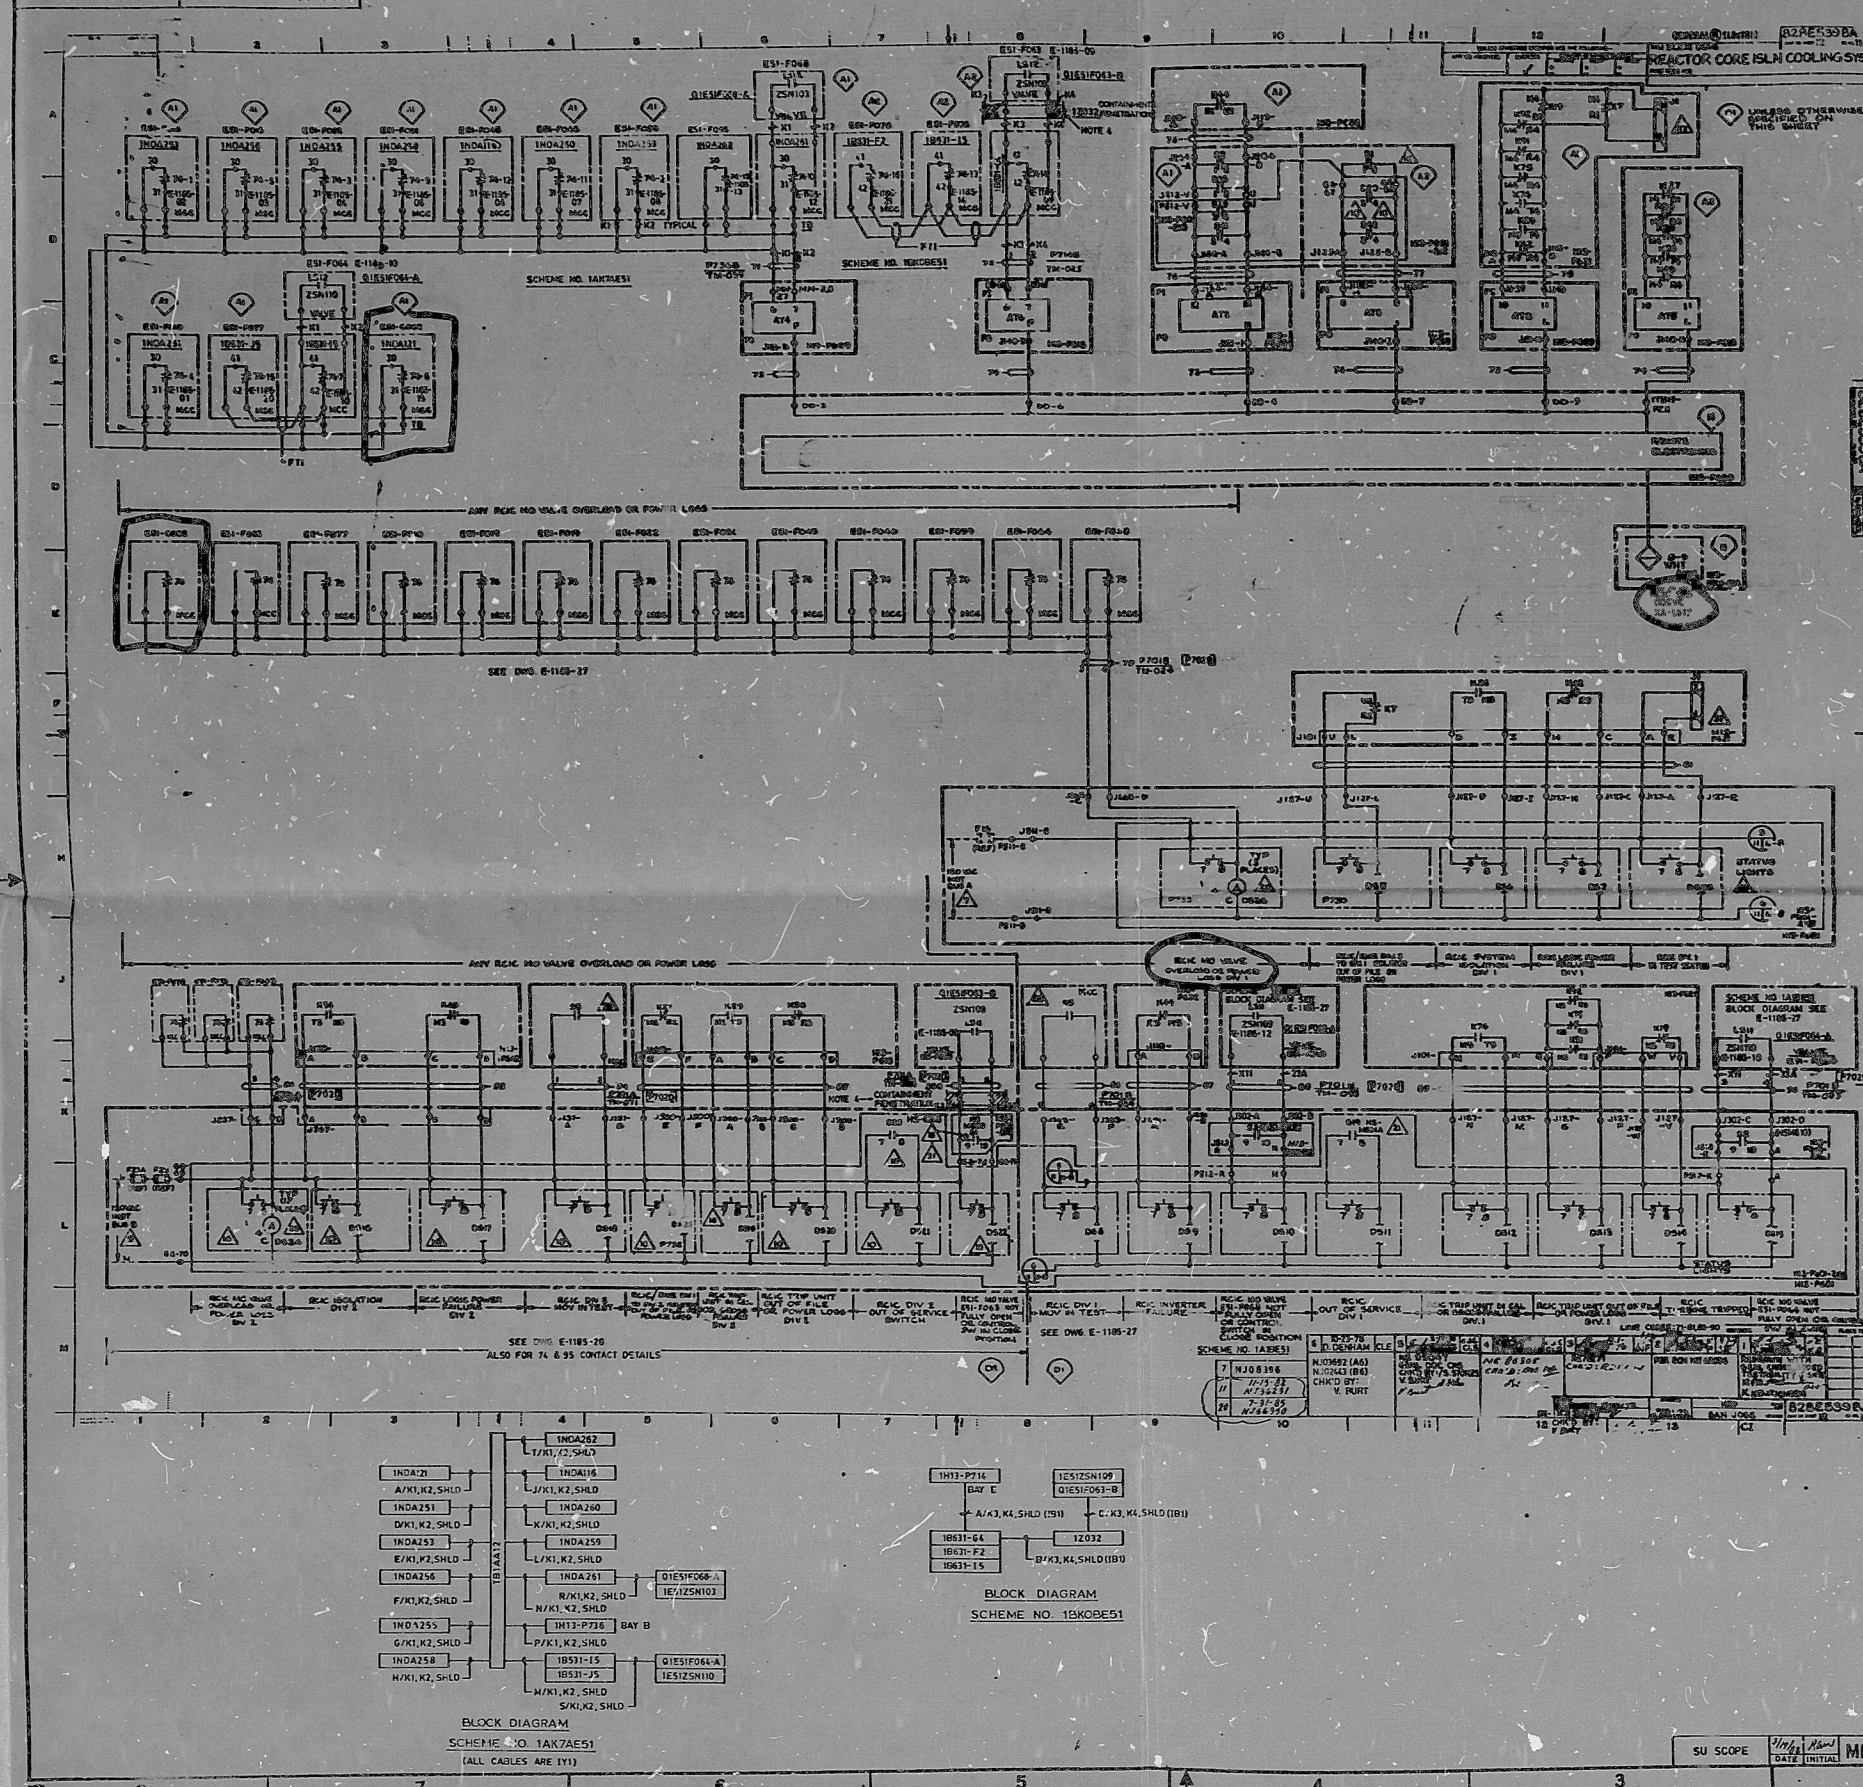

REVISION	DATE	BY	CHKD	APPD
1	9-21-79	MRT		
2	10-1-79	LCM		

BECHTEL	
GAINESBURG, MARYLAND	
MISSISSIPPI POWER & LIGHT COMPANY	
SCHEMATIC DIAGRAM	
ESI REACTOR CORE ISLN COOLING SYSTEM	
DIVISION I & II ANNUNCIATORS	
UNIT 1	
JOB NO.	DRAWING NO.
9645	E-1185-41
REV.	6

8703240307

PDR RIDS

8703240307

