


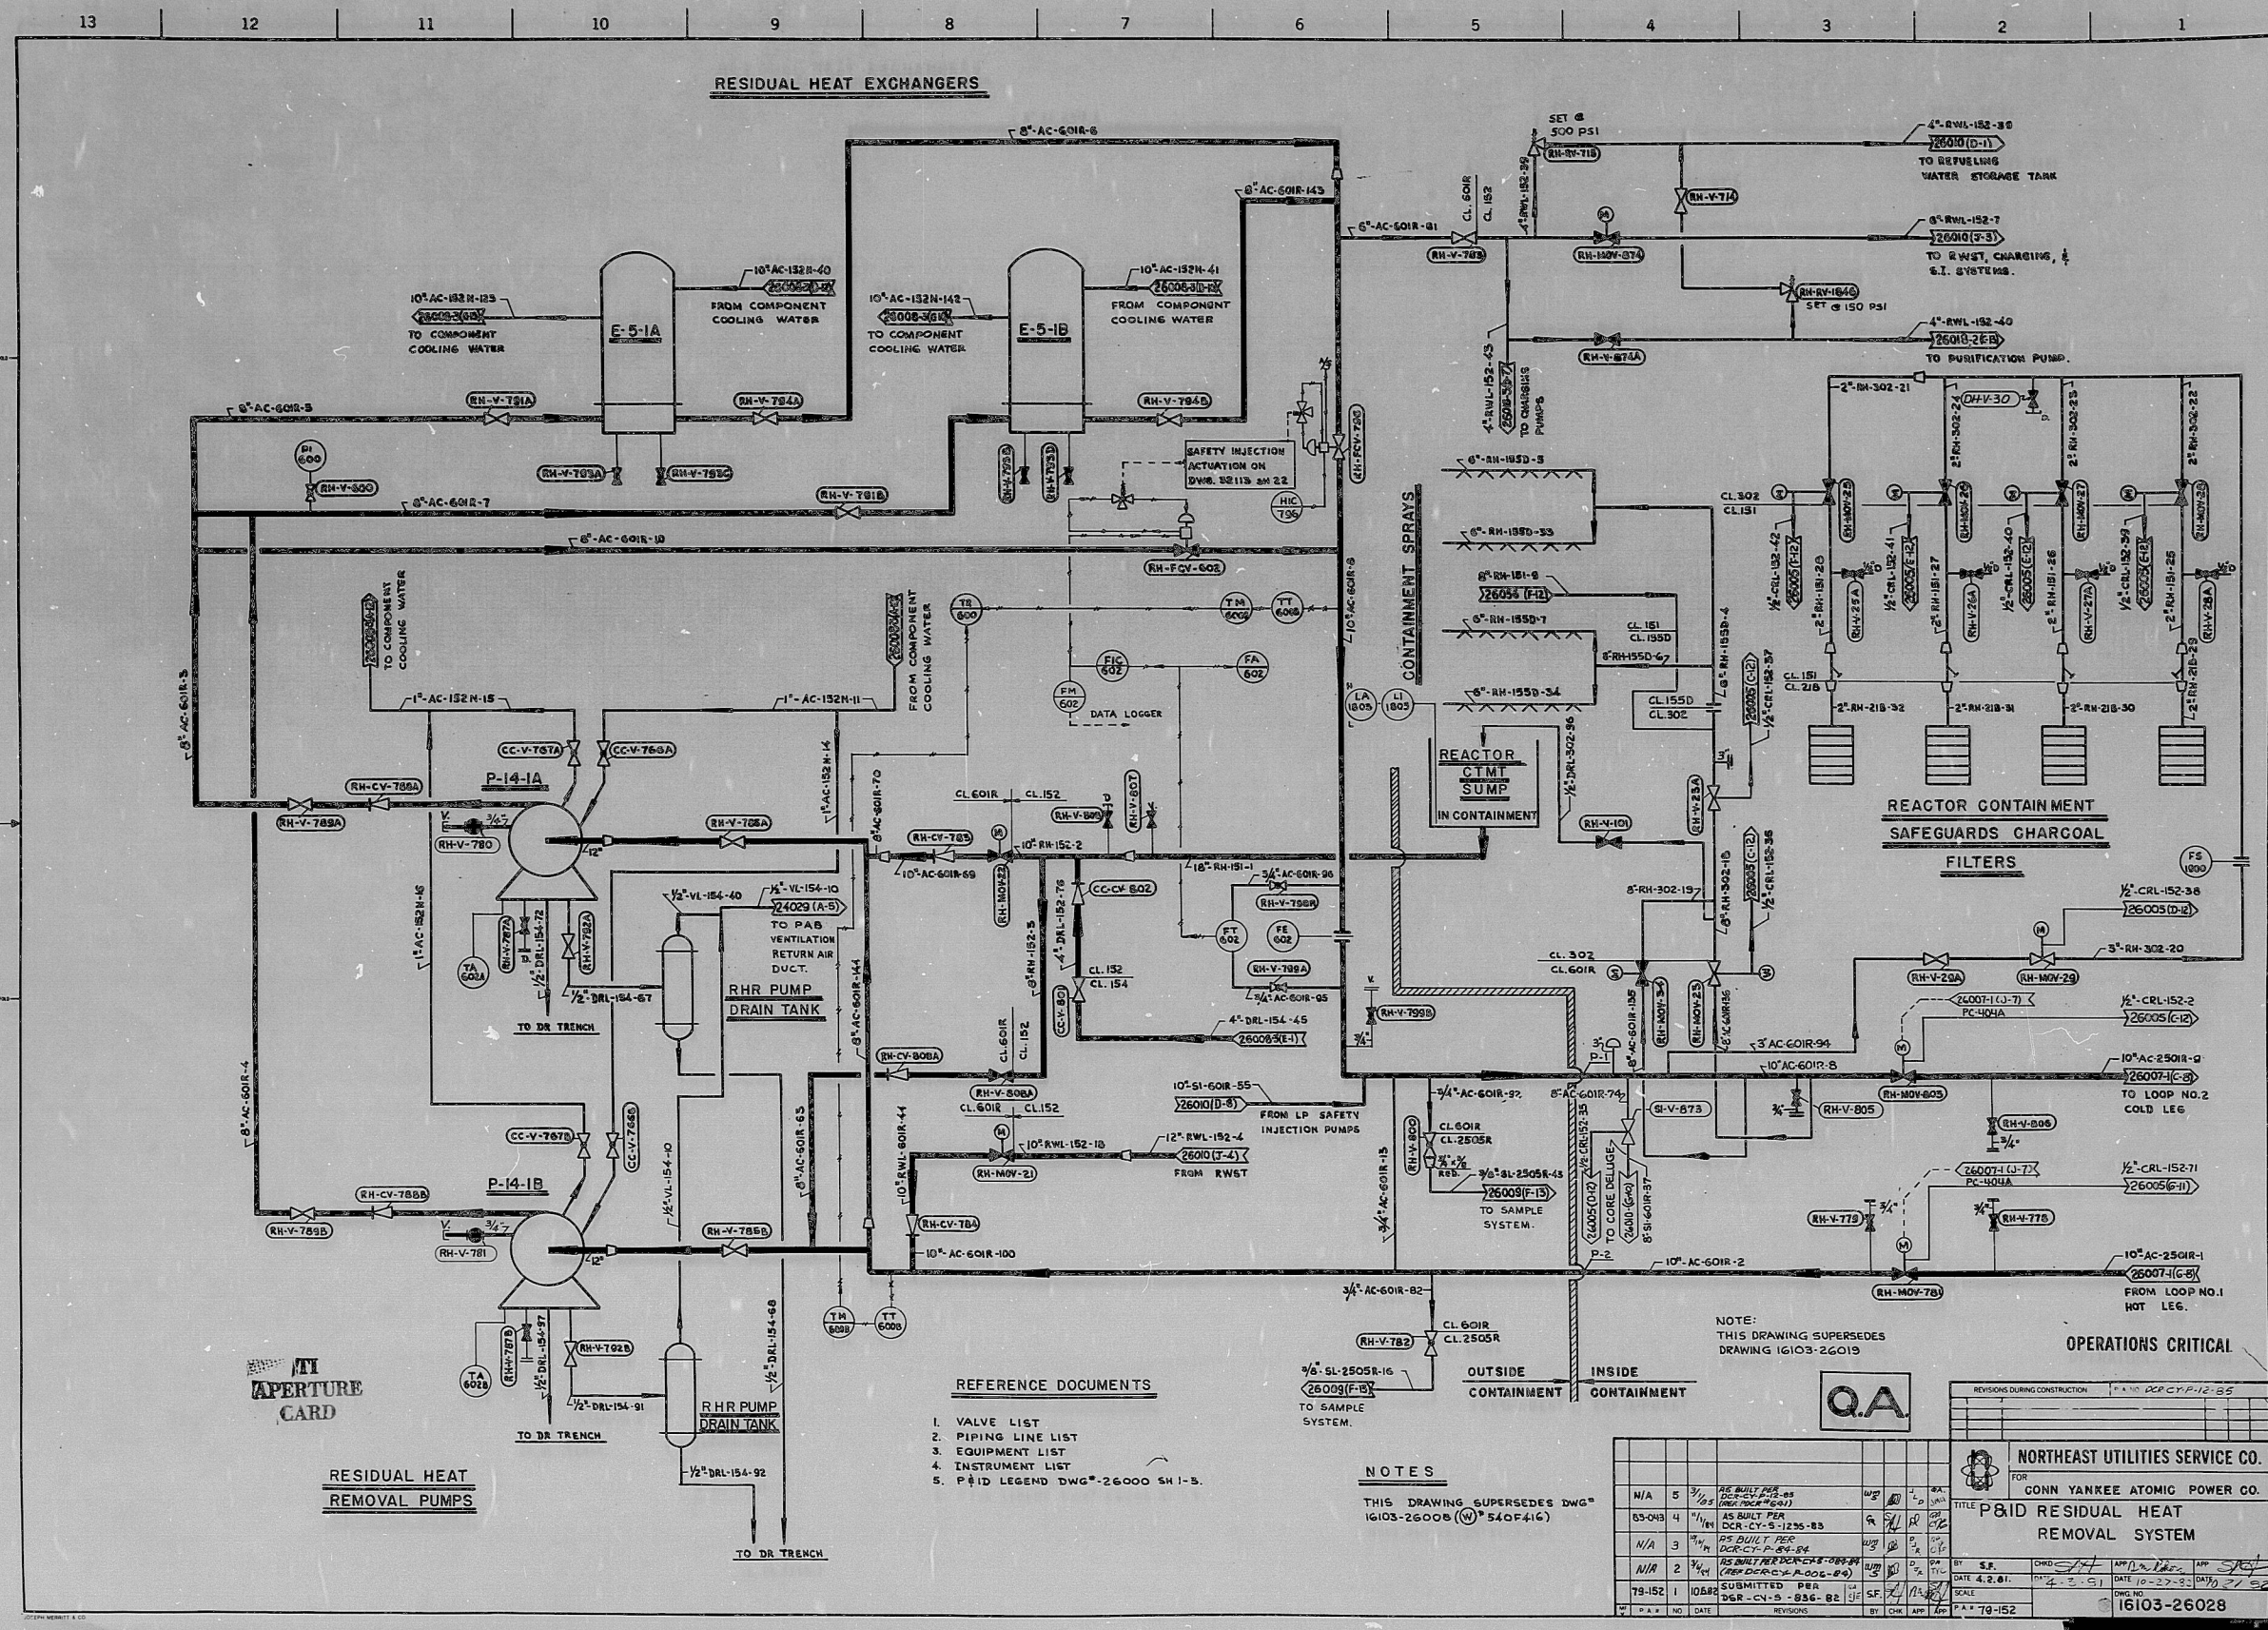

86Q7230253

PDR RIDS

