


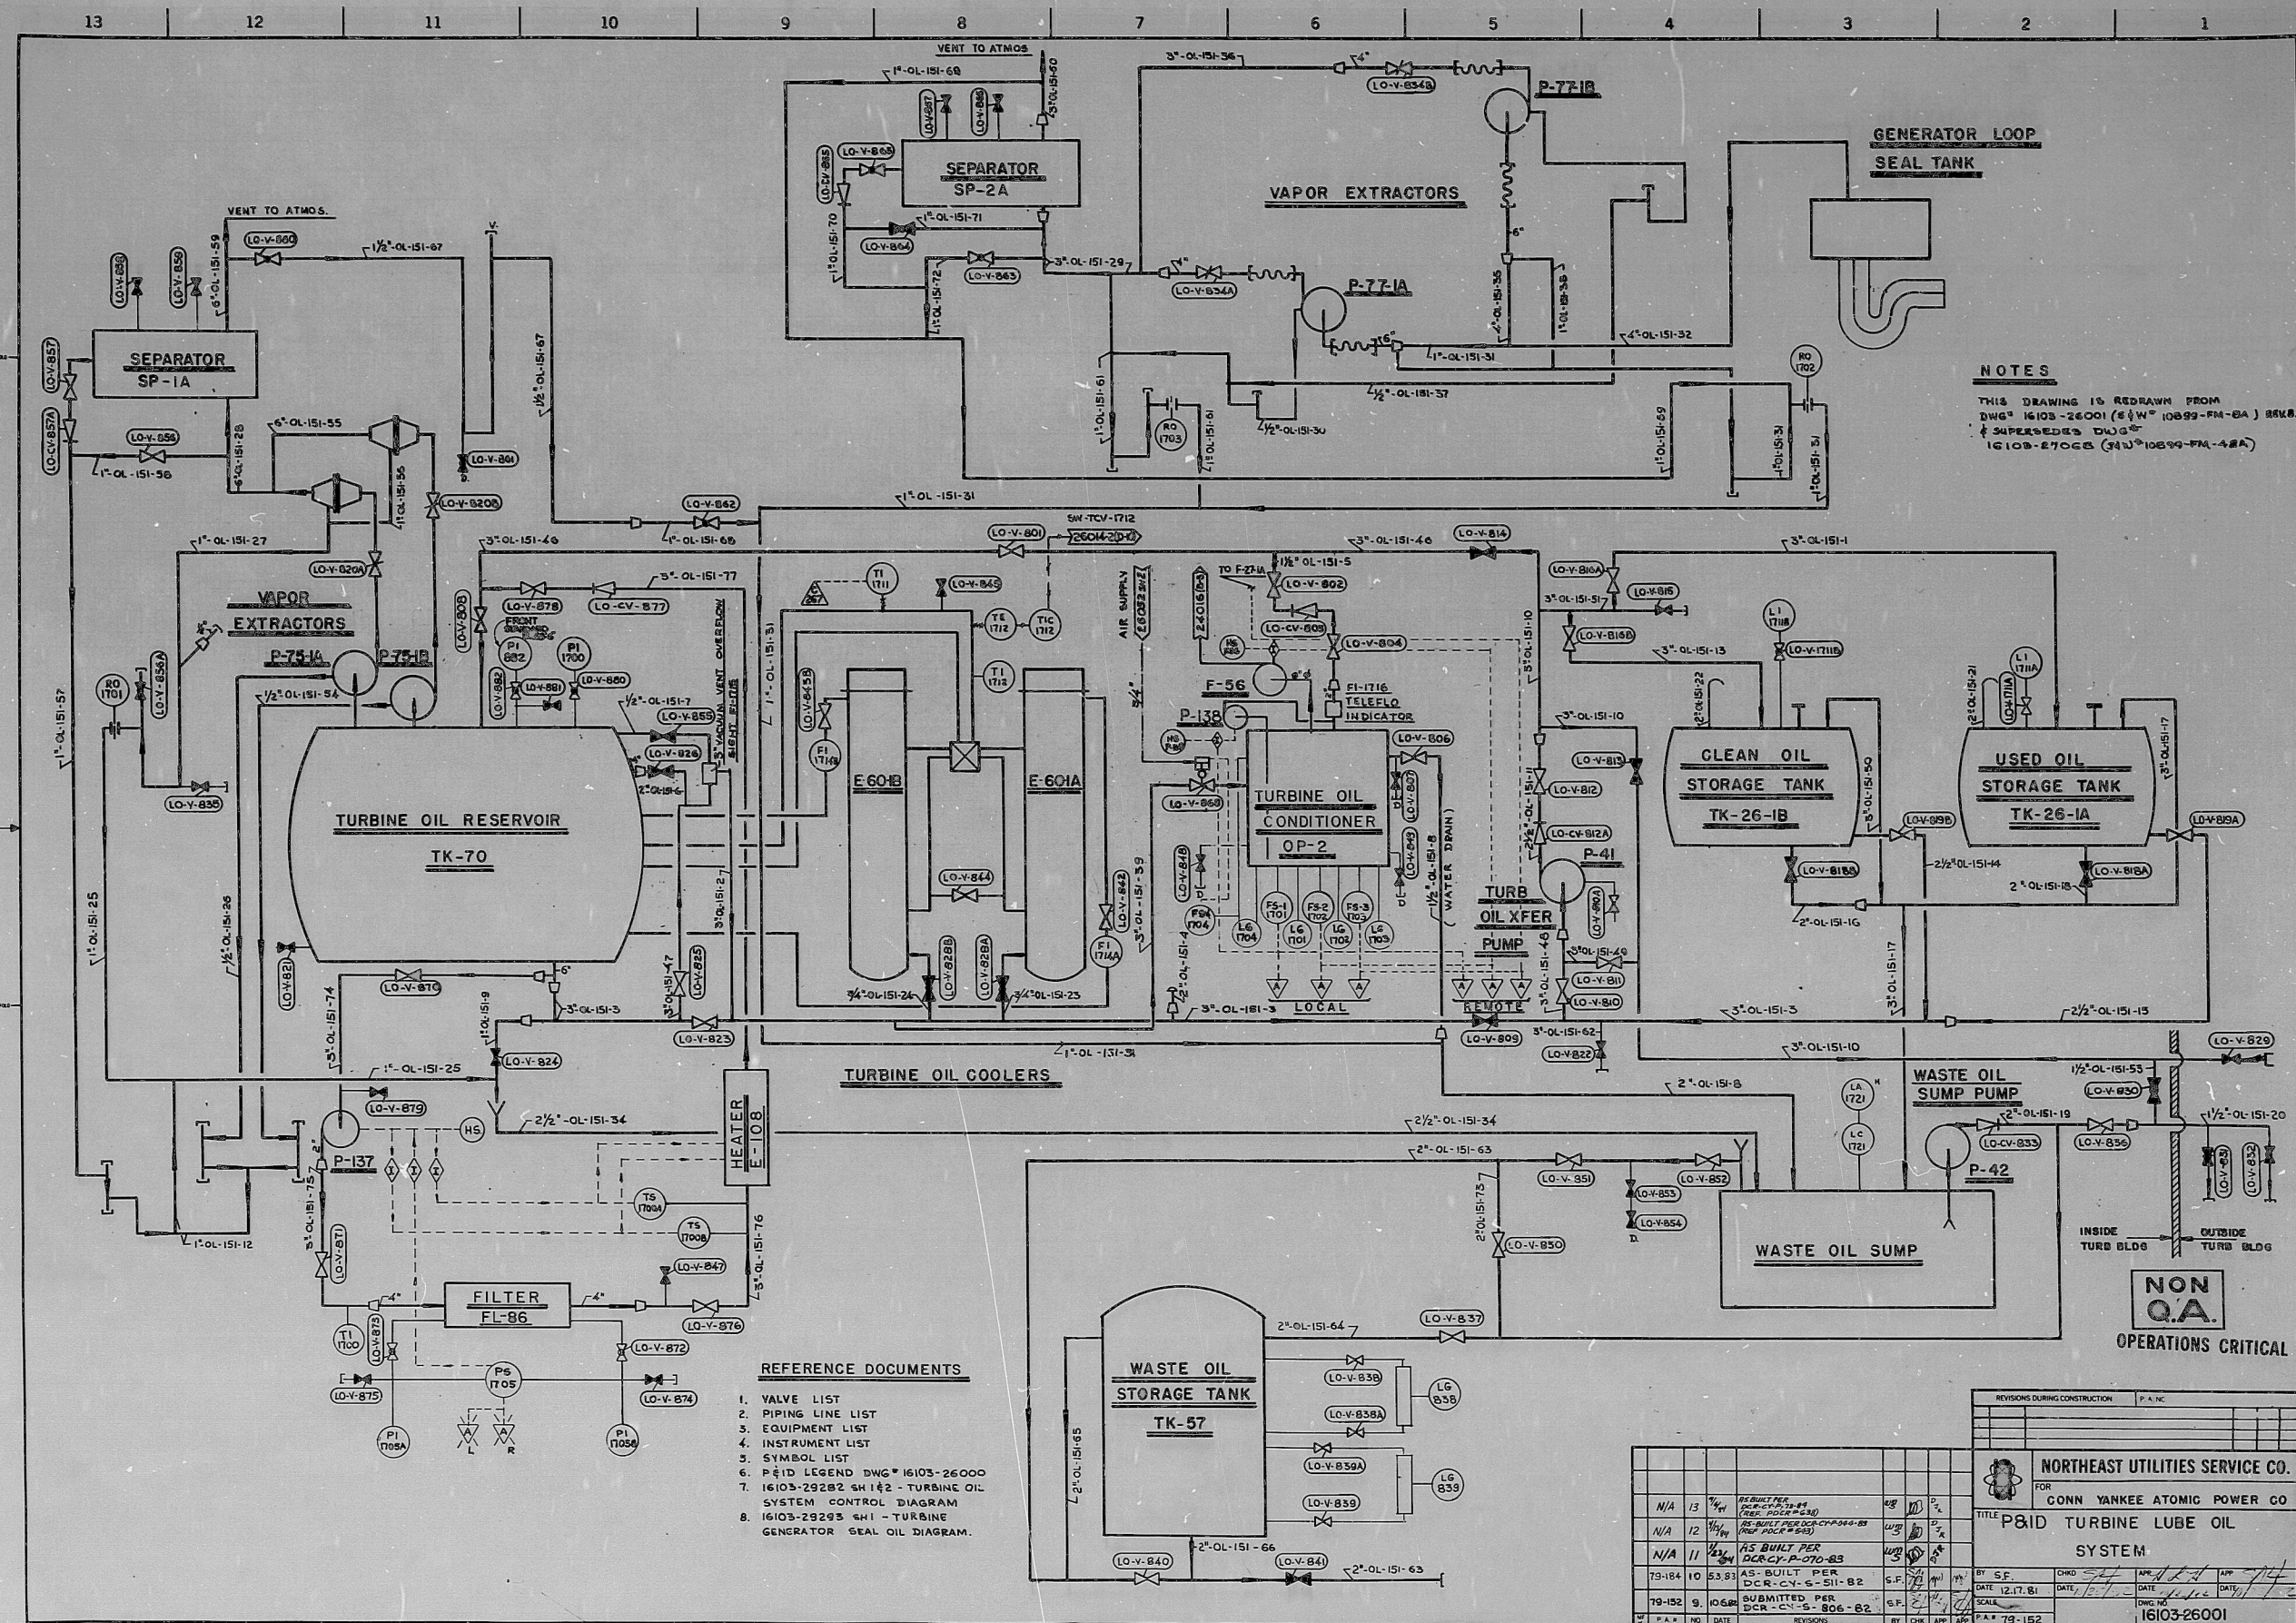

8607230321

PDR RIDS

