


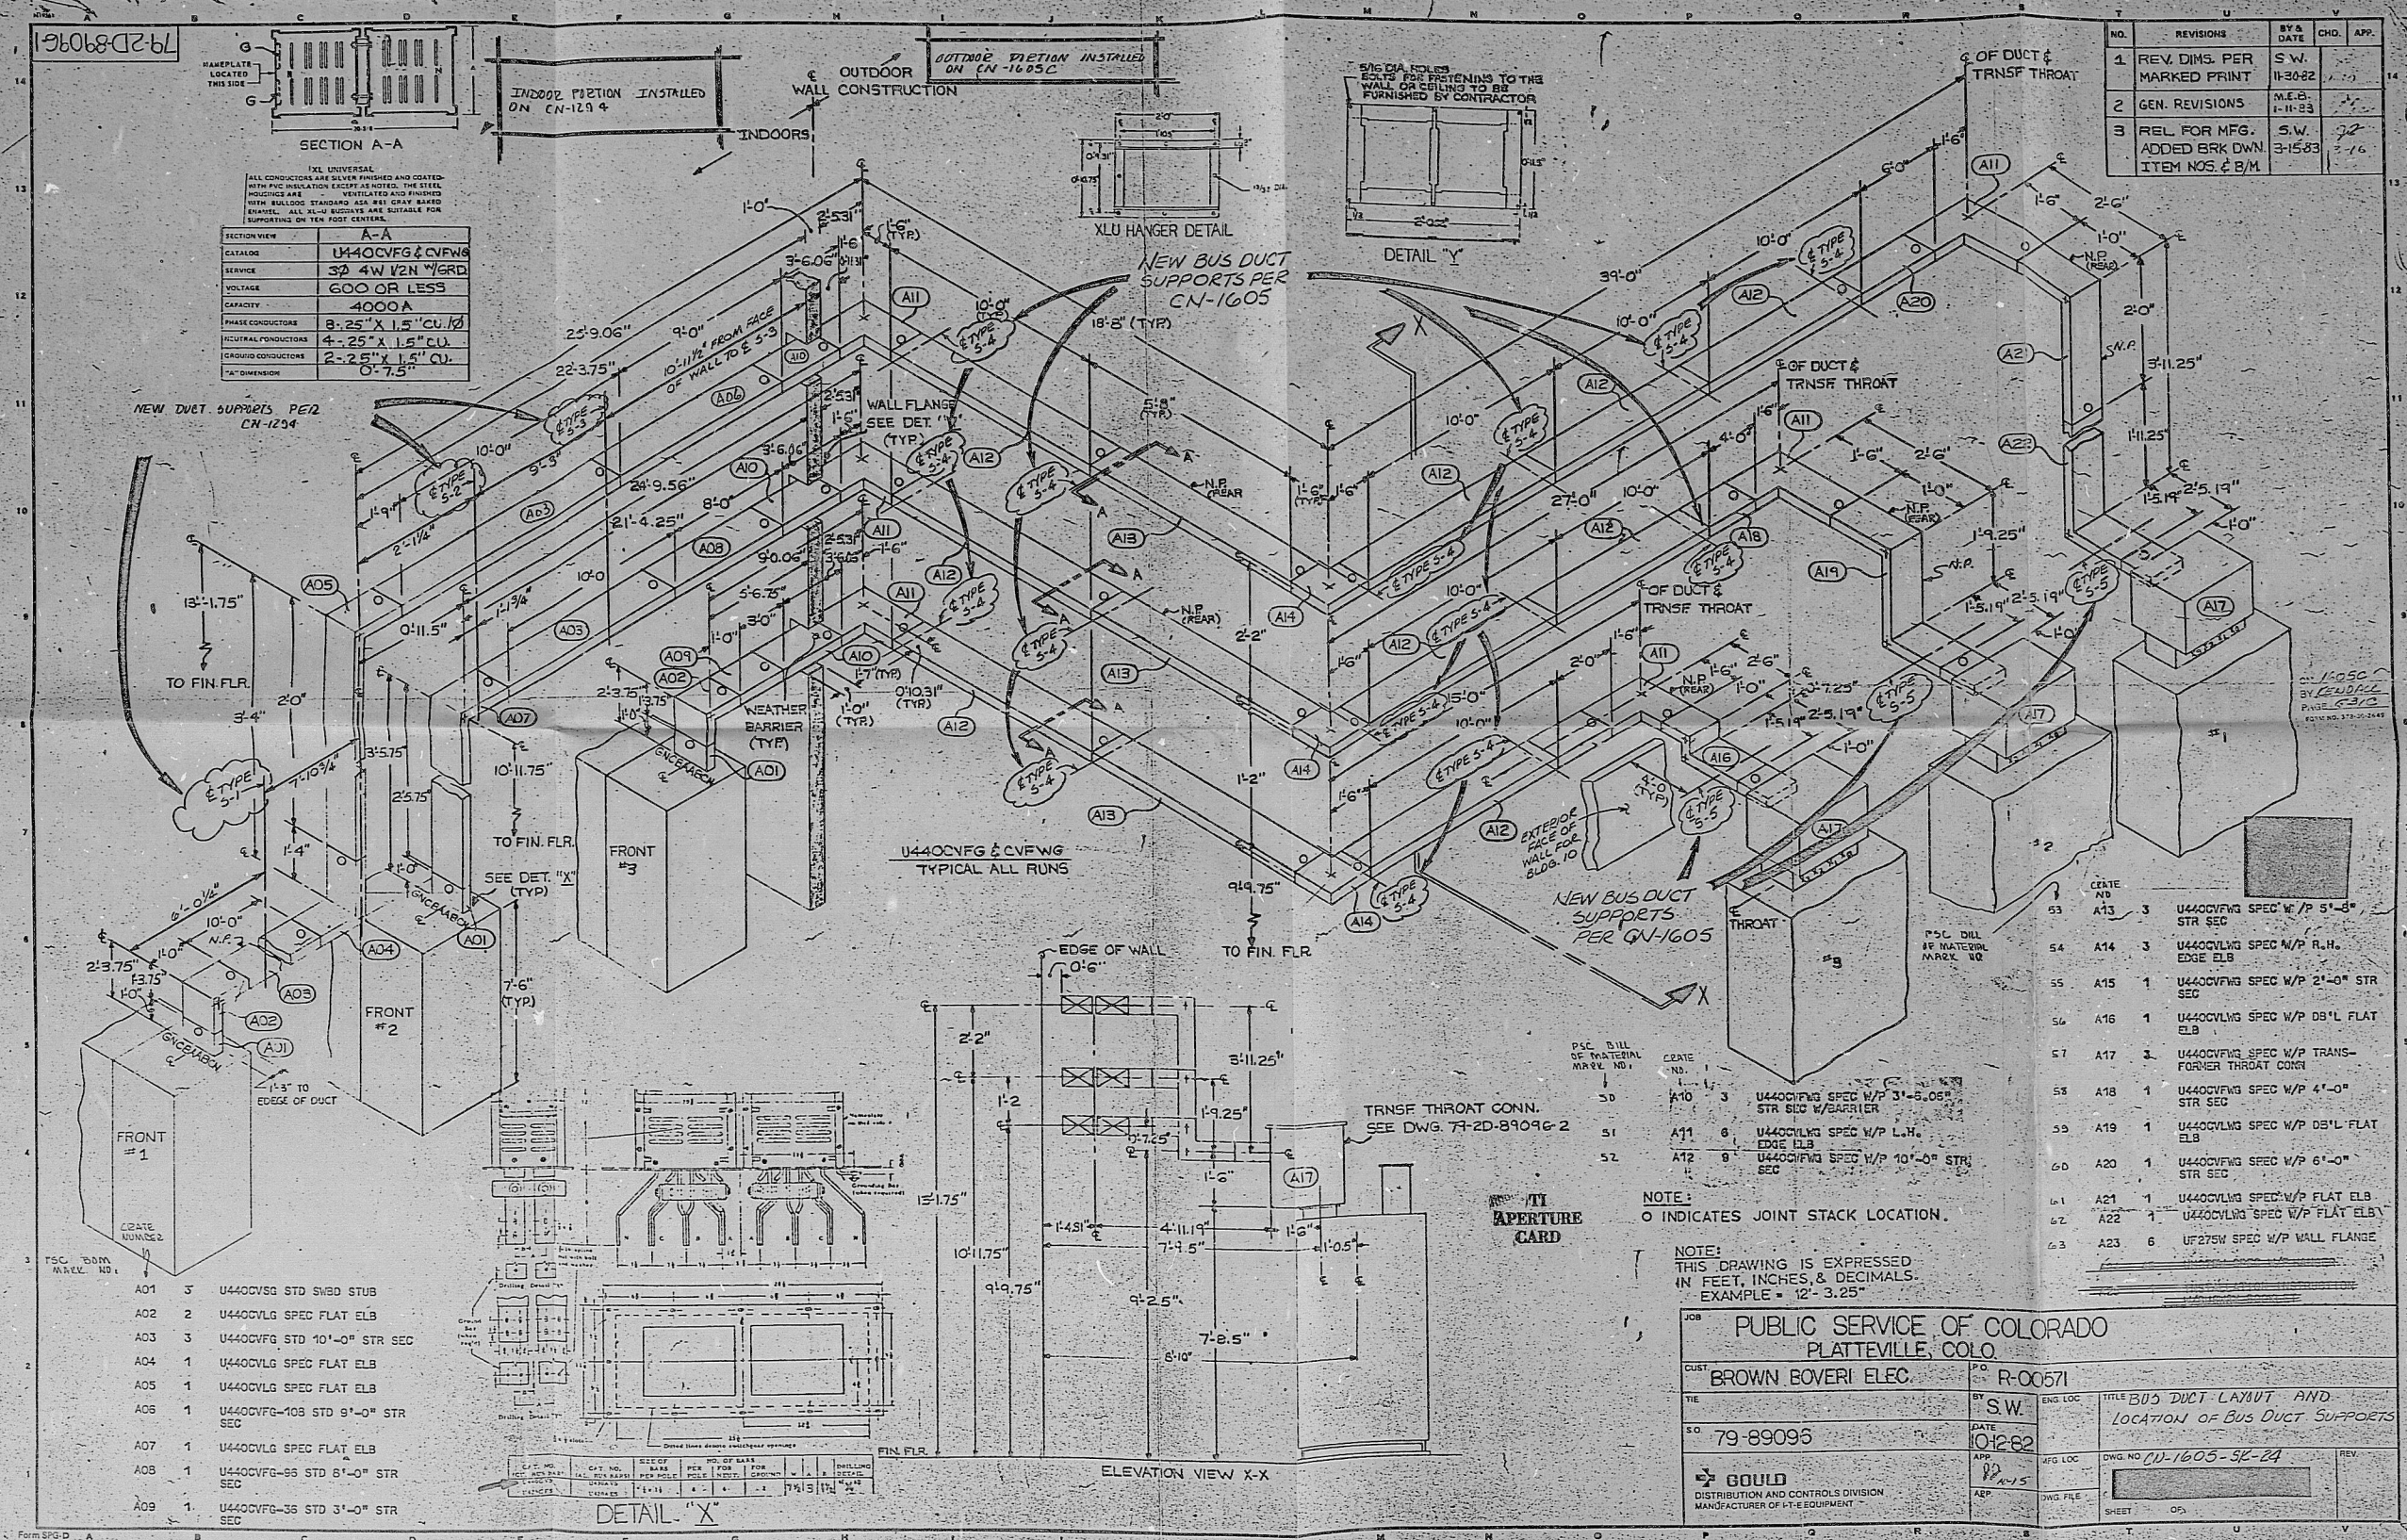

NO.	REVISIONS	BY & DATE	CHK.	APP.
1	REV. DIMS. PER MARKED PRINT	S.W. 11-30-62		
2	GEN. REVISIONS	M.E.B. 1-11-63		
3	REL. FOR MFG. ADDED BRK DWN ITEM NOS. & B.Y.M.	S.W. 3-15-63		

SECTION VIEW A-A	
CATALOG	U440CVFG & CVFWG
SERVICE	3Ø 4W V2N WGRD
VOLTAGE	600 OR LESS
CAPACITY	4000A
PHASE CONDUCTORS	8-25" X 1.5" CU/AL
NEUTRAL CONDUCTORS	4-25" X 1.5" CU
GROUNDING CONDUCTORS	2-25" X 1.5" CU
TRAILER DIMENSIONS	6-7.5"

NEW DUCT SUPPORTS PER CN-1234

NEW BUS DUCT SUPPORTS PER CN-1605

NEW BUS DUCT SUPPORTS PER CN-1605

U440CVFG & CVFWG TYPICAL ALL RUNS

TRANSF THROAT CONN. SEE DWG. 79-2D-89096-2

NOTE: O INDICATES JOINT STACK LOCATION.

NOTE: THIS DRAWING IS EXPRESSED IN FEET, INCHES, & DECIMALS. EXAMPLE = 12'-3.25"

JOB: PUBLIC SERVICE OF COLORADO PLATTEVILLE, COLO.	
CUST: BROWN BOVERI ELEC.	PO: R-00571
DATE: 79-89095	BY: S.W. 10-12-62
TITLE: BUS DUCT LAYOUT AND LOCATION OF BUS DUCT SUPPORTS	
DWG. NO: CN-1605-SK-24	
SHEET: 05	

8608010229

PDR RIDS

86080/0229

