
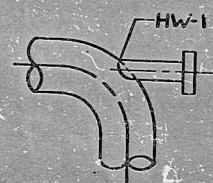


I CERTIFY THAT THE IMAGE CONTAINED ON THIS FRAME WAS MADE IN THE ACTUAL AND REGULAR COURSE OF BUSINESS, ON THE DATE STATED BELOW, AND THAT IT IS AN ACCURATE REPRODUCTION OF THE DOCUMENT SUBMITTED TO SPMS CONFORMANCE AND DRAWING FILES.


DATE: 10-8-73 *Madhavan*

16X


PPAL PDSH 3500G (1/79)

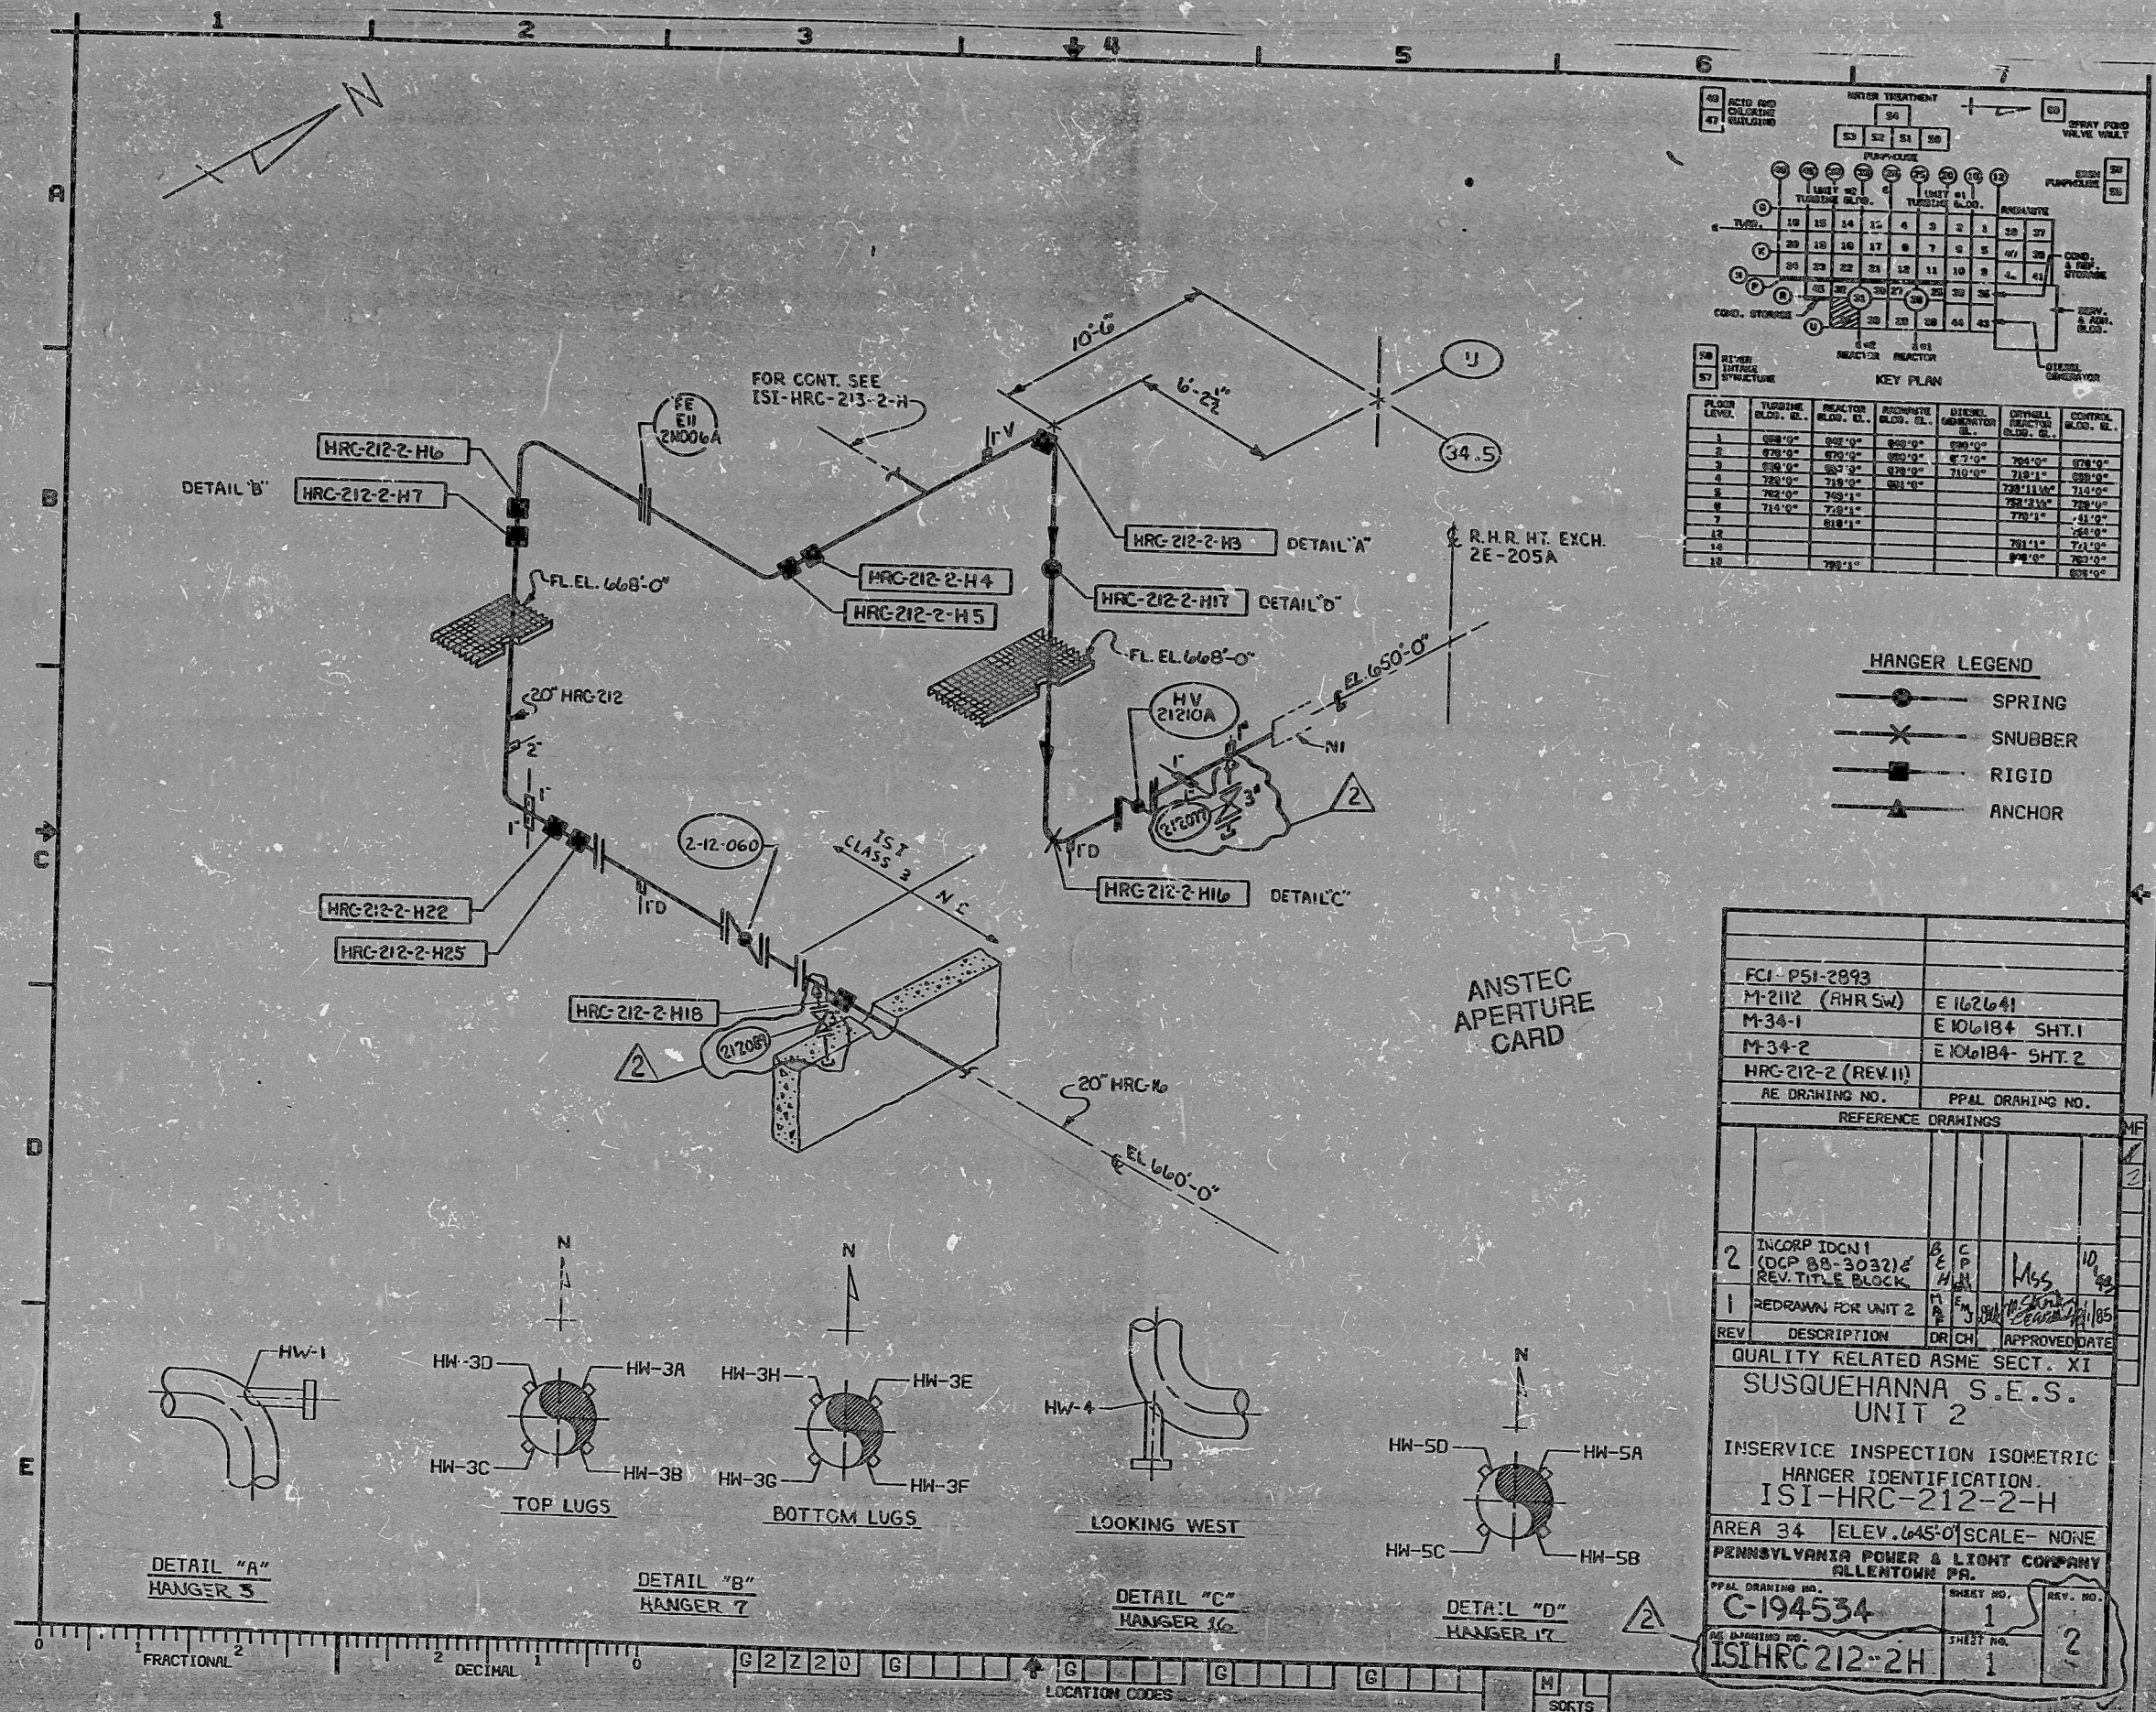


DETAIL "A"
HANGER 3

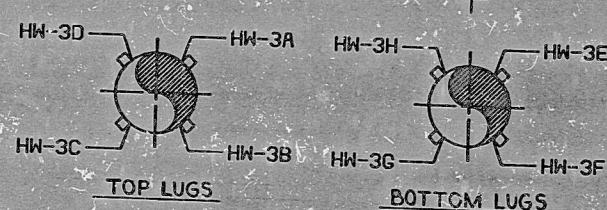

DETAIL "B"
HANGER 7

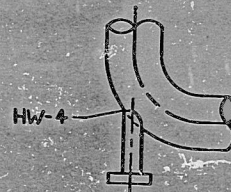


DETAIL "C"
HANGER 16

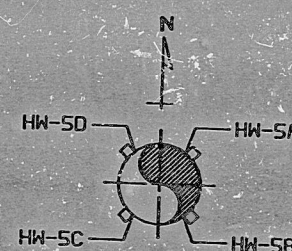

DETAIL "D"
HANGER 17

ANSTEC
APERTURE
CARD

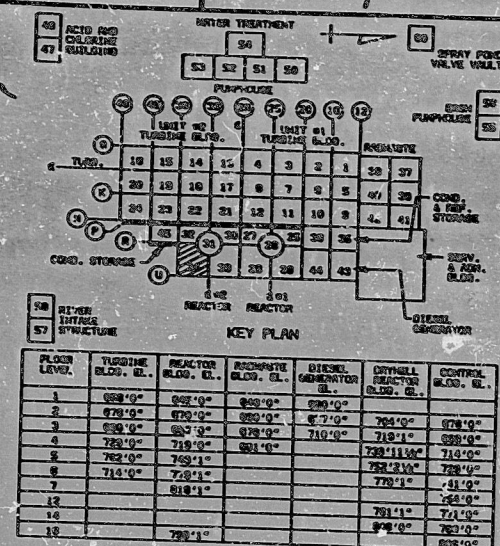

HANGER LEGEND

- SPRING
- X— SNUBBER
- RIGID
- ▲— ANCHOR

FCI PSH-2893	
M-2112 (RHSW)	E 162641
M-34-1	E 106184 SHT.1
M-34-2	E 106184 SHT.2
HRC-212-2 (REV.11)	
AE DRAWING NO.	PPAL DRAWING NO.
REFERENCE DRAWINGS	
2	INCORP IDCN1 (DCP 88-3032) REV. TITLE BLOCK
1	REDRAWN FOR UNIT 2
REV	DESCRIPTION
QUALITY RELATED ASME SECT. XI	
SUSQUEHANNA S.E.S. UNIT 2	
INSERVICE INSPECTION ISOMETRIC HANGER IDENTIFICATION	
ISI-HRC-212-2-H	
AREA 34	ELEV. 645'-0" SCALE- NONE
PENNSYLVANIA POWER & LIGHT COMPANY ALLENTOWN PA.	
PPAL DRAWING NO.	SHEET NO.
C-194534	1
ISI-HRC-212-2-H	2

PDR RIDS

9505260342

