


3154100 SH.9

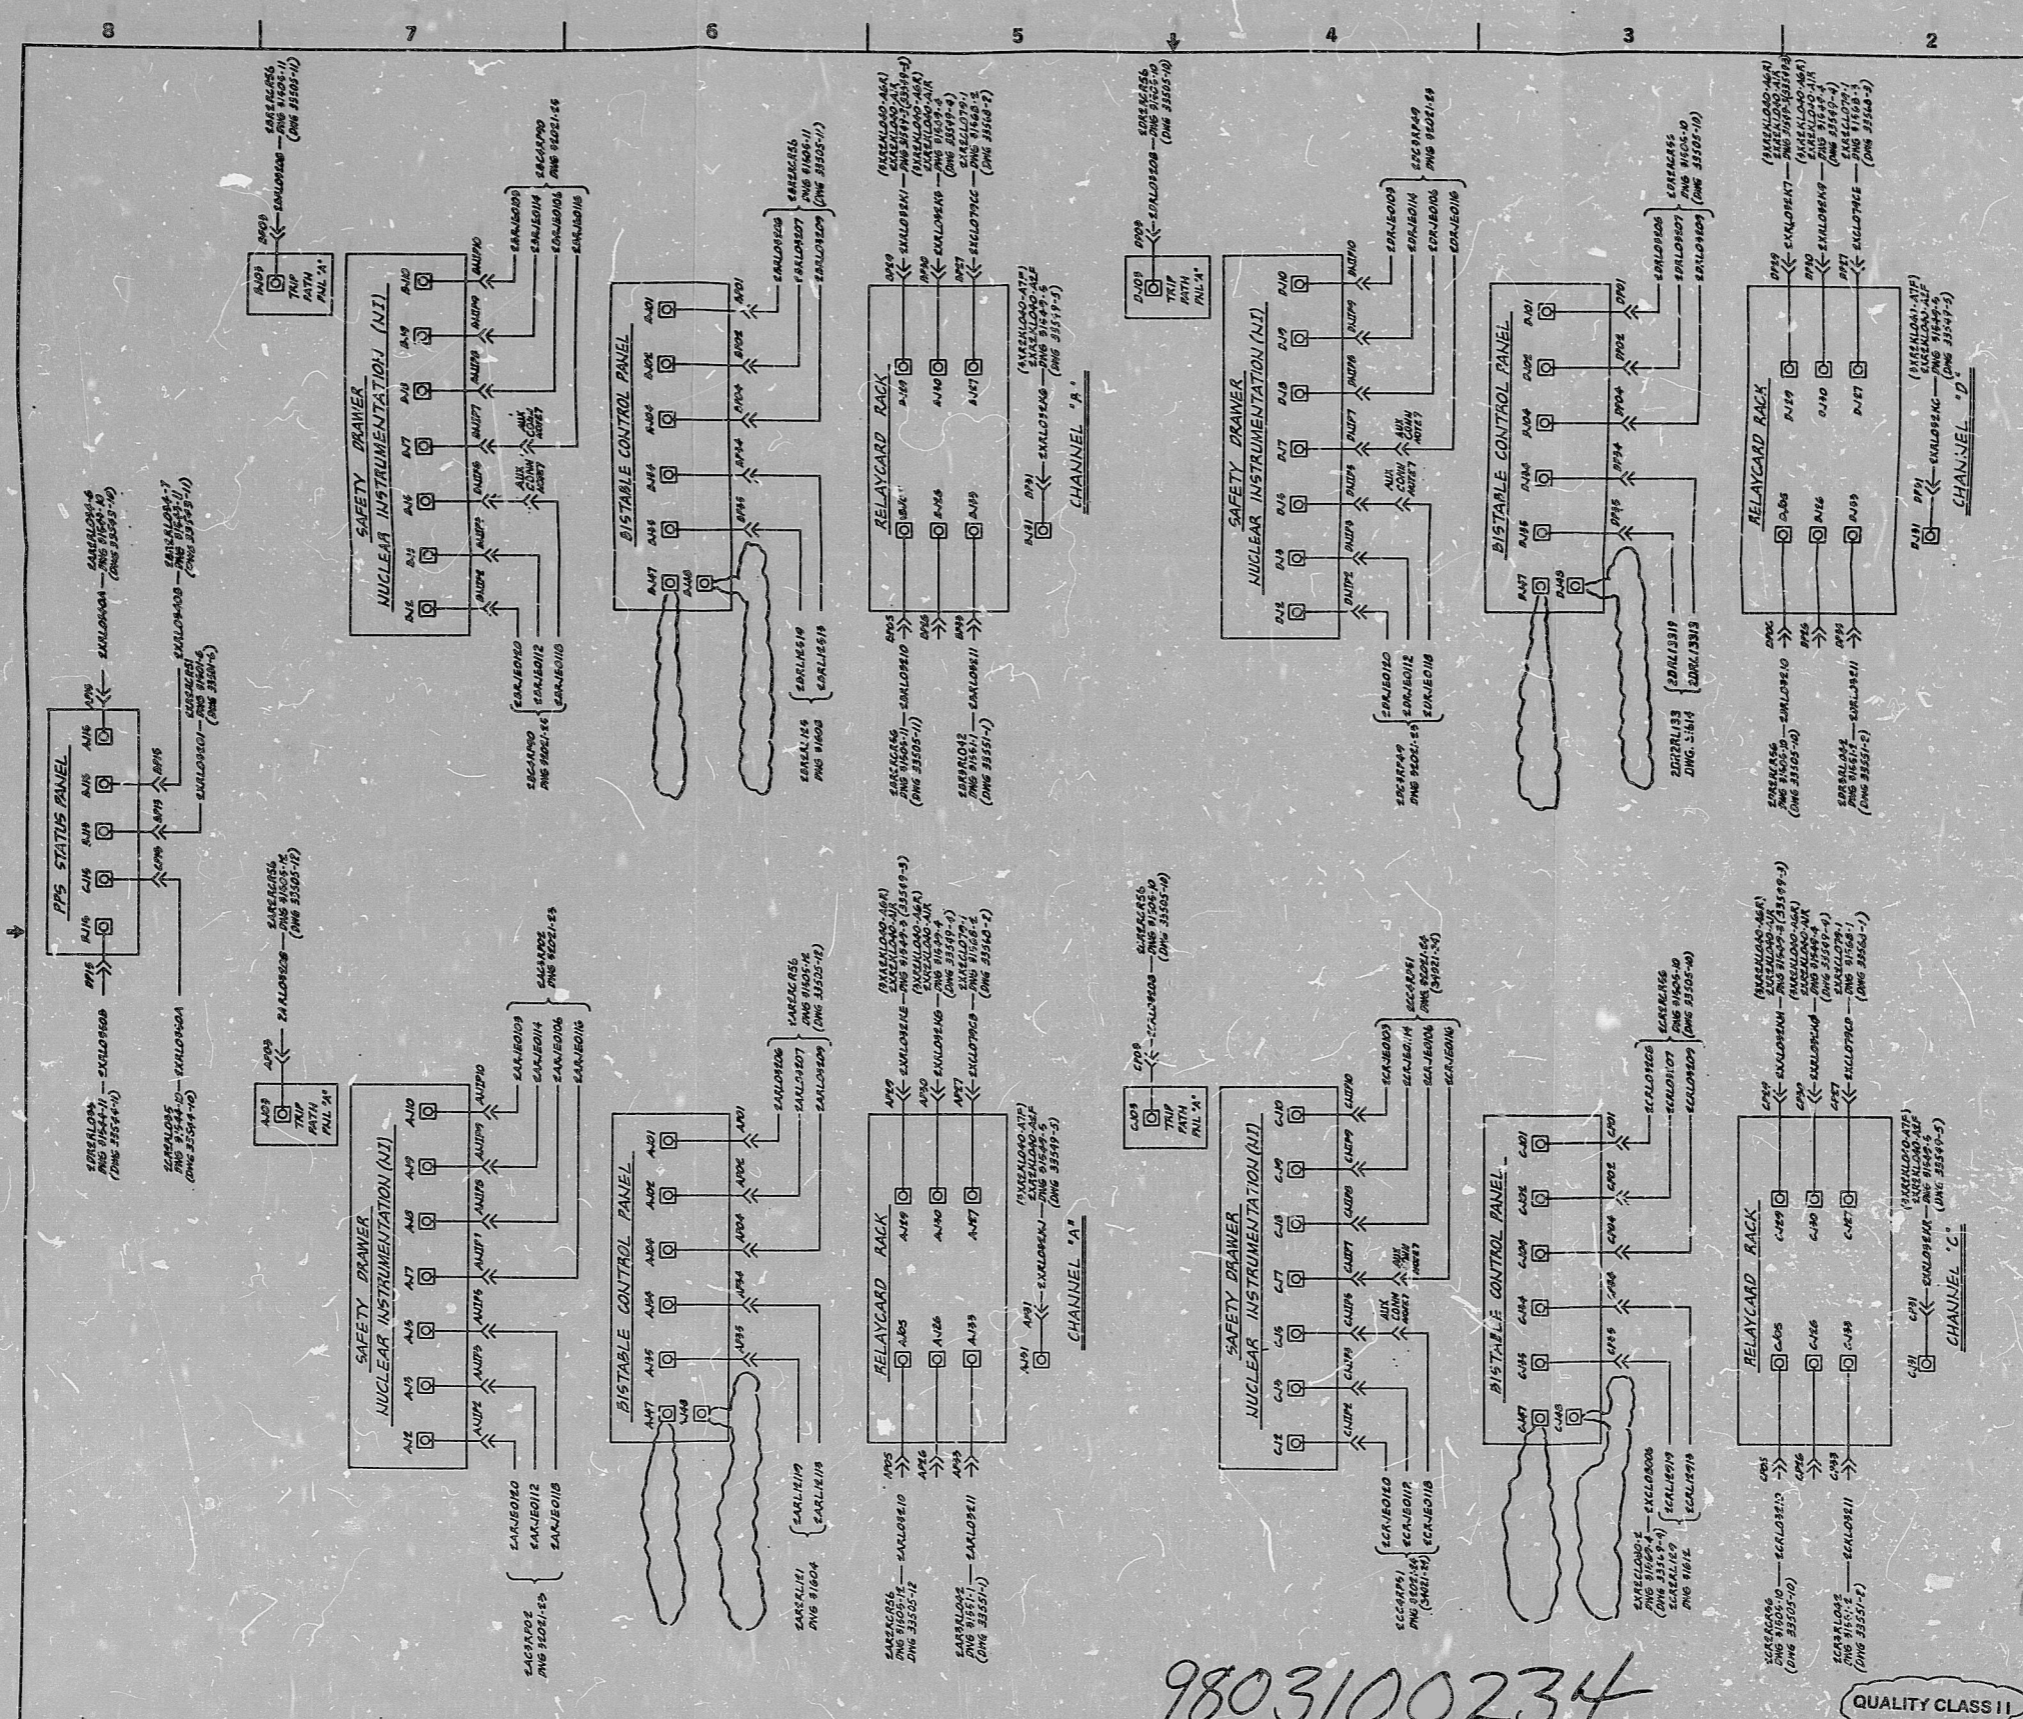

9803100234

QUALITY CLASS II

BECHTEL CORPORATION ENGINEERS & CONSTRUCTORS LOS ANGELES, CALIF.		DWG. NO. 3154100-234		TITLE WIRING DIAGRAM		UNIT 3 SAN ONOFRE NUCLEAR GENERATING STATION	
DESIGNED BY 10079	DATE 11/27/68	APPROVED [Signature]	CHECKED BY [Signature]	DRAWN BY [Signature]	DATE 11/27/68	SCALE AS SHOWN	SHEET NO. 234
CROSS REFERENCES INC DCN 5 & 6		REVISIONS 1 REV AS MARKED 2 QUALIFIED FOR UNIT 3 (REV. AS MARKED) 3 INC DCN 5 & 6 (REV. 2) 4 INC DCN 5 & 6 (REV. 2) 5 INC DCN 5 & 6 (REV. 2)		REVISIONS DATE 11/27/68 BY [Signature]		SAN ONOFRE NUCLEAR GENERATING STATION CONTROL BUILDING PPS CABINET 2L3LQ32 SOUTHERN CALIFORNIA Edison COMPANY LOS ANGELES, CALIF.	

- NOTES:
- THIS DRAWING IS APPLICABLE FOR FIELD CONNECTION ONLY.
  - FOR ELECTRICAL NUMBERING SYSTEM, EQUIPMENT LOCATION NUMBERS, DEVICE FUNCTION NUMBERS, ABBREVIATIONS, SYMBOLS, ETC., SEE DRAWINGS 3000, 3001 AND 3002.
  - UNIT 3 SIMILAR EXCEPT CHANGE UNIT DESIGNATION OF CASE NUMBER & EQUIPMENT LOCATION NUMBERS FROM "2" TO "3".
  - ANY BRACKETED NUMB. APPLIES TO UNIT "2" ONLY.
  - REFERENCE CARLINE BLOCK DIAGRAMS.
- |          |        |
|----------|--------|
| 8450     | 8451-2 |
| 8452     | 8452-2 |
| 8453     | 8453   |
| 8454-1,2 | 8454   |
- SEE DWG. SETS SH. 1-4 FOR CONNECTOR DETAILS.

H  
G  
F  
E  
D  
C  
B  
A

30X

9803100234

PDR RIDS

\*9803050133\*  
9803100234

