


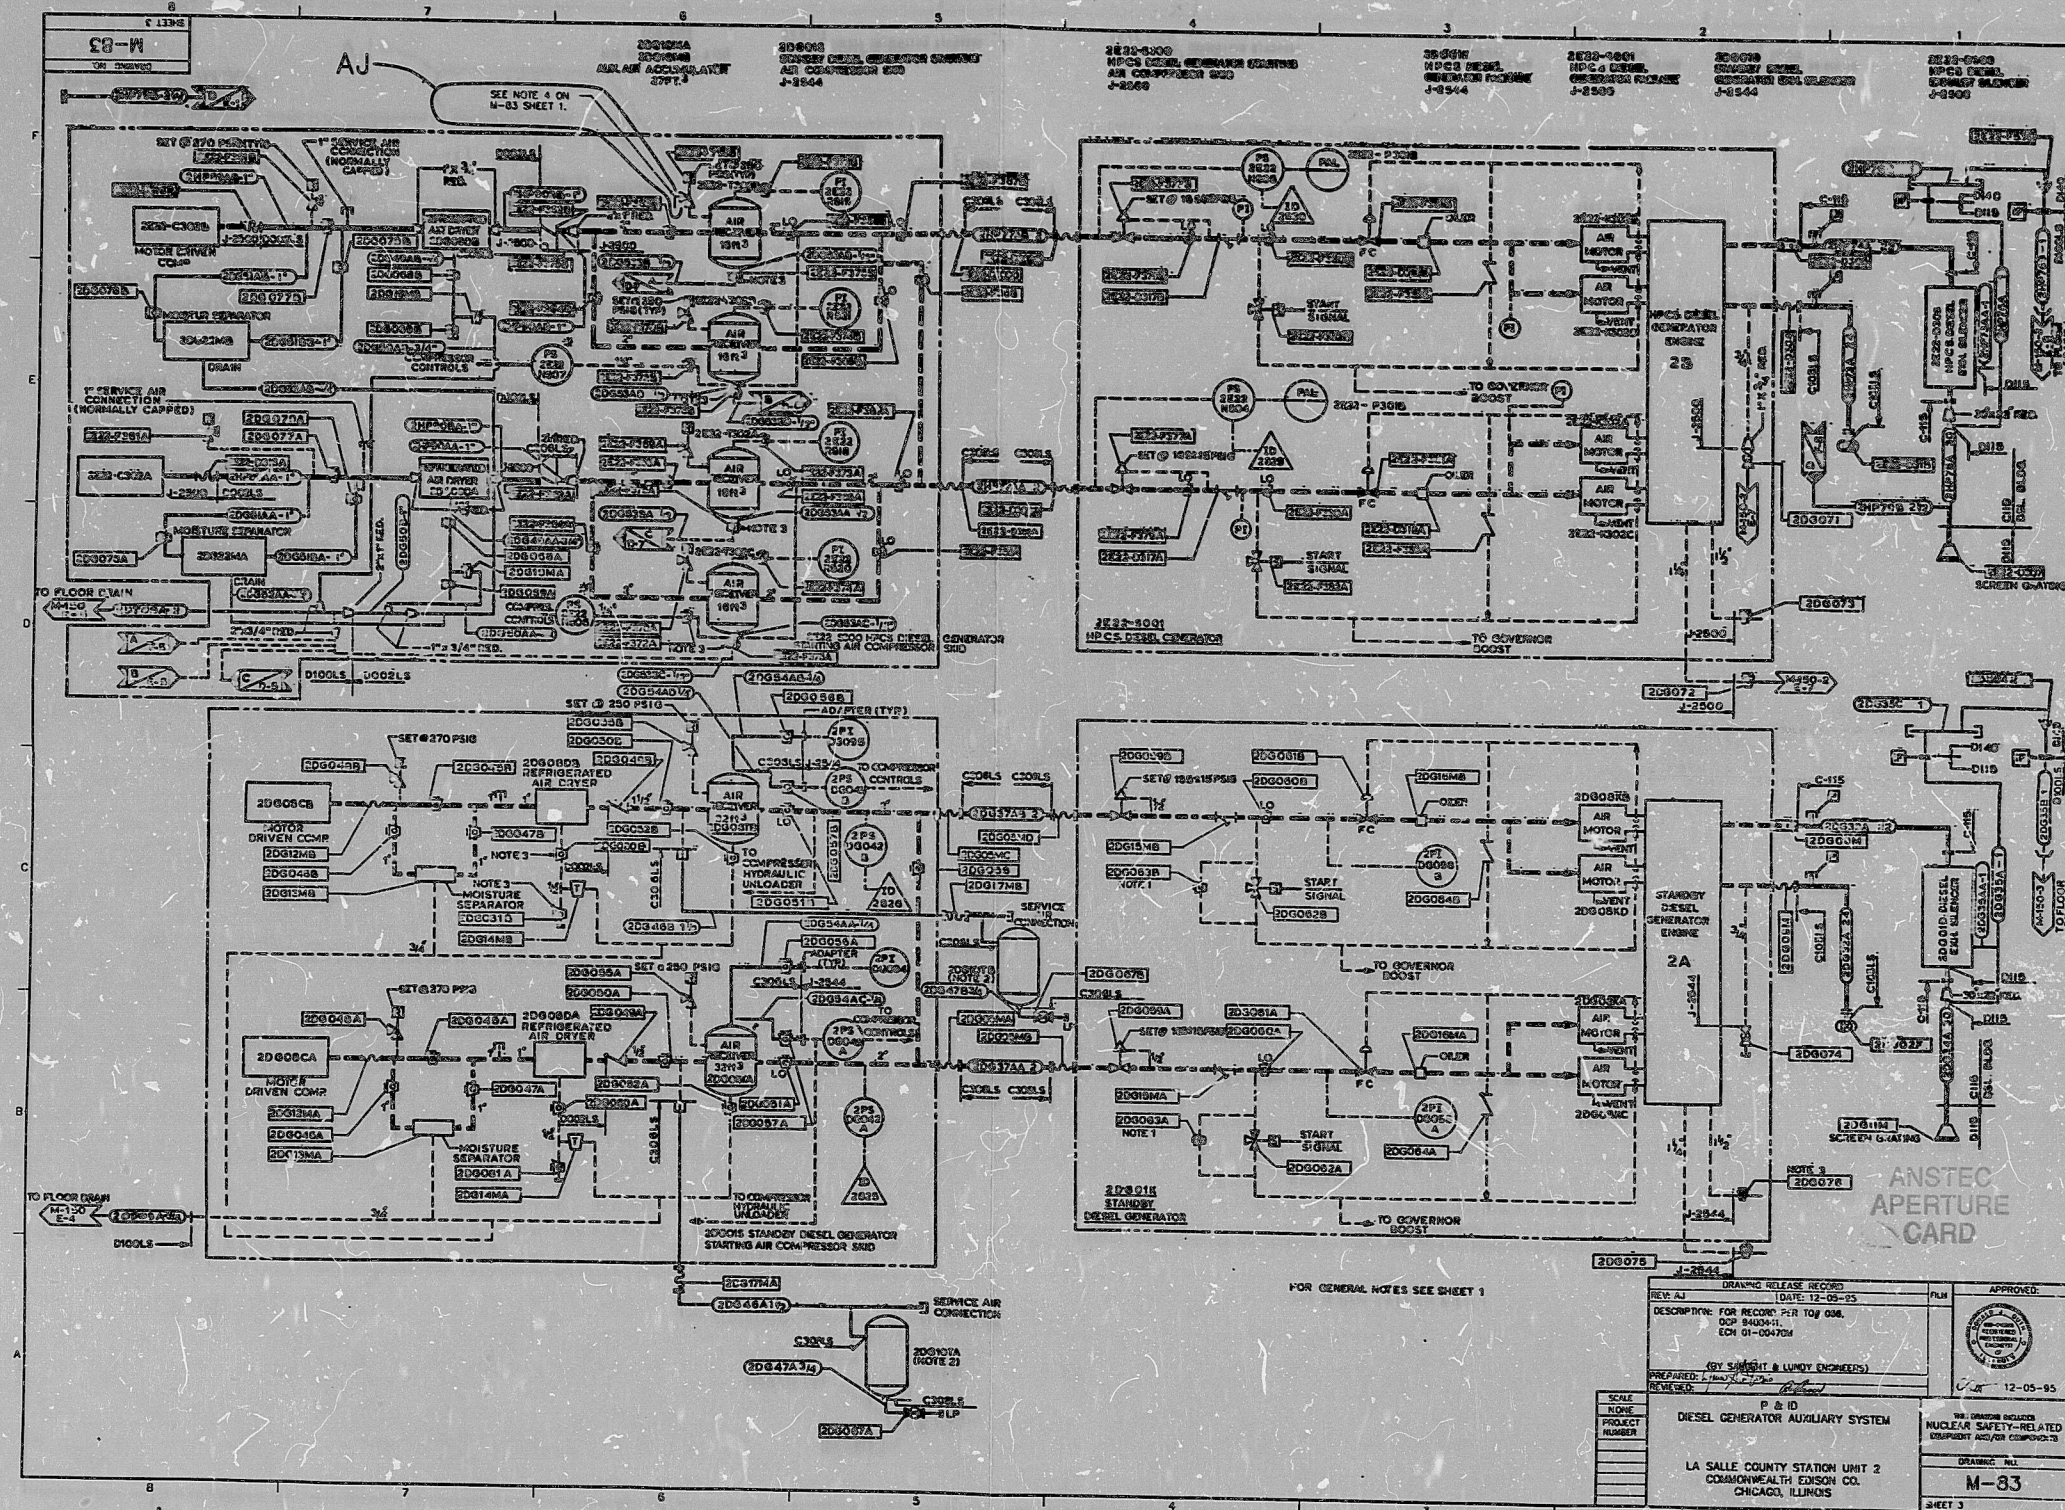

CENTRAL DRAWING FACILITY

30 X

DRAWING RELEASE RECORD DATE: 12-05-95 DESCRIPTION: FOR RECORD PUR TOY 004 DOP 8404-11 CON 01-00400 PREPARED: L. HAYES REVIEWED: L. HAYES		APPROVED: 12-05-95
SCALE: NONE PROJECT NUMBER: LA SALLE COUNTY STATION UNIT 2 COMMONWEALTH EDISON CO. CHICAGO, ILLINOIS	P & ID DIESEL GENERATOR AUXILIARY SYSTEM M-83 SHEET 3	ALL DRAWINGS INCLUDE NUCLEAR SAFETY-RELATED EQUIPMENT AND/OR COMPONENTS

9803170071

PDR RIDS

9803170071

