


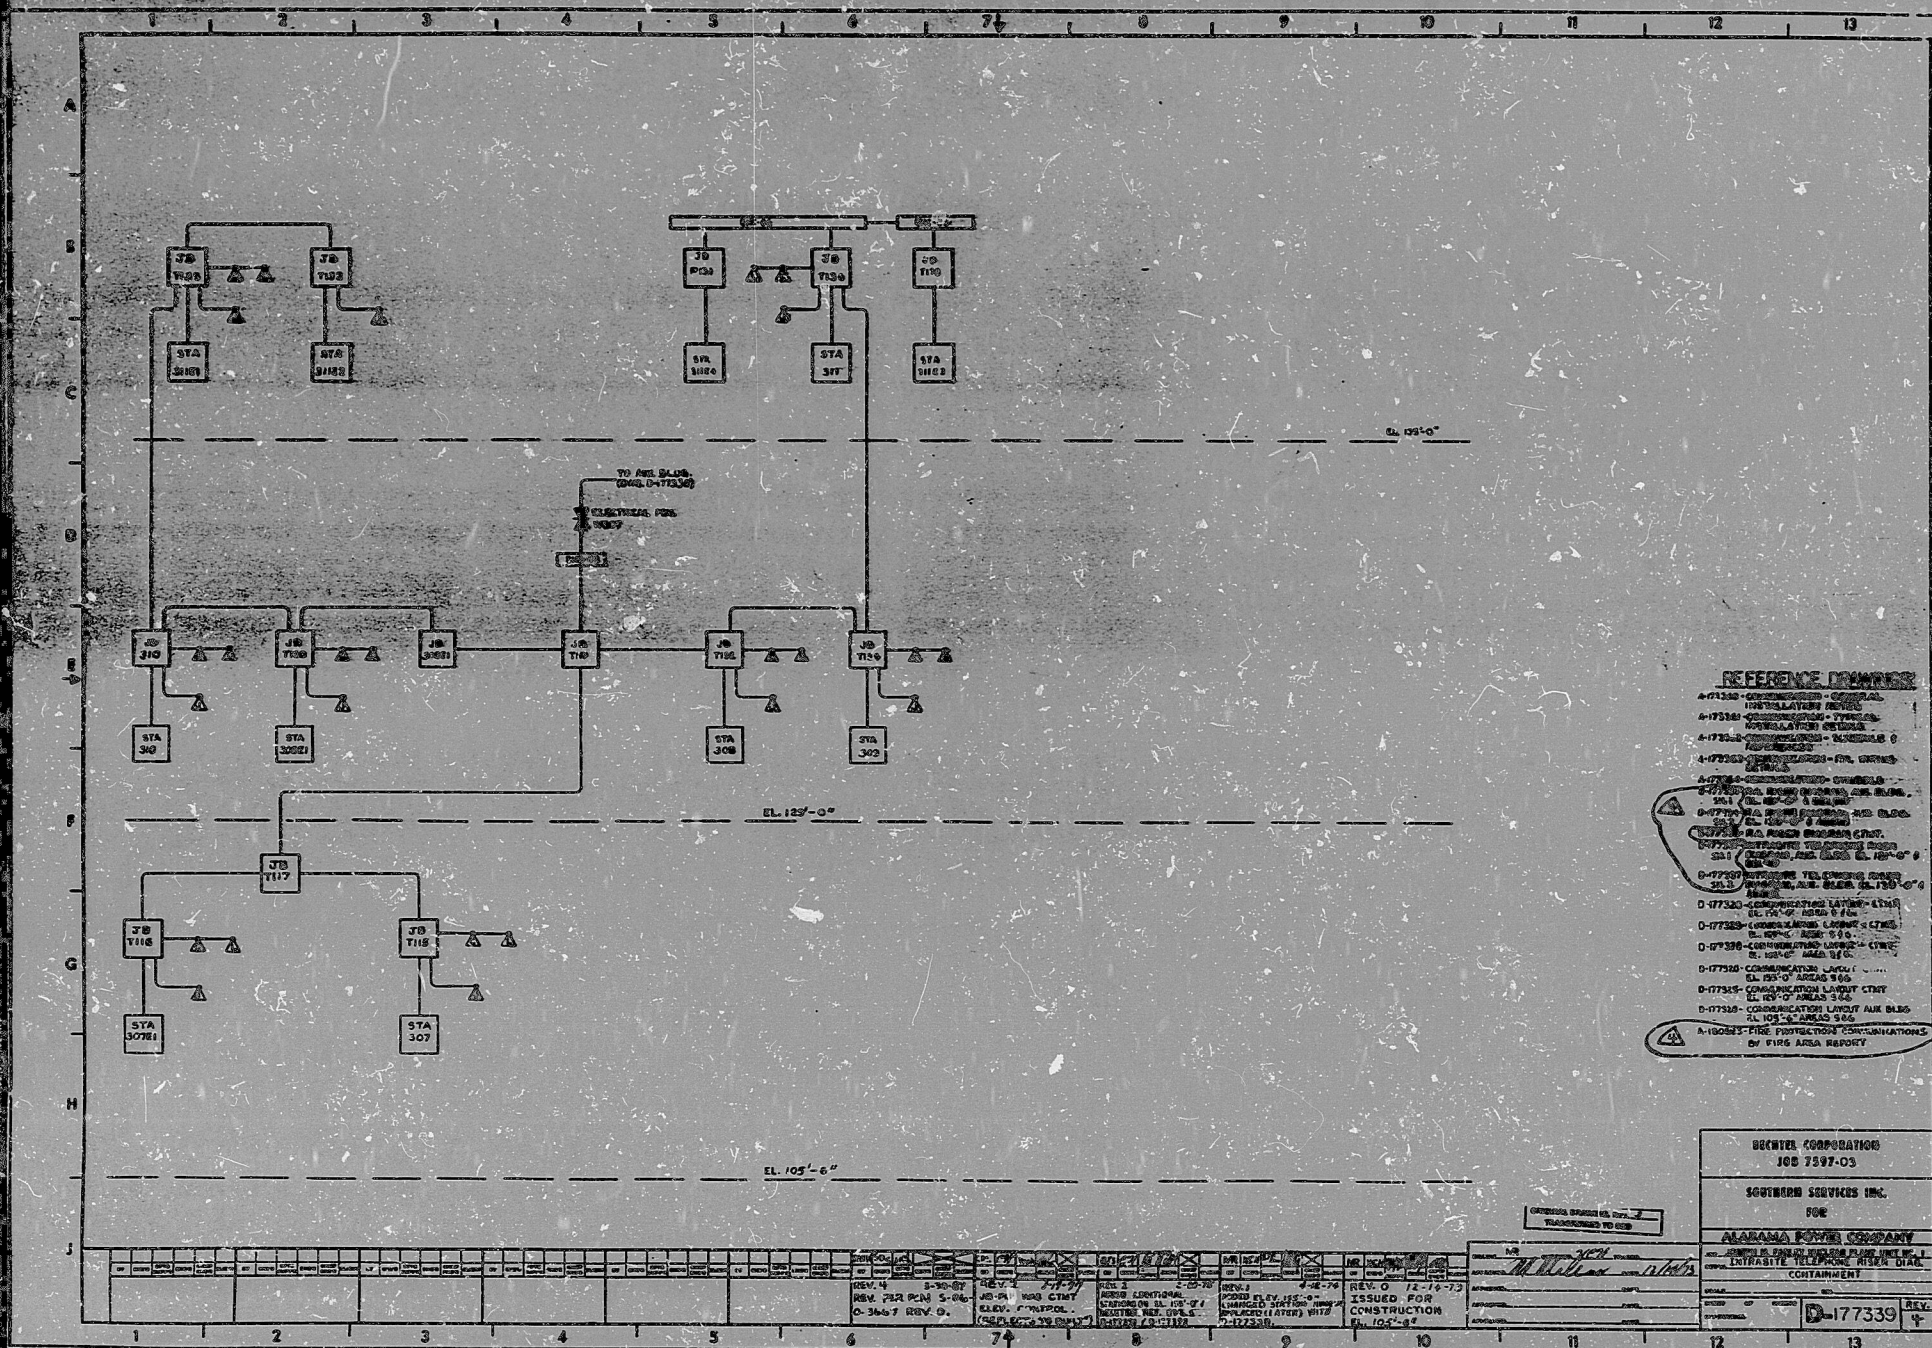

BECHTEL CORPORATION
JOB 7597-03

SOUTHERN SERVICES INC.
FOR

ALABAMA POWER COMPANY
CONTAINMENT

REV. 0 12-16-73
ISSUED FOR
CONSTRUCTION
EL. 105'-6"

D-177339

APERTURE
CARD

PDR RID[®]

9605220493

