



This drawing and the design it covers are the property of BECHTEL. They are loaned and on the borrower's express agreement that they will not be reproduced, copied, loaned, exhibited, or used except in the limited way and within the limits permitted by the lender to the borrower.

SETTLEMENT IN FEET

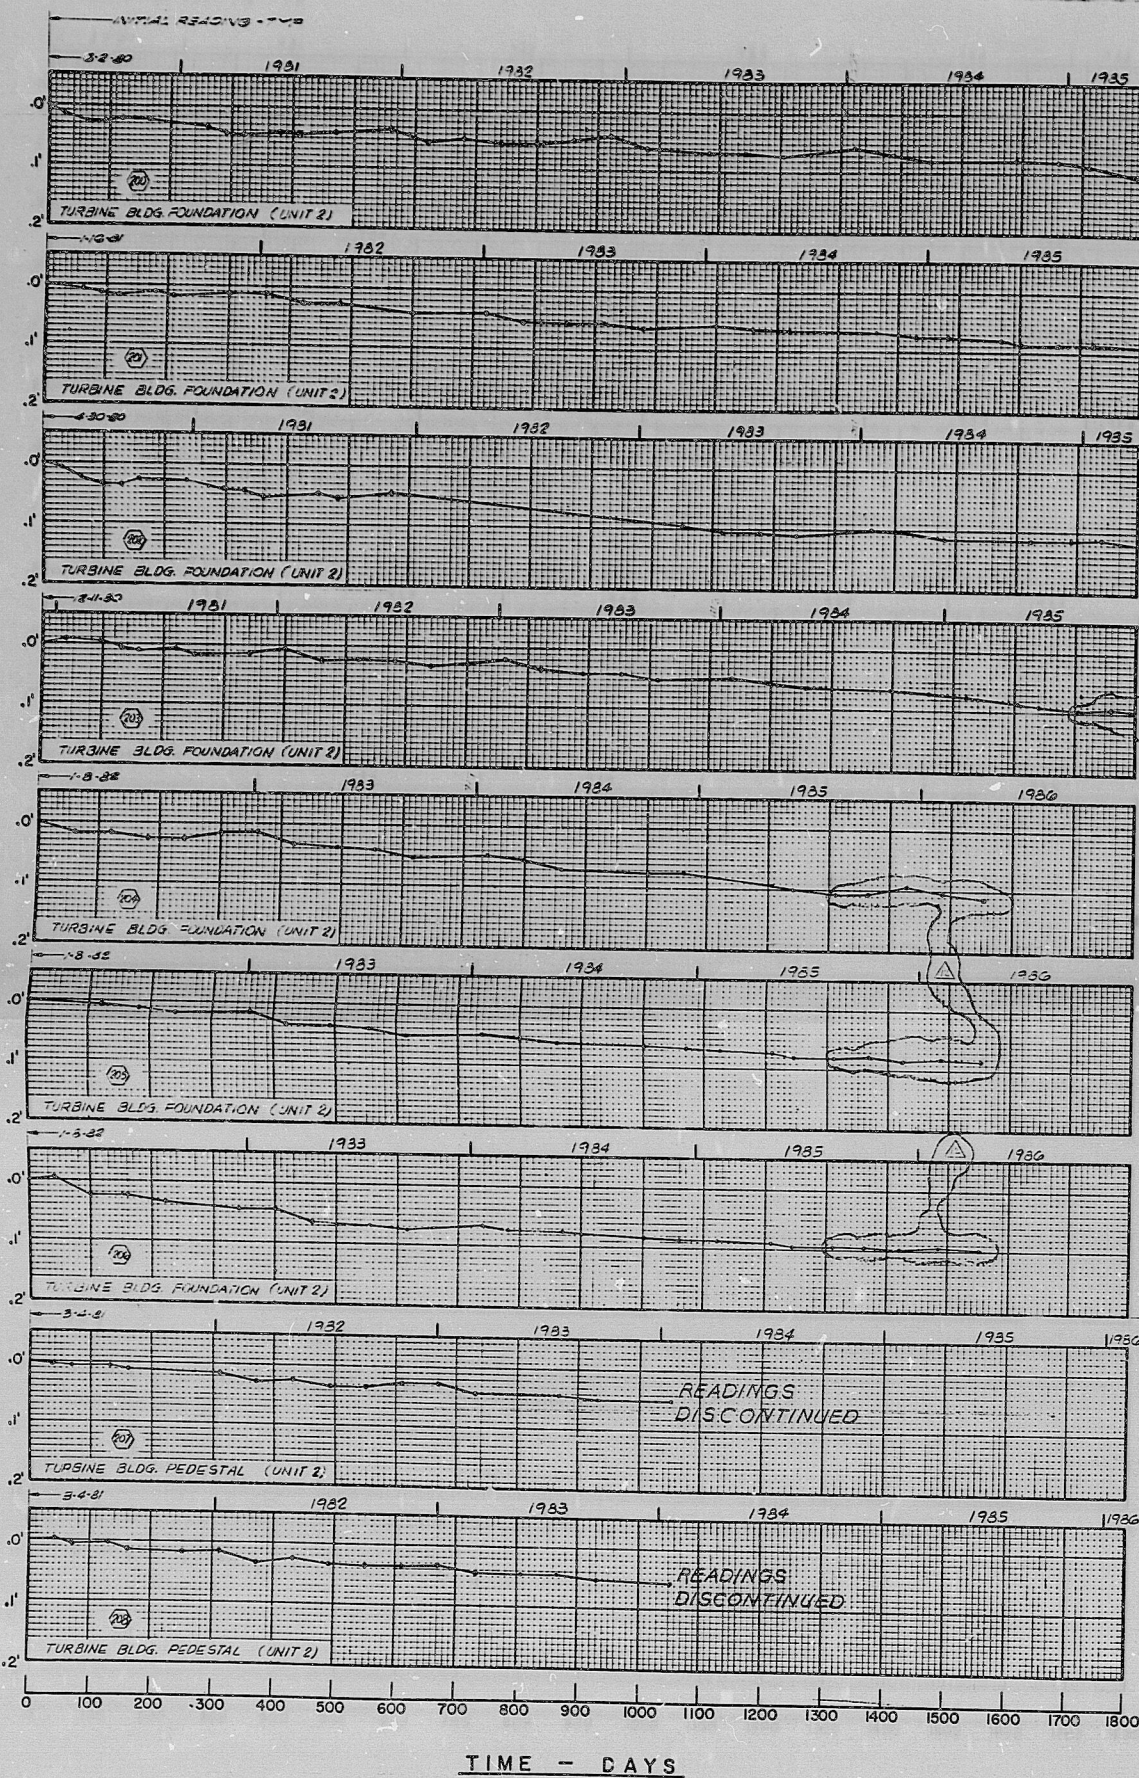

NOTE FOR CONTINUATION OF GRAPH SEE DWS A12255V009

SETTLEMENT IN FEET

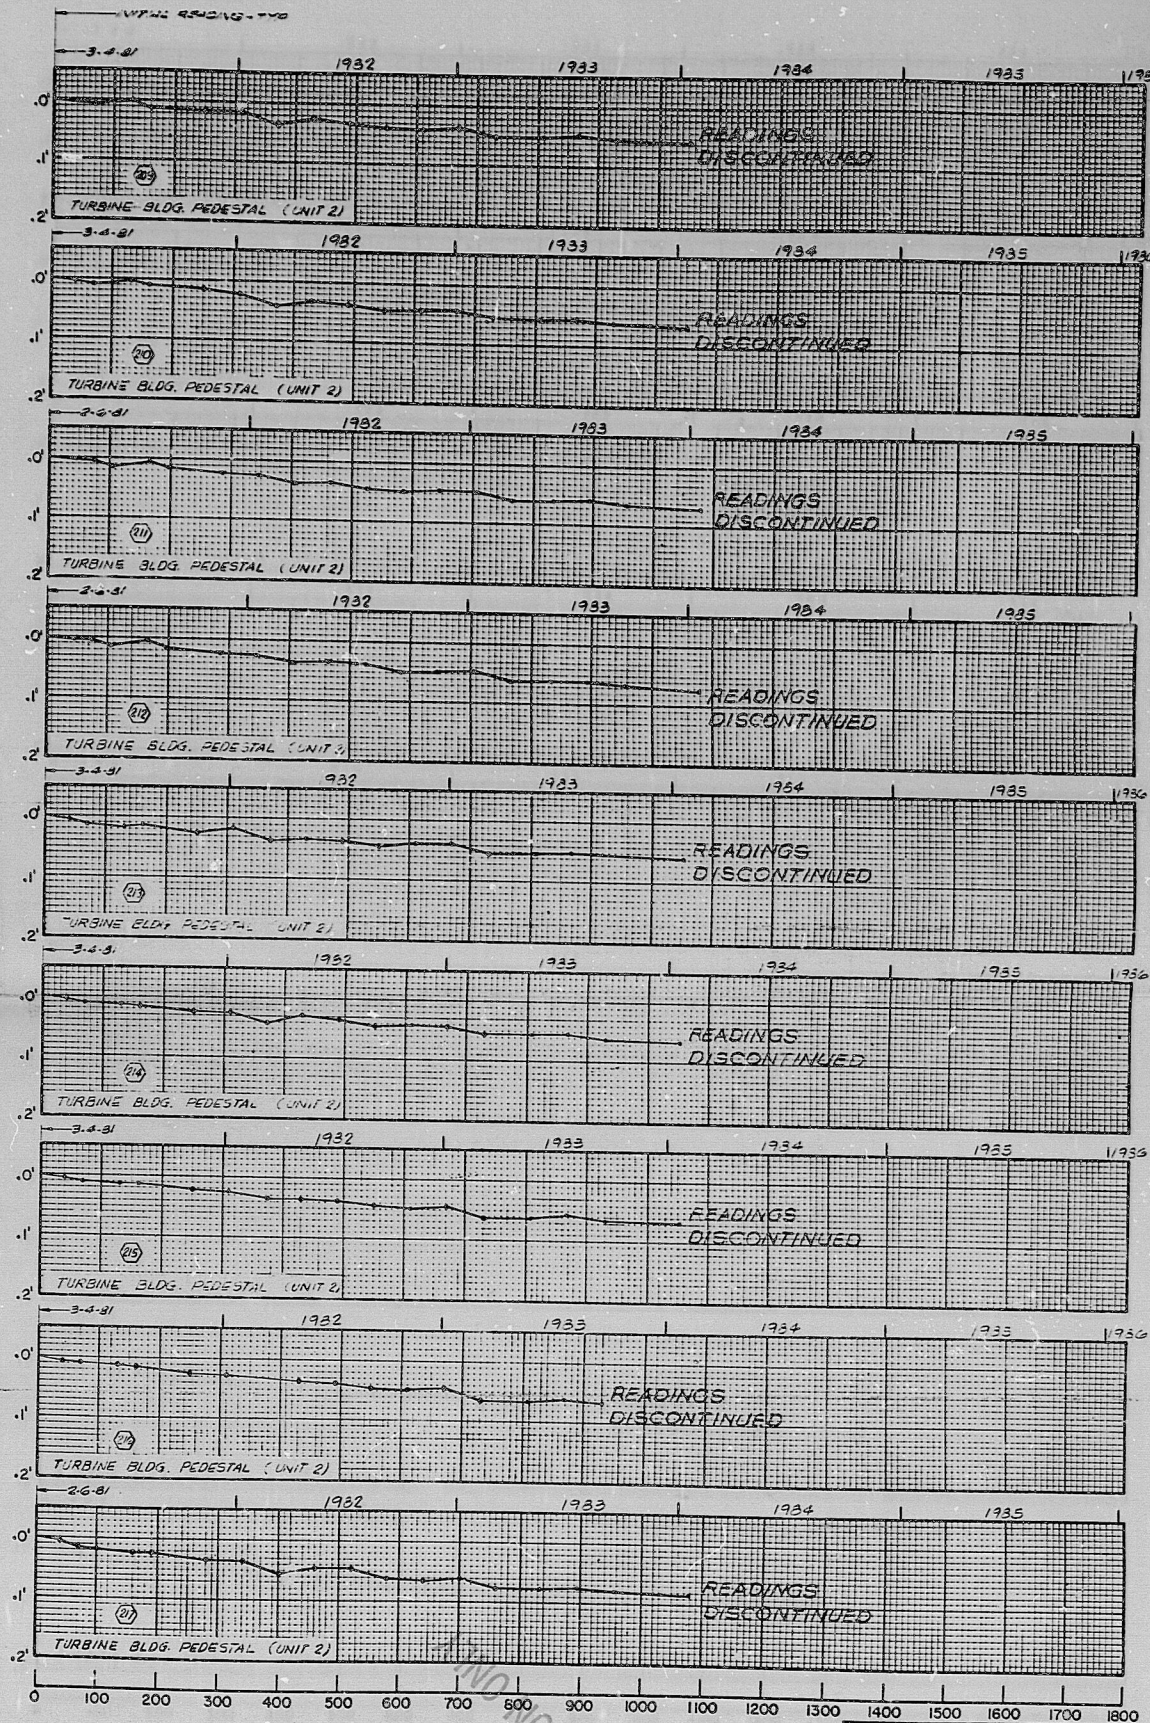

TI
APERTURE
CARD

TIME - DAYS

BECHTEL LOS ANGELES	
GEORGIA POWER COMPANY ALVIN W. VOGTLE NUCLEAR PLANT	
SETTLEMENT OBSERVATION MARKERS GRAPH SHEET 4	
SCALE: NONE	DRAWING NO.
DATE	REV.
JOB NO. 9910	AX2055V009
SIZE: 1/4" X 1/4"	12

8609170472

PDR RIDS

8609170472

