


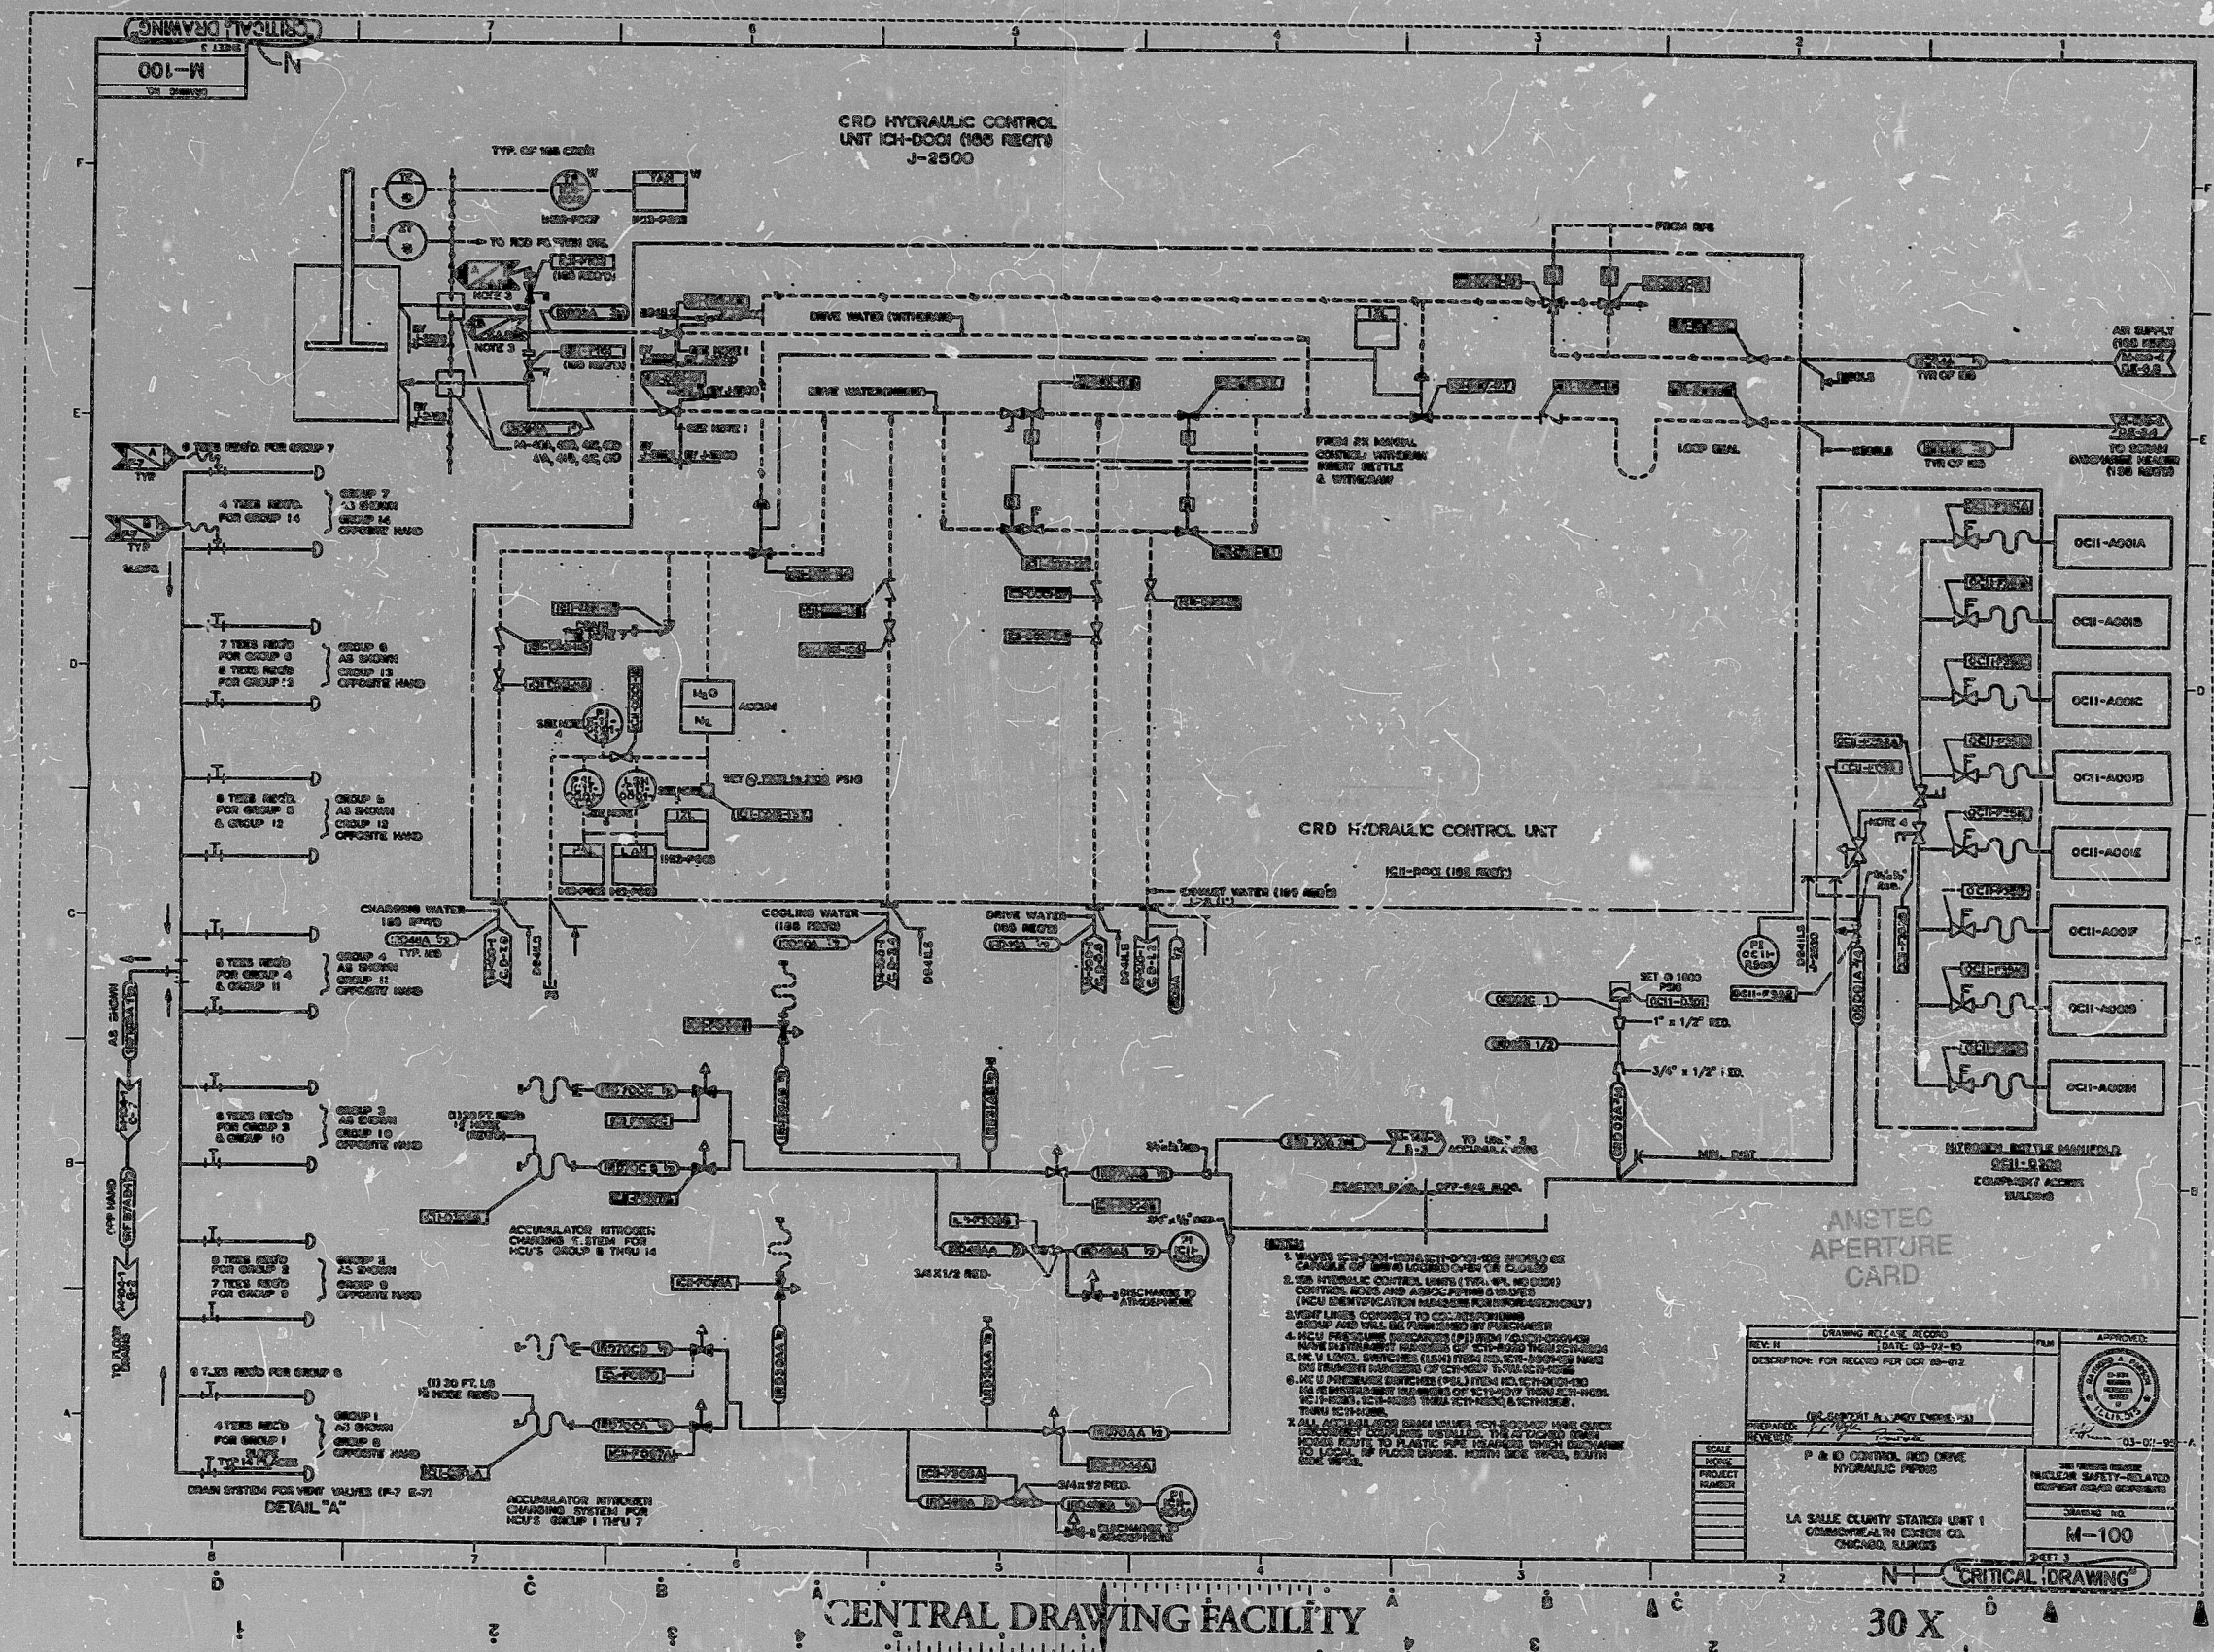

9803170345

PDR RIDS

9803170345

