




CONTROLLED at 1/31/1995 17:09:39 AS-BUILT for User DEC; Image generated - cannot be reproduced per NRC-604

9507110133

PDR RIDS

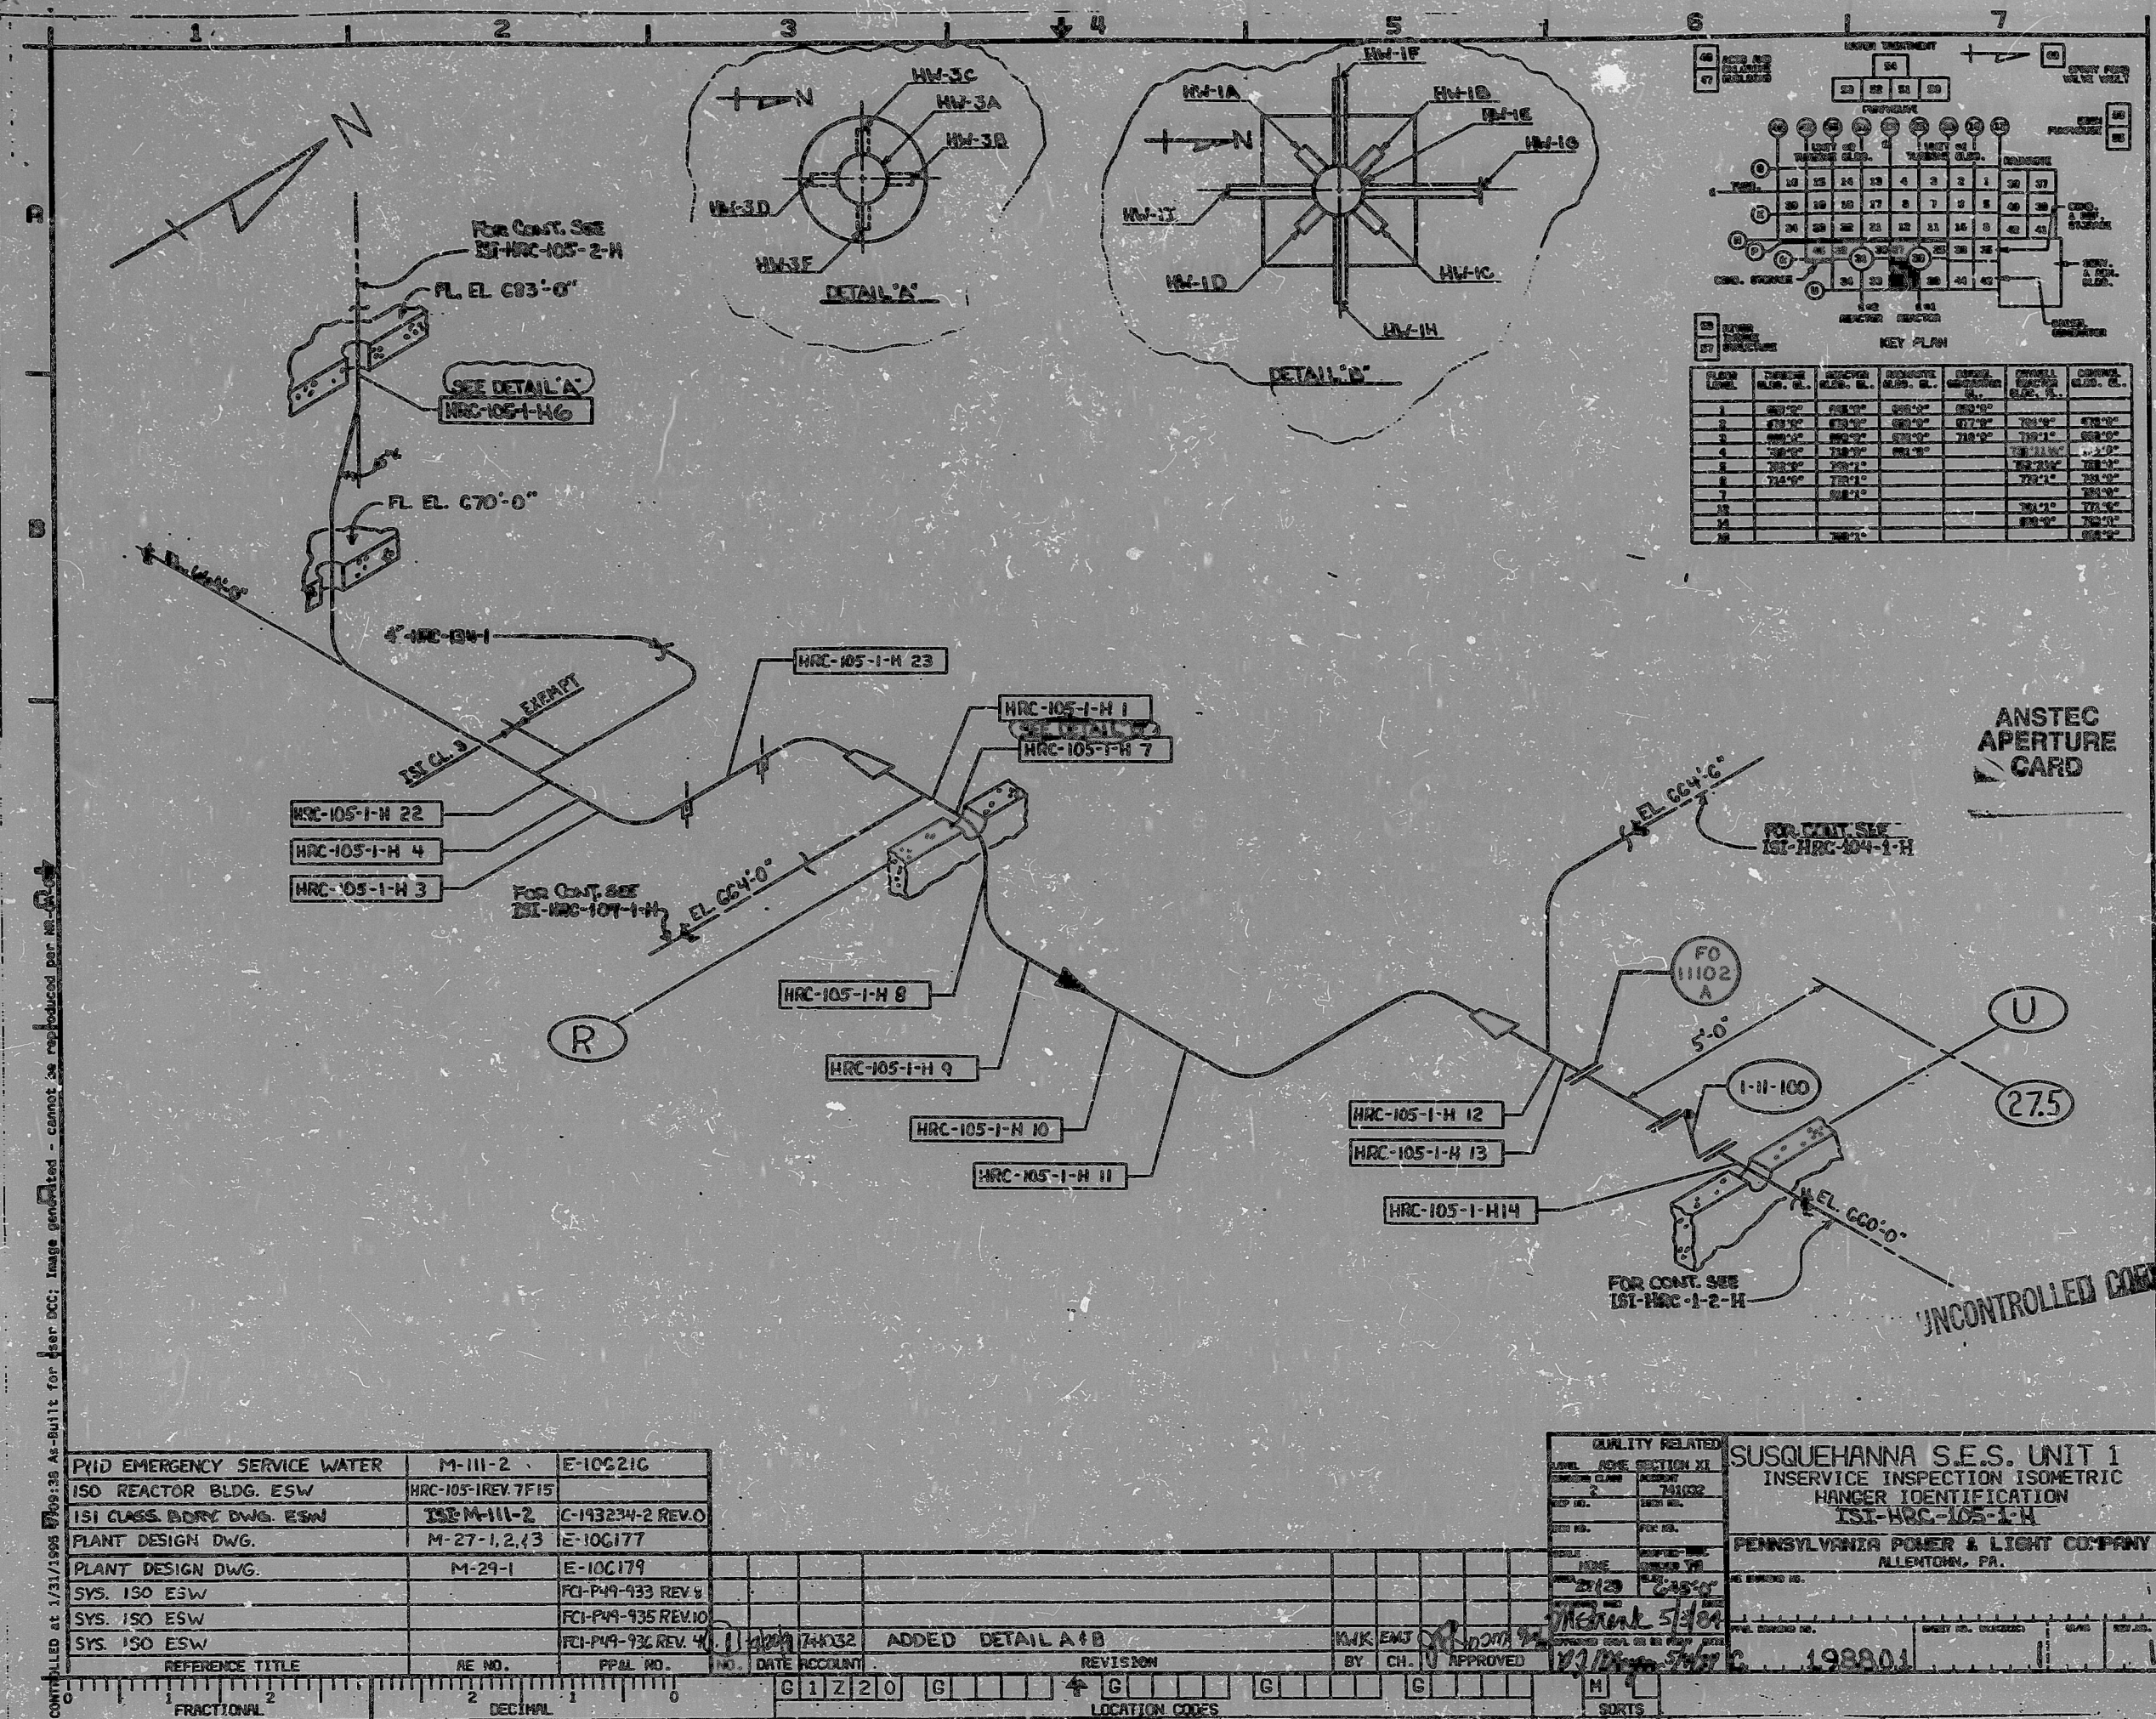