


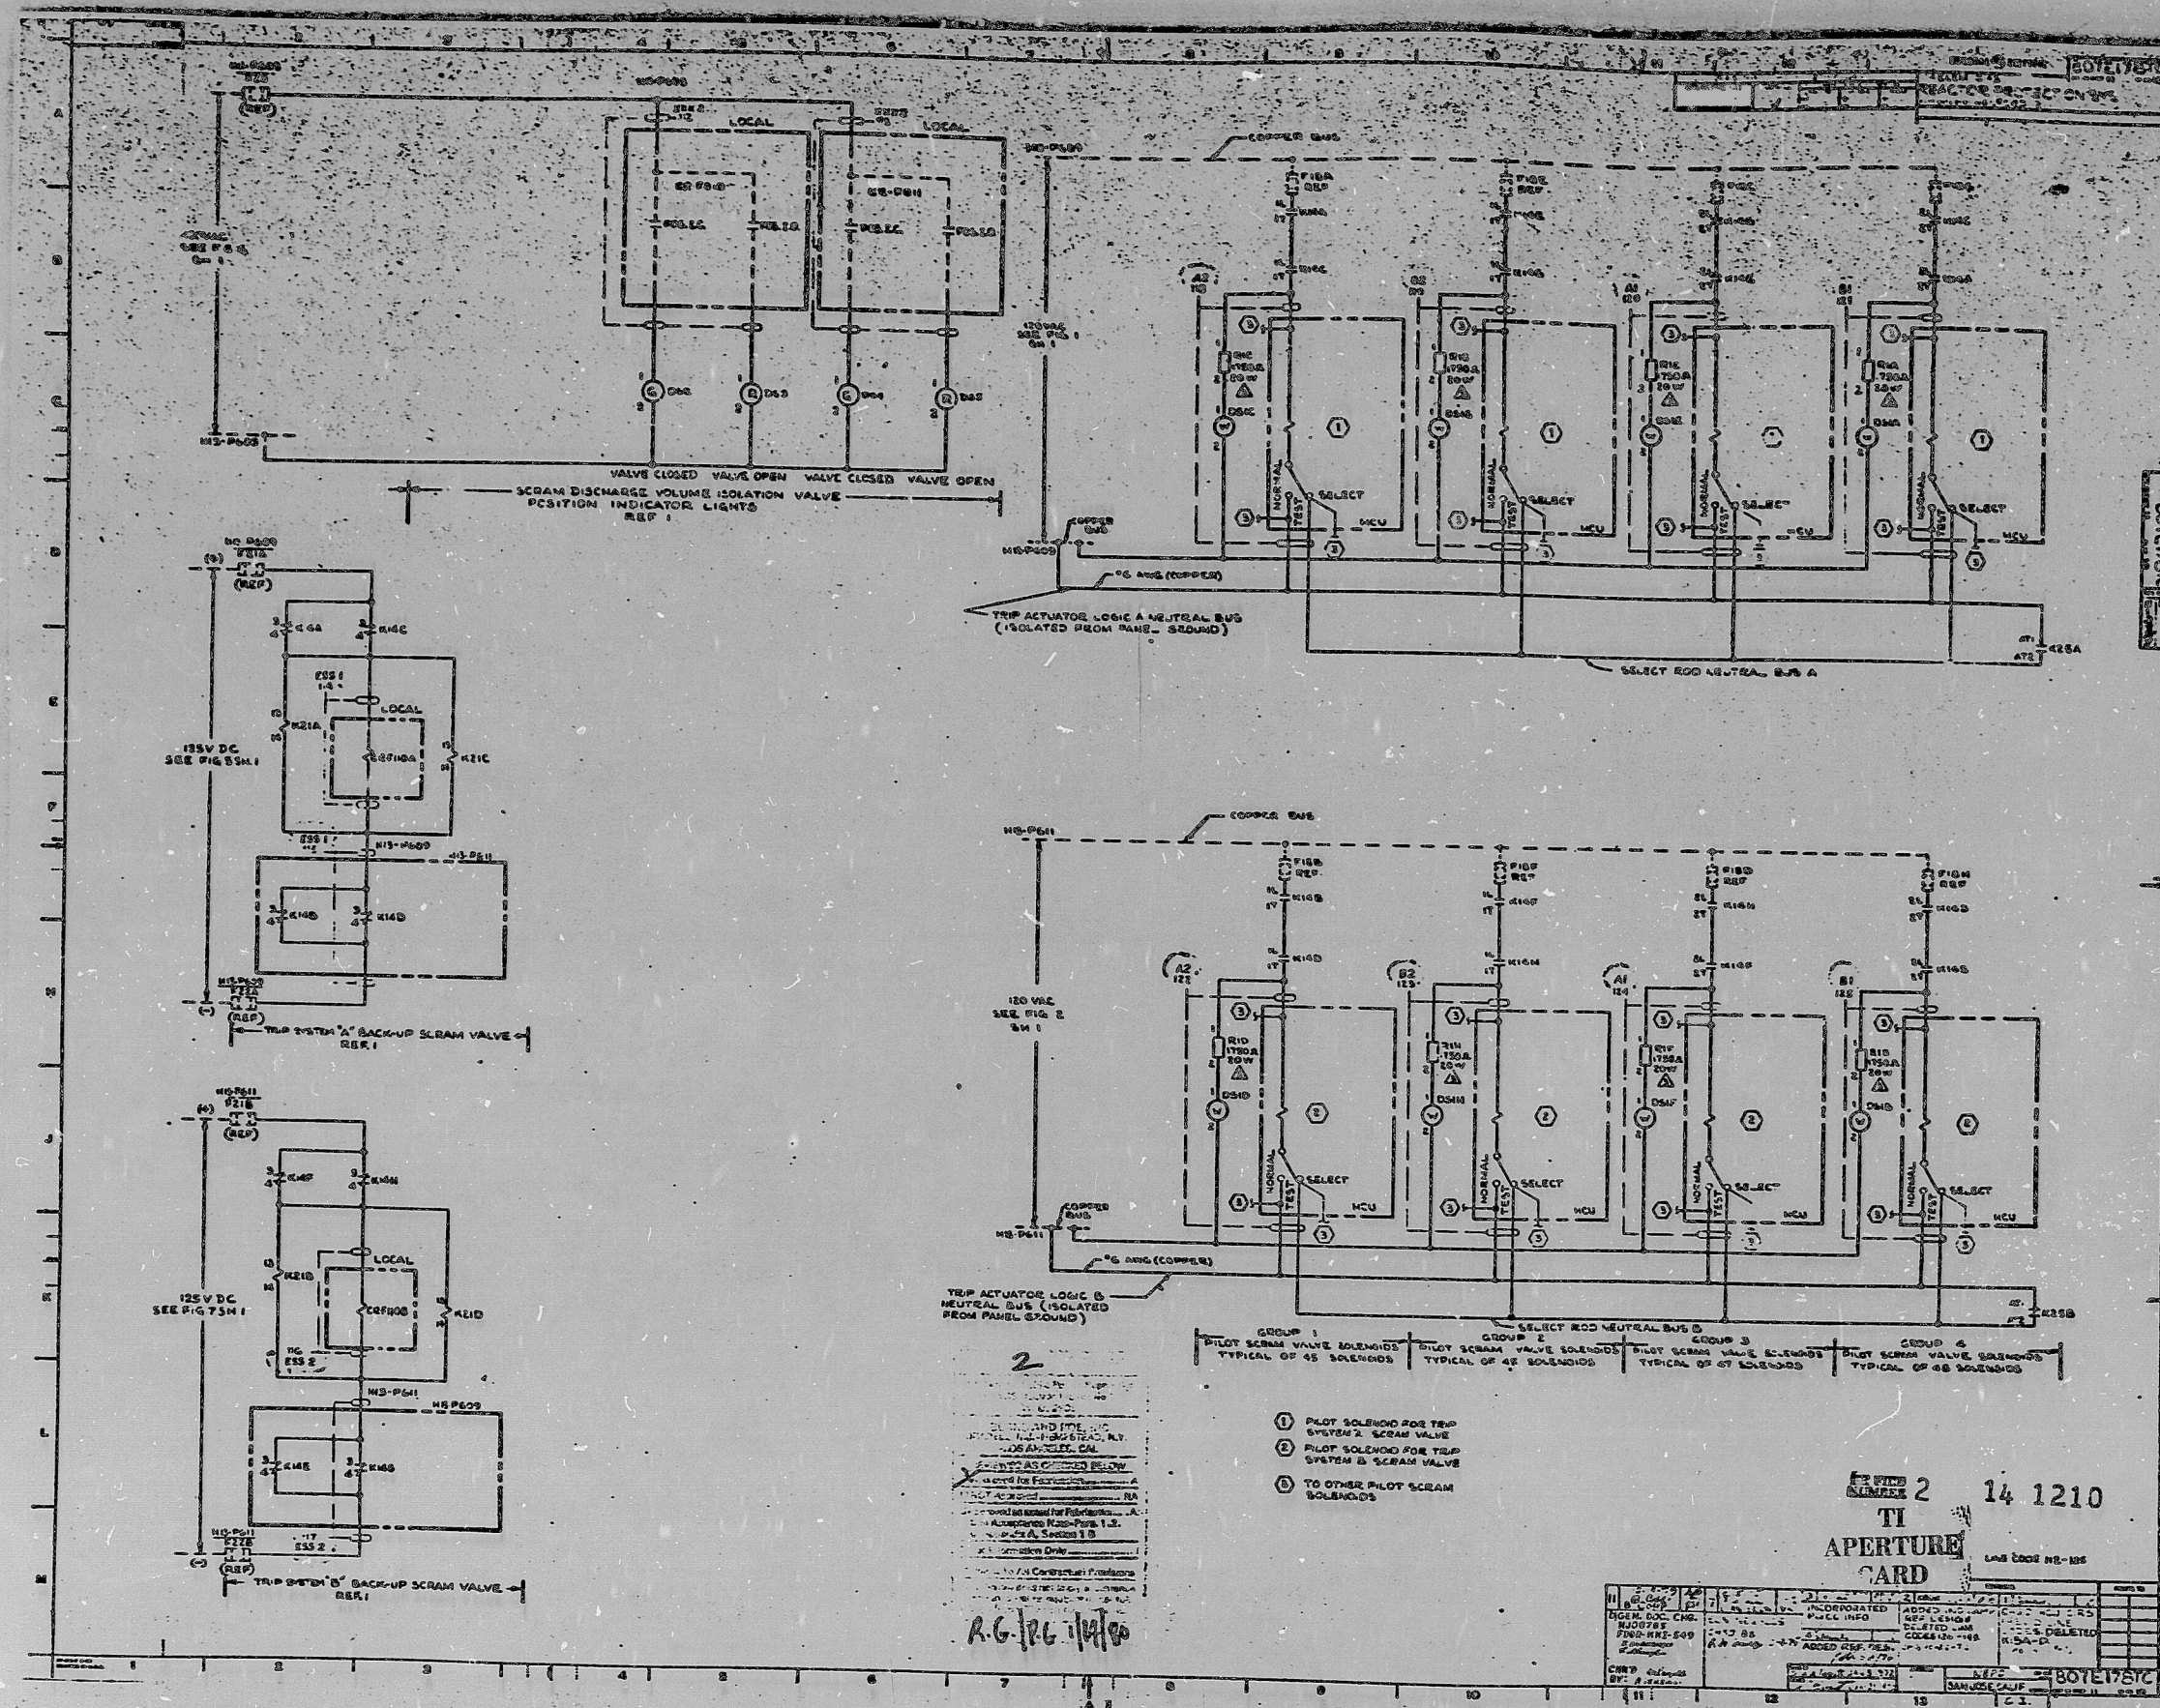

2 14 1210

TI
APERTURE
CARD

NO.	DESCRIPTION	DATE	BY	REVISION

8609190 135

PDR RID^S

