

FITOT TUBE BUBBLER TUBE
 MTC IN POWER BOARD 176
 * VALUES FURNISHED BY CH-11-BE-T
 (1) FURNISHED BY APADAMS WITH STR-11-10
 (2) WAS SYS 71 FROM TOSTART-10
 (3) CHANGED TO SYS 70 (EP NOS REMAIN THE SAME)

NO.	DATE	DESCRIPTION	BY	CHKD
1	11-15-54	REVISED PER AS-BUILT
2	11-15-54	REVISED PER FIELD VERIFICATION
3	11-15-54	REVISED REVISION 15 PER FIELD DESIGN

NIAGARA MOHAWK POWER CORPORATION
 THREE MILE POINT NUCLEAR STATION UNIT NO. 1
 CLOSED LOOP COOLING - SERVICE
 WATER AND SCREEN WASH
 TURBINE BLDG AND SCREEN HOUSE
 P&ID DIAGRAM
 NONE
 3-N2-515
 C-18022-C


SHEET 2 OF 4

DTM 3346

PDR RIDS

8610090232

8610090232

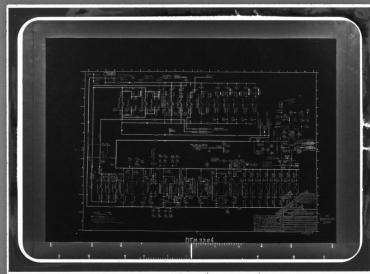

8