


C-18026-C
SHEET #2

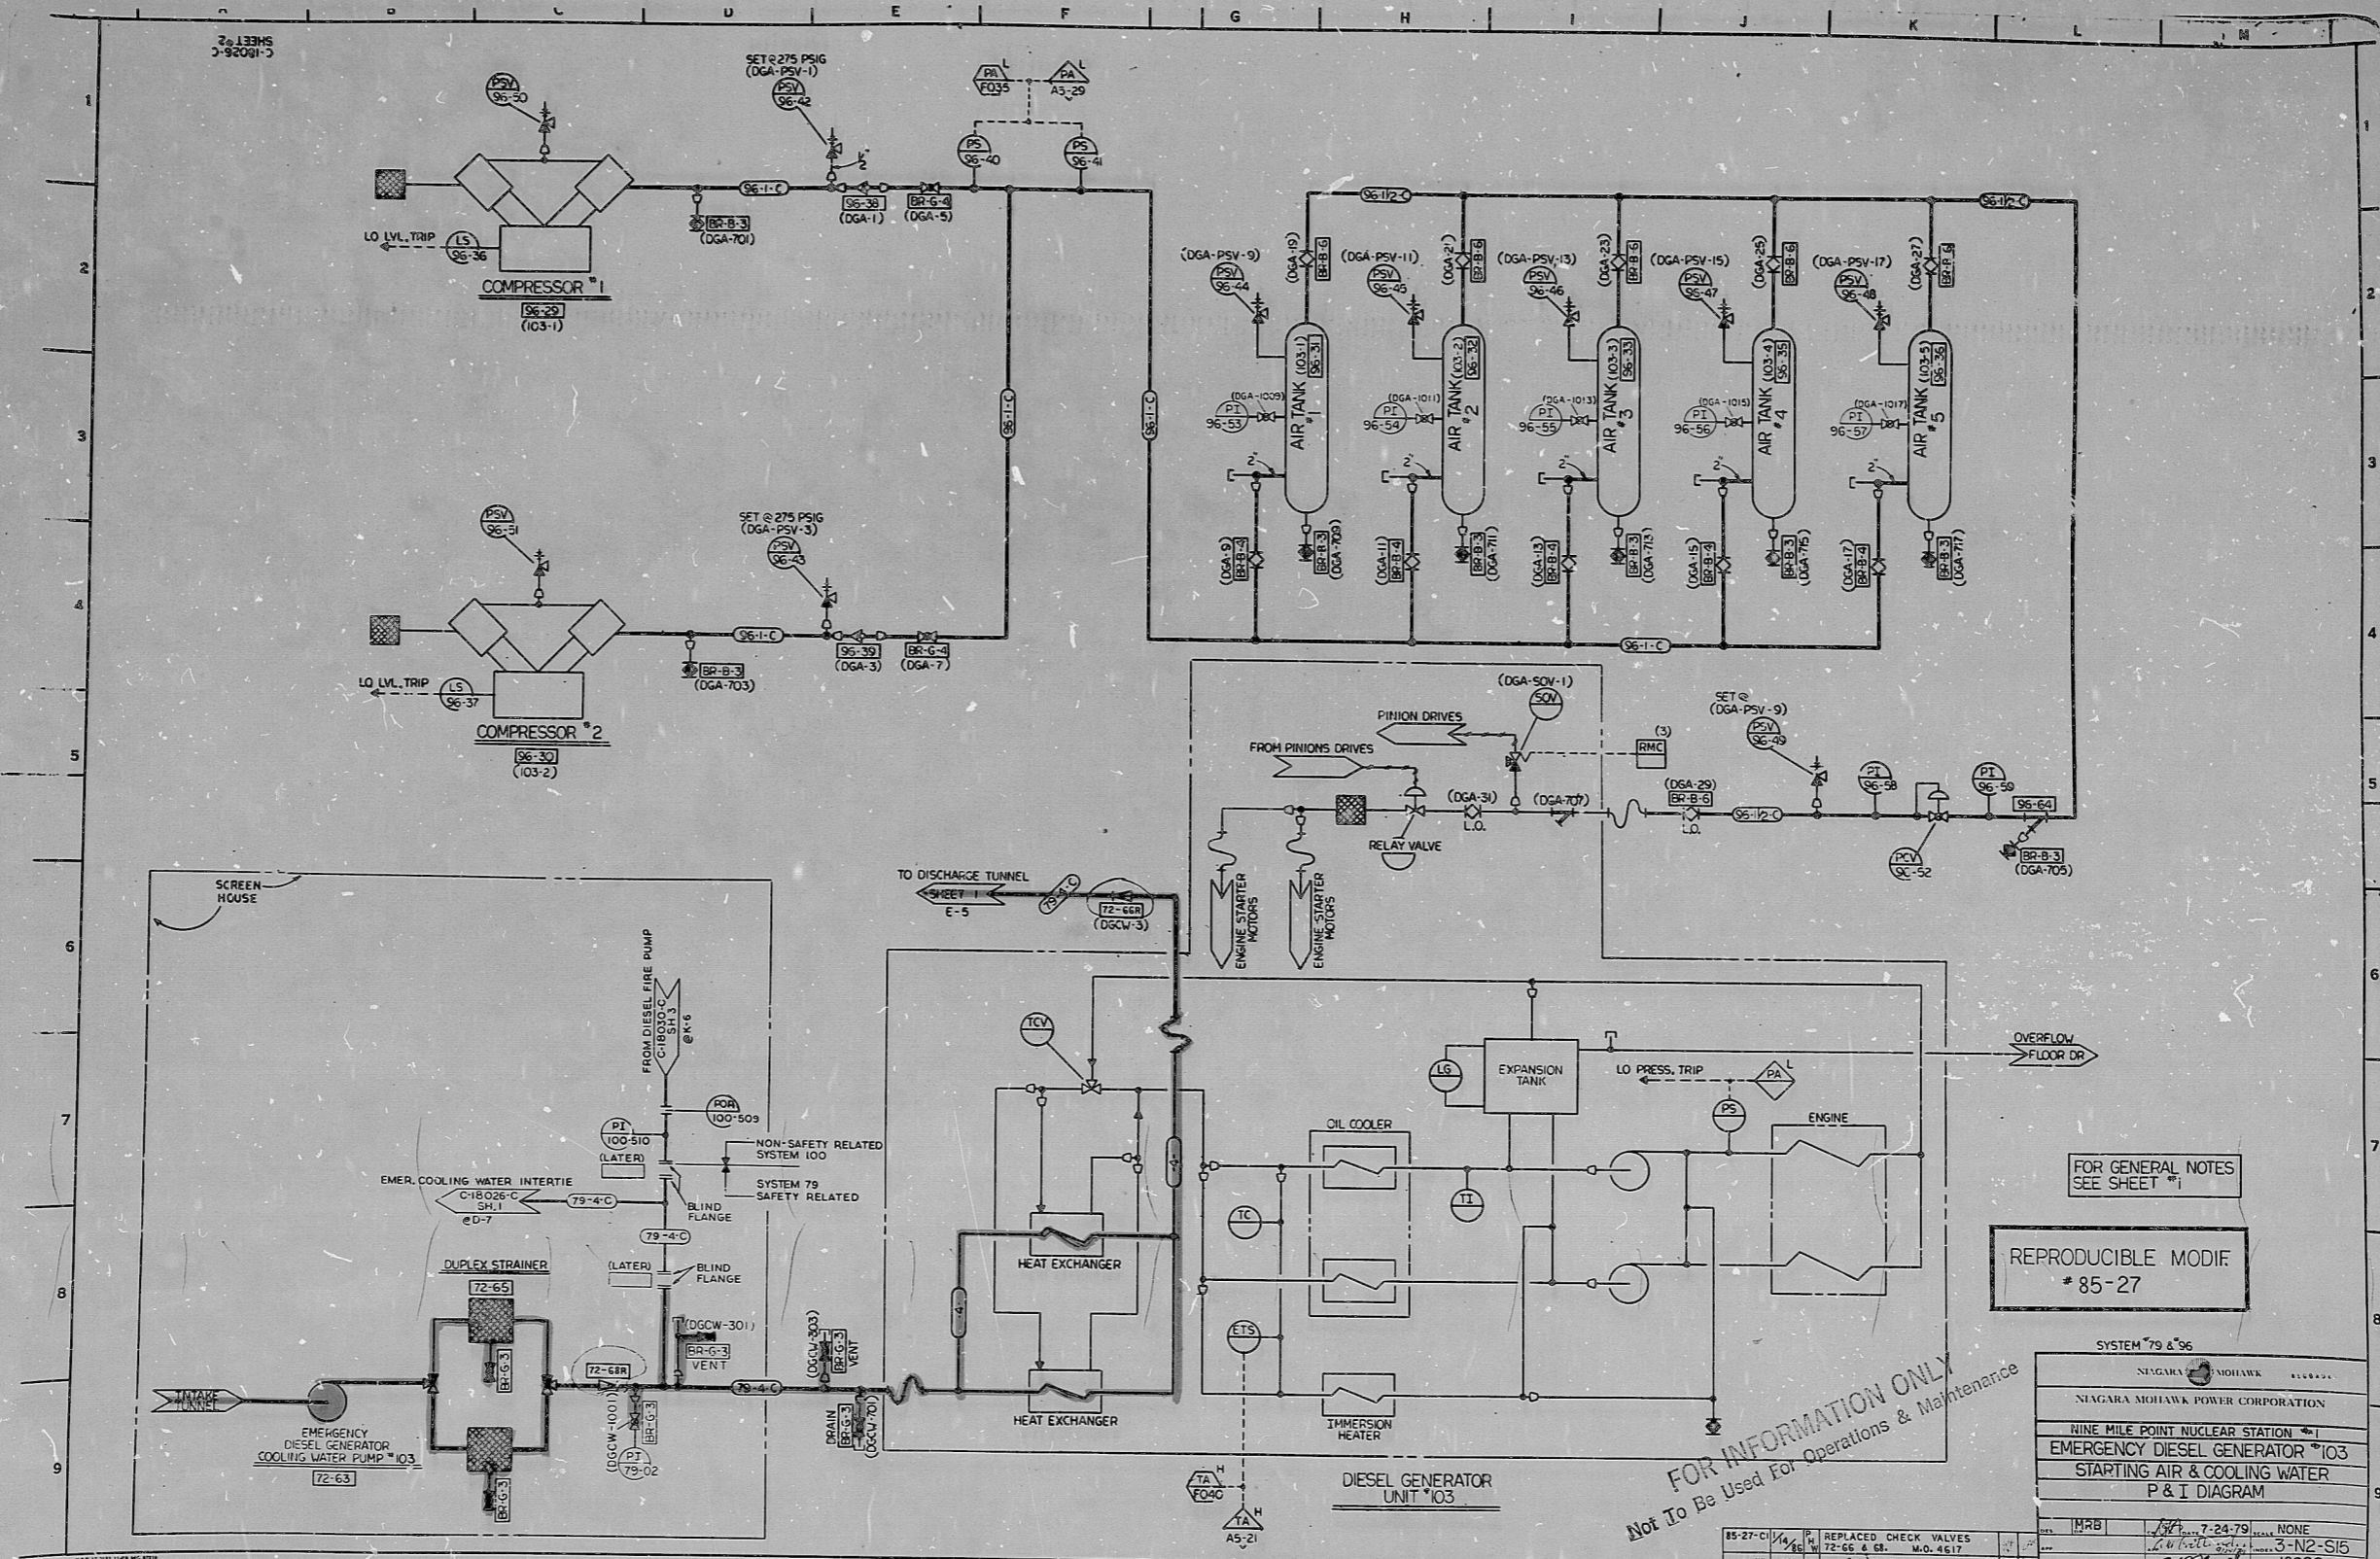

FOR GENERAL NOTES
SEE SHEET #1

REPRODUCIBLE MODIF
85-27

FOR INFORMATION ONLY
Not To Be Used For Operations & Maintenance

SYSTEM 79 & 96	
NIAGARA MOHAWK	
NIAGARA MOHAWK POWER CORPORATION	
NINE MILE POINT NUCLEAR STATION #1	
EMERGENCY DIESEL GENERATOR #103	
STARTING AIR & COOLING WATER	
P & I DIAGRAM	
MRB	7-24-79
3-N2-S15	
C-18026-C	
SHEET #2	

9-MILE Pt. DTM-3442

ATI
APERTURE
CARD

PDR RIDS 8610090260

8610090260

