


C-18027-C
SHEET 2 OF 3

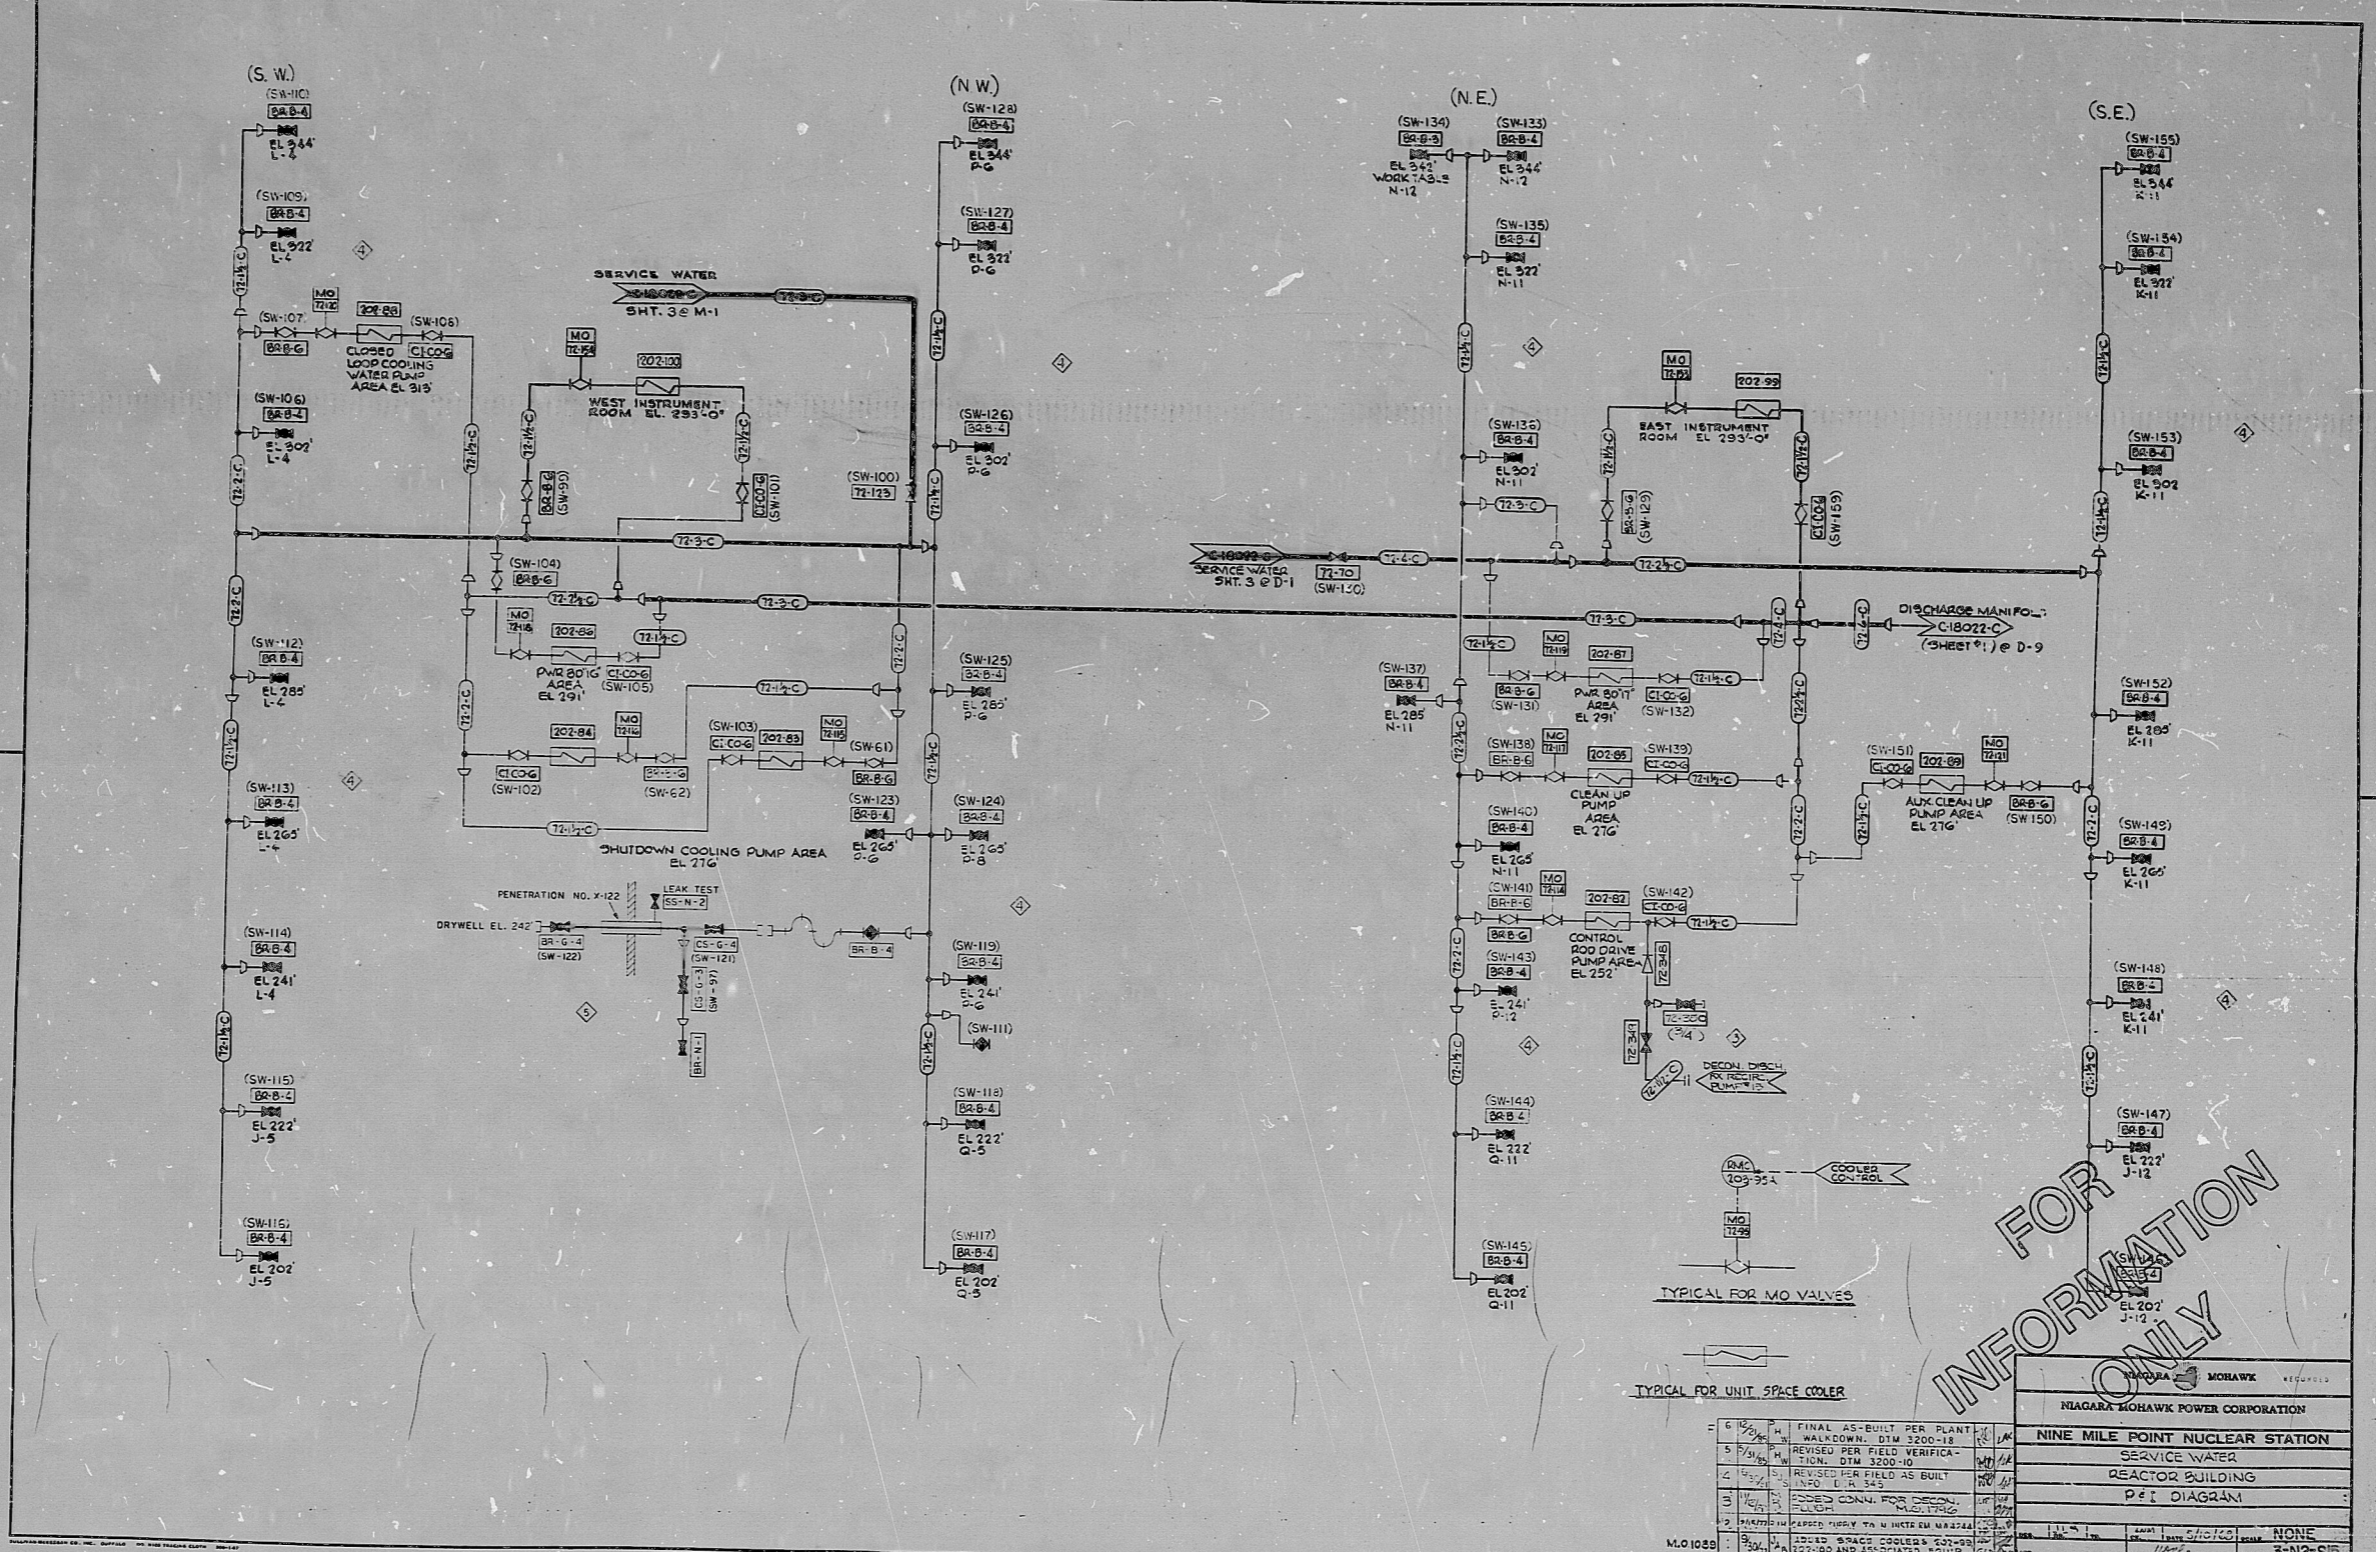

FOR INFORMATION ONLY

TYPICAL FOR UNIT SPACE COOLER

TYPICAL FOR MO VALVES

NO.	DATE	DESCRIPTION OF DESIGN
1		FINAL AS-BUILT PER PLANT WALKDOWN, DTM 3200-18
2		REVISED PER FIELD VERIFICATION, DTM 3200-10
3		REVISED PER FIELD AS-BUILT INFO, DTM 343
MOHAWK	REGISTERED
NIAGARA MOHAWK POWER CORPORATION	
NINE MILE POINT NUCLEAR STATION	
SERVICE WATER	
REACTOR BUILDING	
P&I DIAGRAM	
DATE	3-12-81
BY	3-N2-S16
NO.	C-18027-C
SHEET 2 OF 3	

TI APERTURE CARD

9-MILE PT. DTM-3200-18

PDR RIDS 8610090268

8610090268

