


C-18029-C

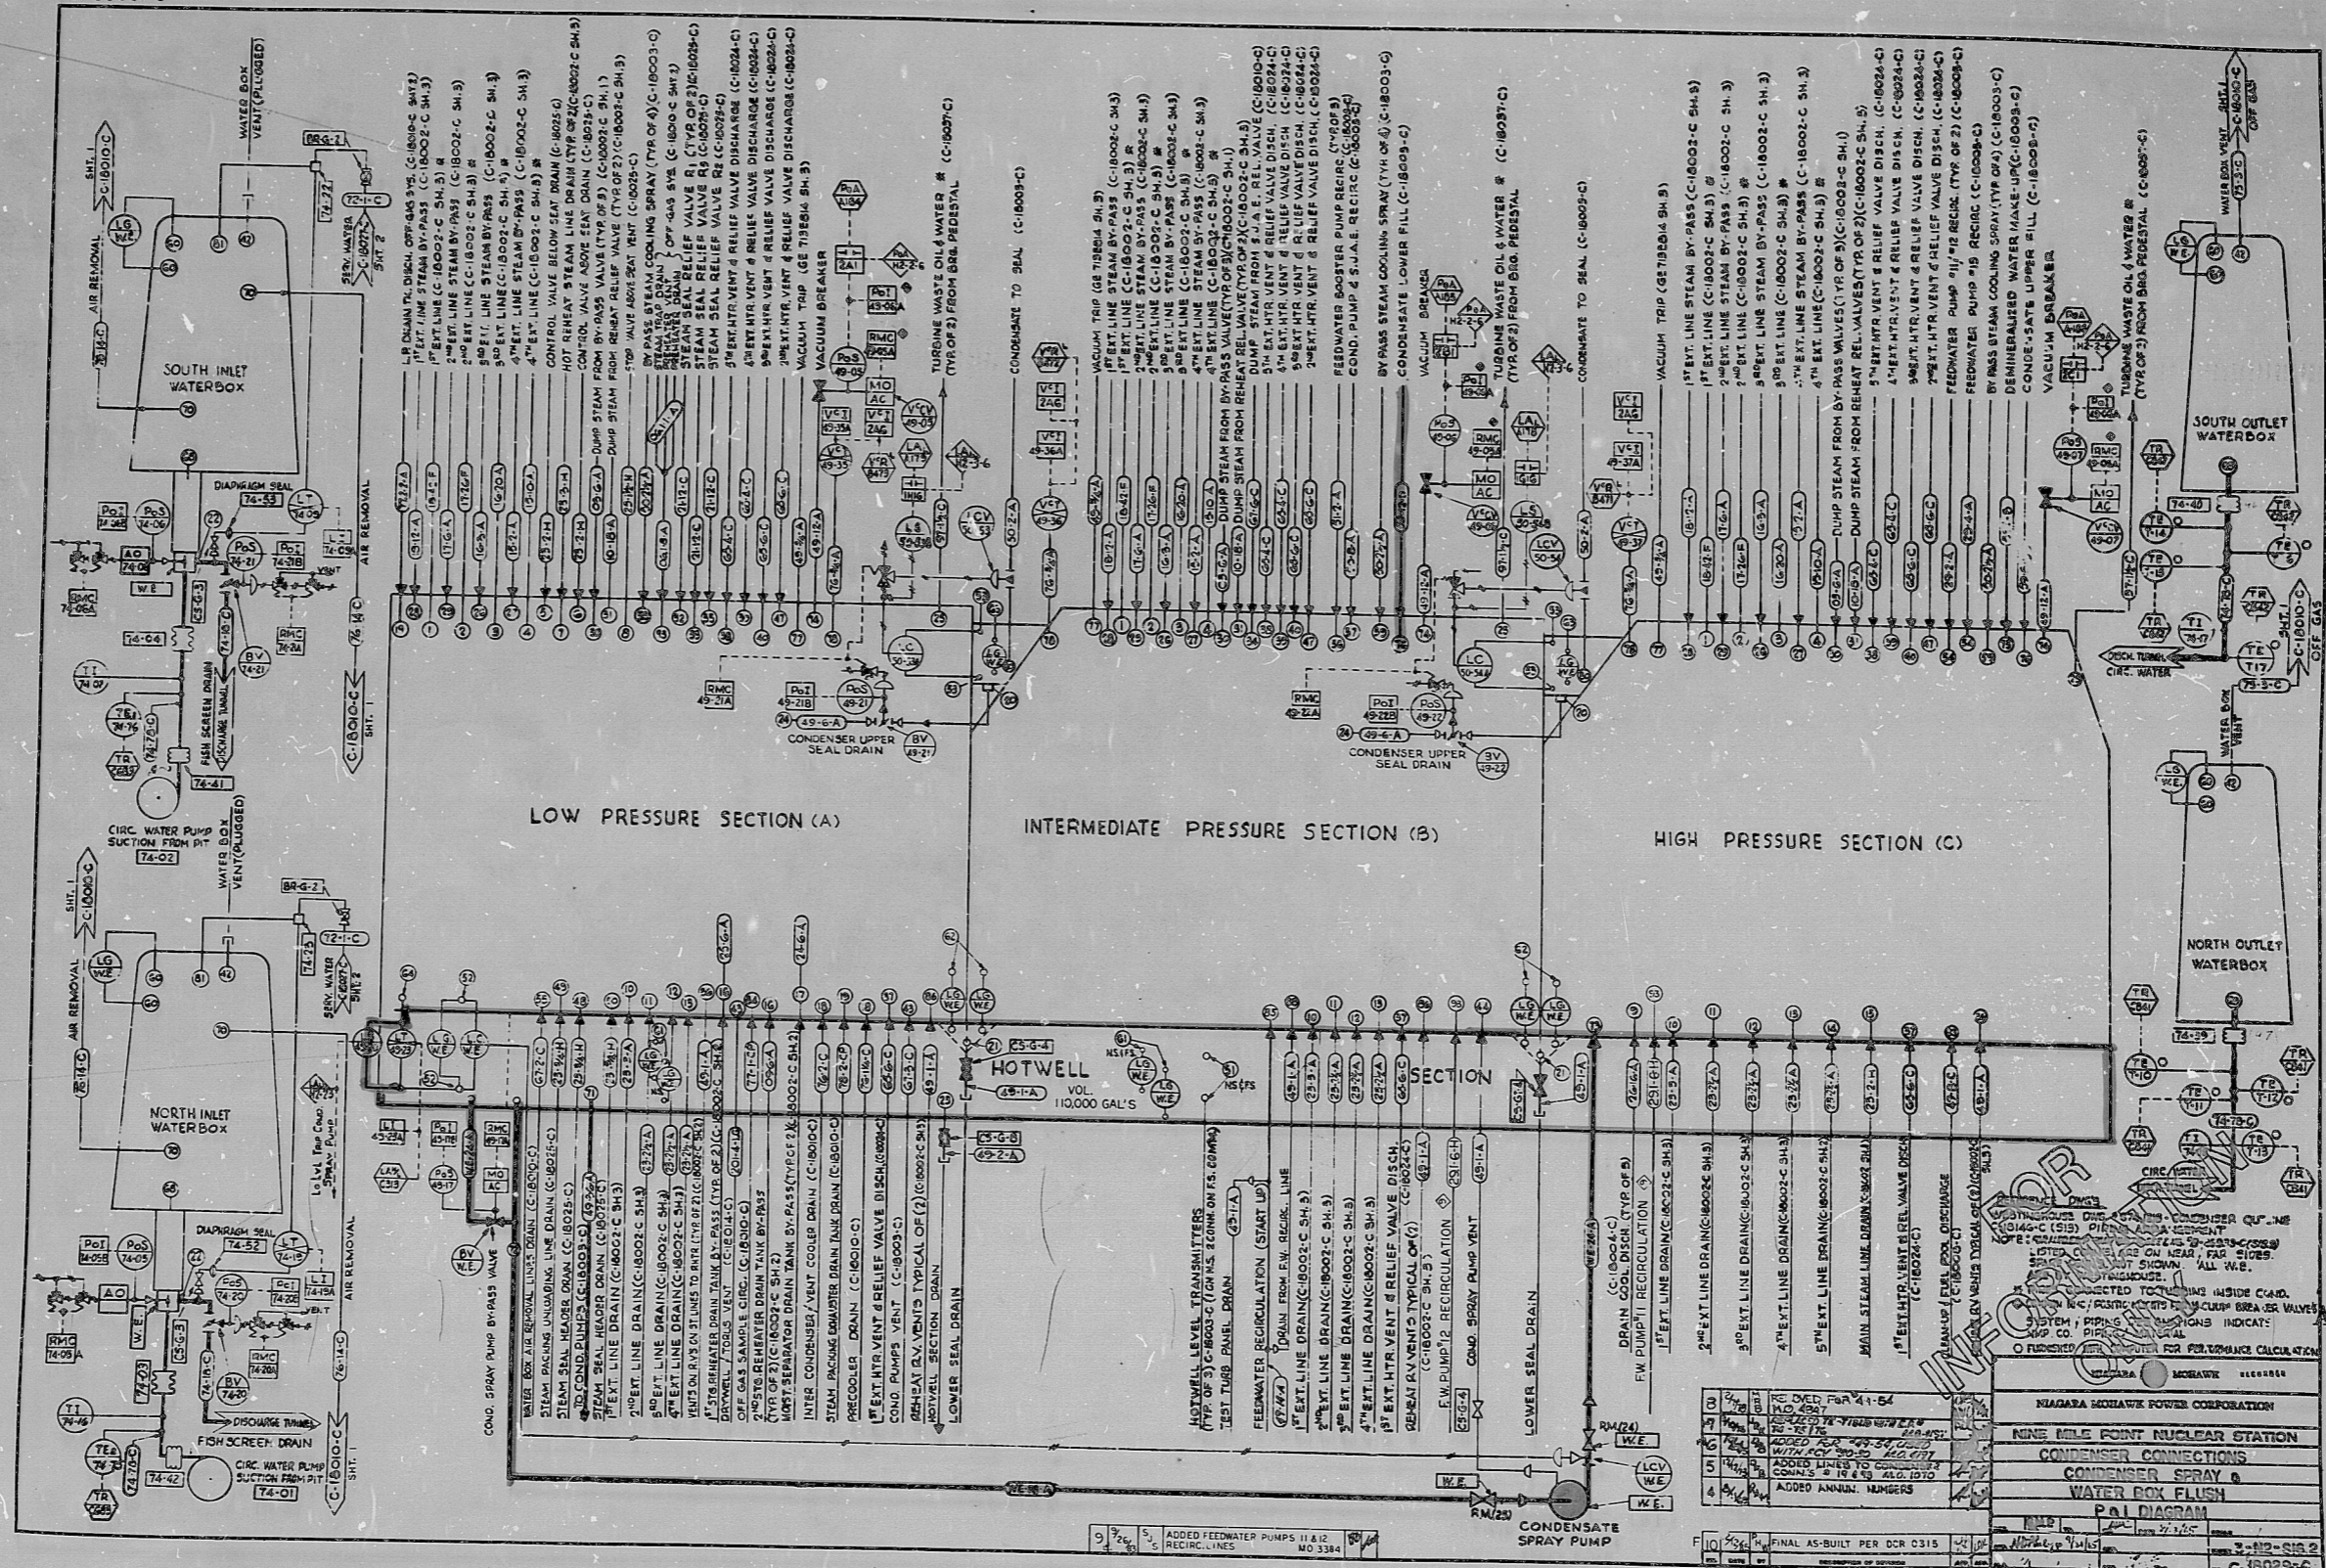

DTM-3412
30X

TI
APERTURE
CARD

PDR RIDS 8610090277

8610090277

