



GENERAL NOTES:

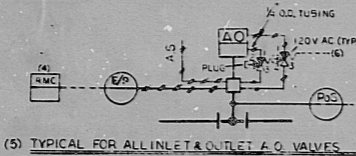


REPRODUCIBLE MODIF #83-65

- (1) LOCATED ON CONDENSATE DEMINERALIZER RESIN REGENERATION & TRANSFER CONTROL PANEL DWS C-22100-C (EXCEPT AS NOTED)
- (2) ALL NEW PANEL MOUNTED EQUIP (EXCEPT AS NOTED) ON NEW CONDENSATE DEMINERALIZER PANEL DWS
- (3) DE-ENERGIZE TO LOCK VALVE IN POSITION ON POWER FAILURE. RESET TO ENERGIZE AND POSITION ON CONDENSATE DEMINERALIZER PANEL
- (8) LOCATED ON RESIN TRANSFER & REGEN. CONTROL PANEL

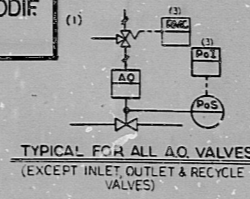

FOR INFORMATION ONLY
 Not To Be Used For Operations & Maintenance

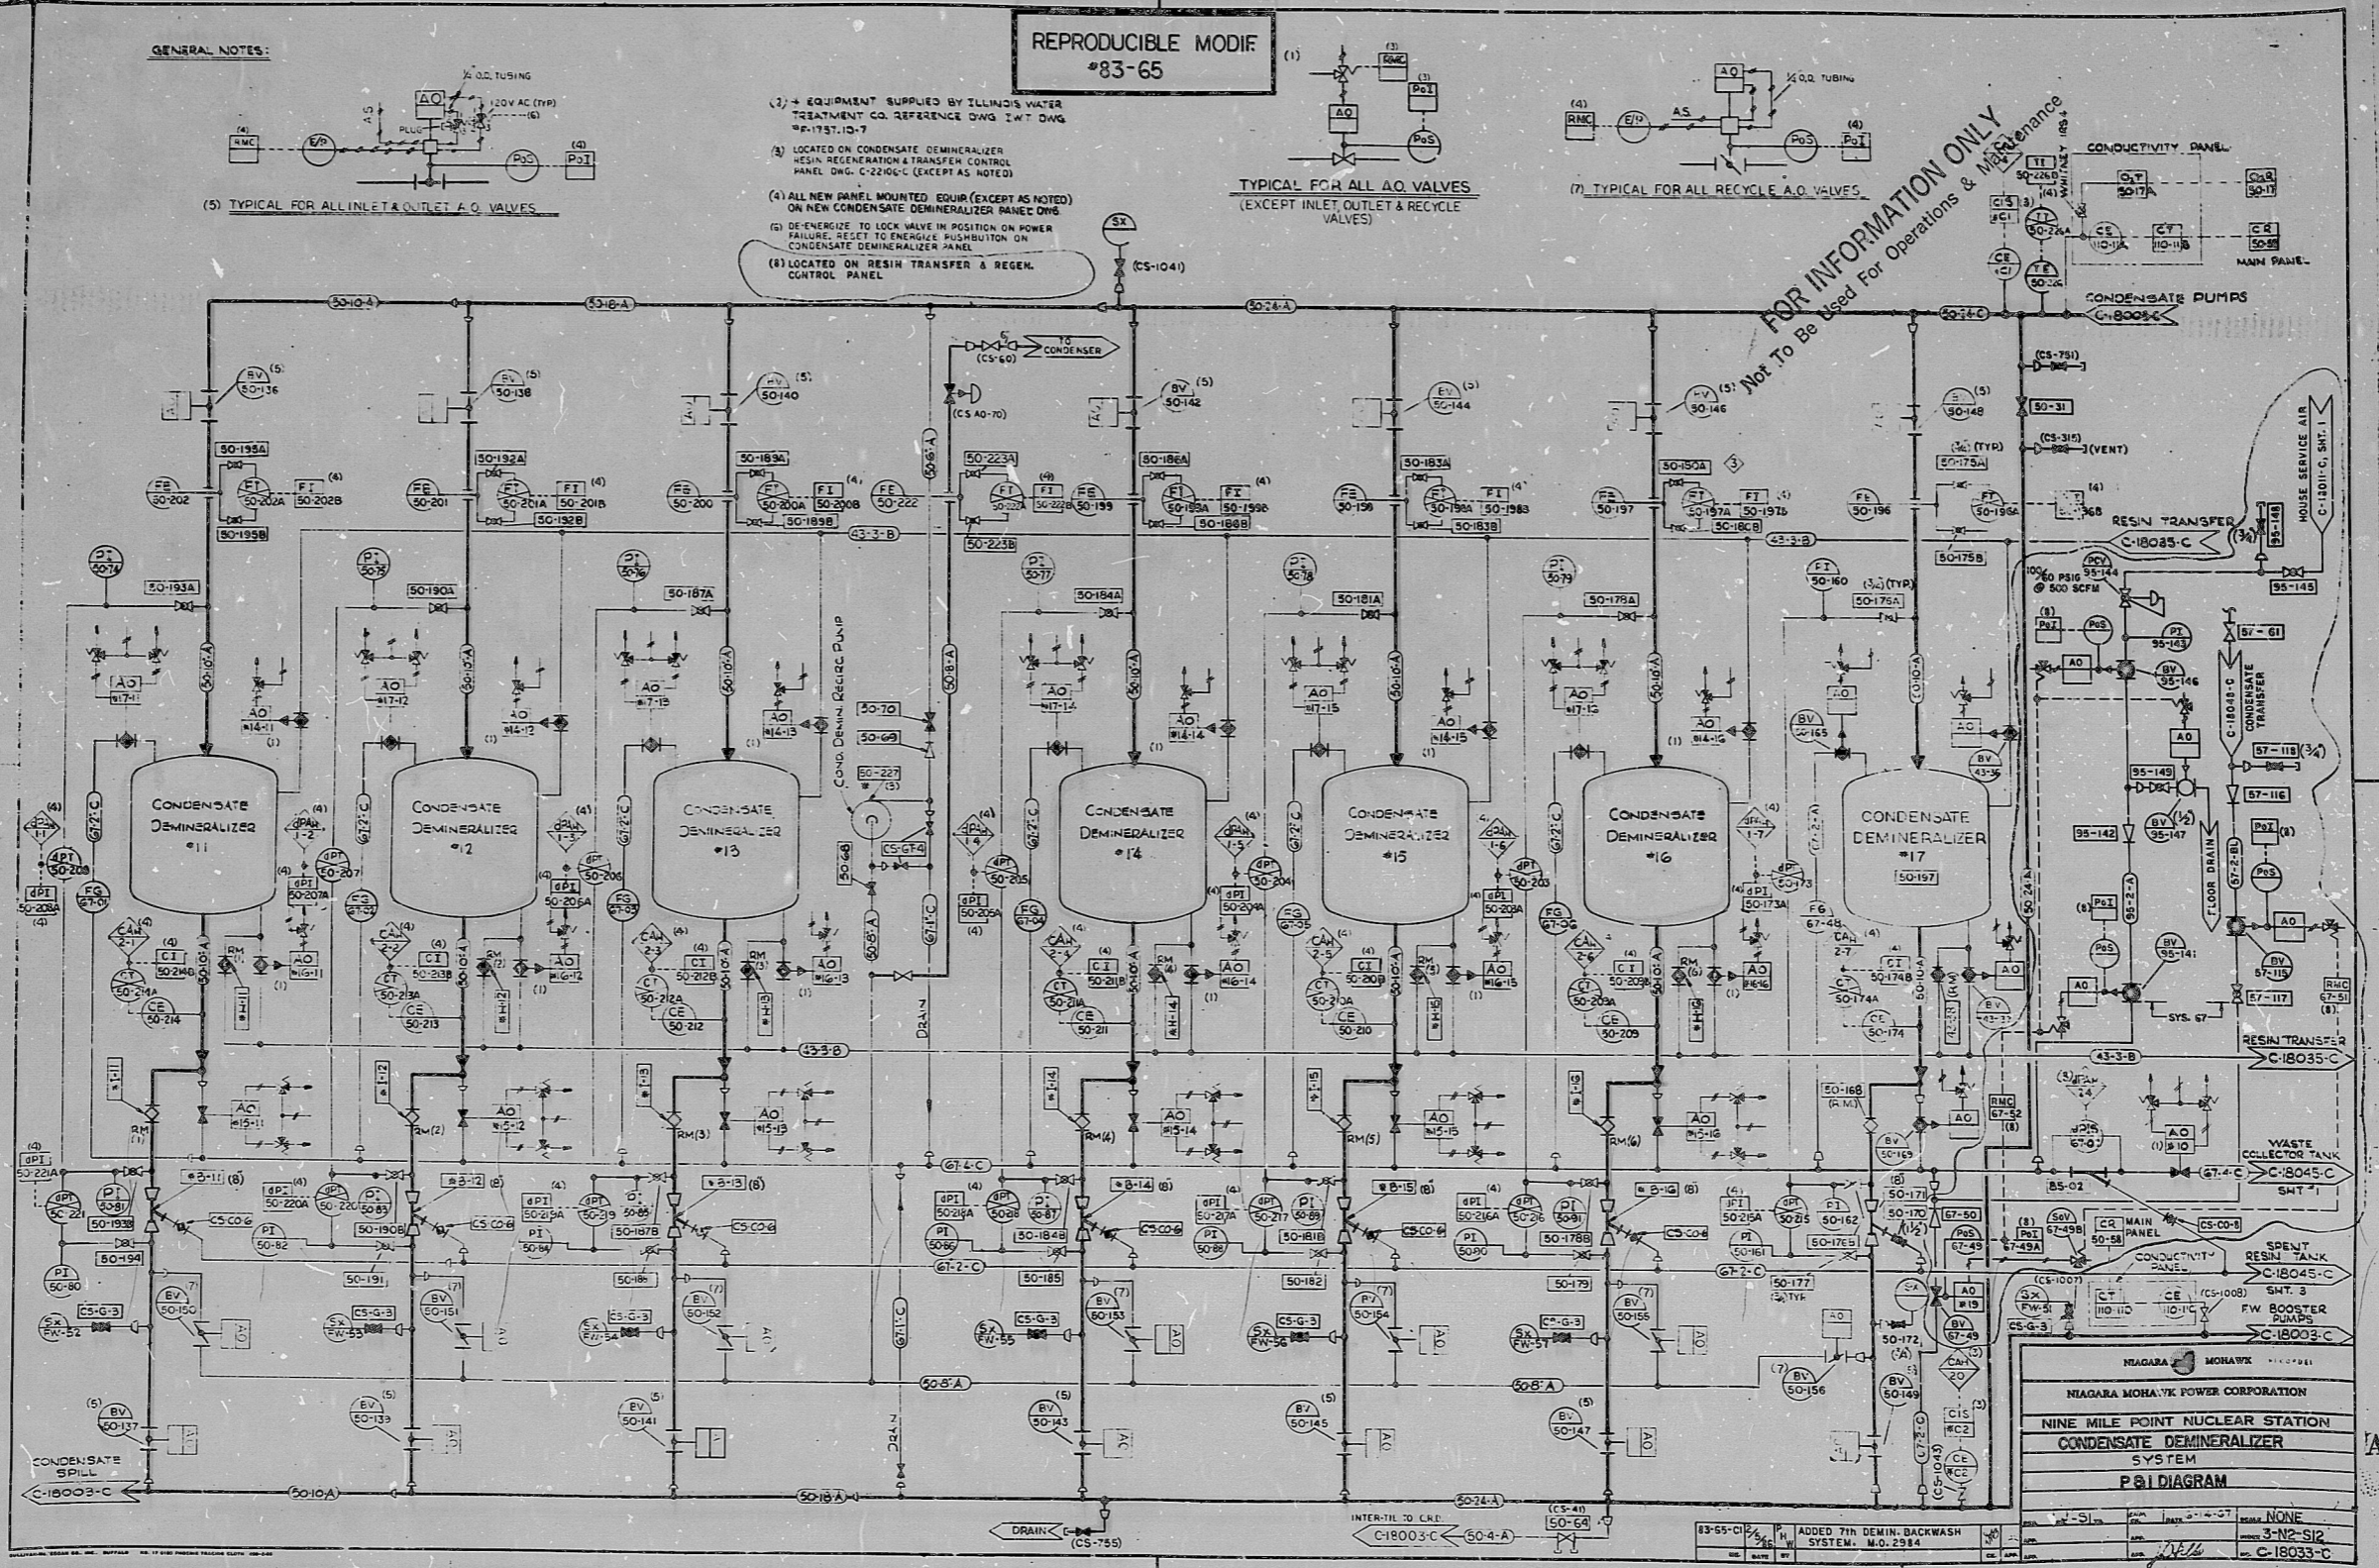

NIAGARA MOHAWK POWER CORPORATION	
NINE MILE POINT NUCLEAR STATION	
CONDENSATE DEMINERALIZER SYSTEM	
P & I DIAGRAM	
REV	DESCRIPTION
1	ADDED 7TH DEMIN. BACKWASH SYSTEM, M.O. 2984
2	
3	
9-MILE PT. DTM-3464

TI APERTURE CARD

PDR RIDS 8610090279

8610090279

