


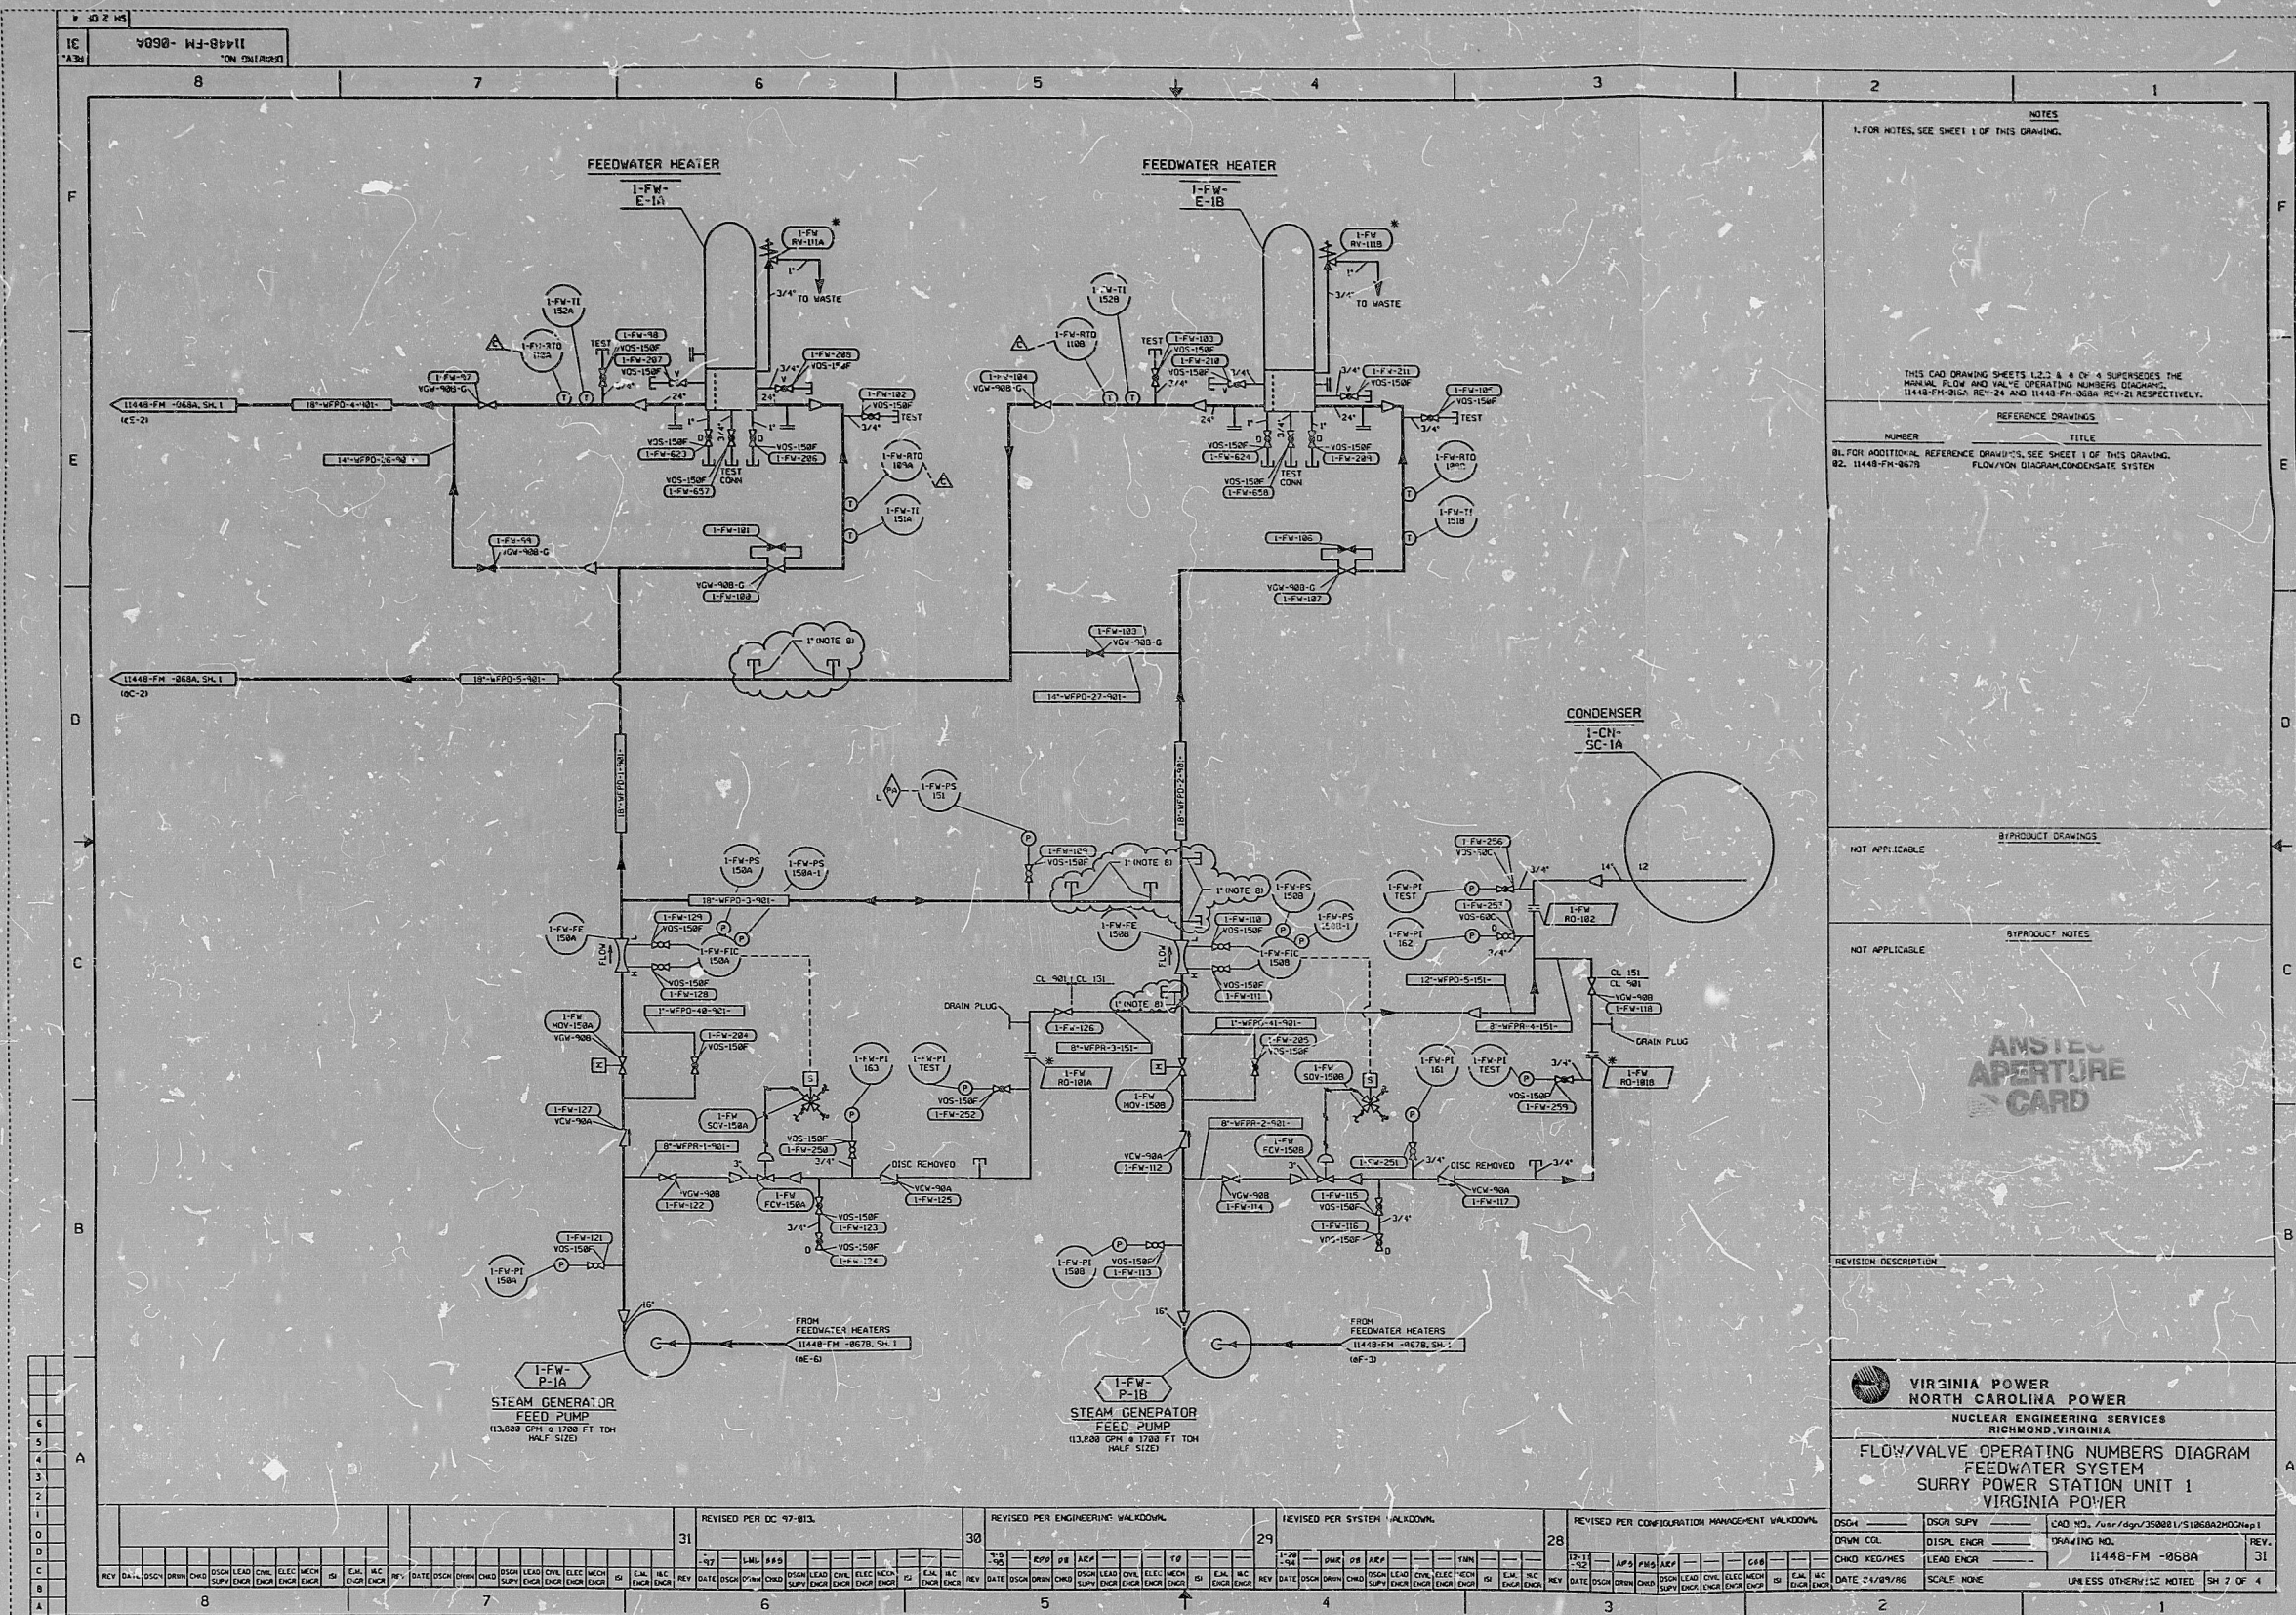

[DIMMER]YR
13-APR-1997 18:38
/usr/dgn/358081/S10E8A2MO2Nep1

9803250218

PDR RIDS

9803250218

