


(NRC/FYI) THIS PRINT VOID 24 HRS AFTER 02/06/98 03:35PM

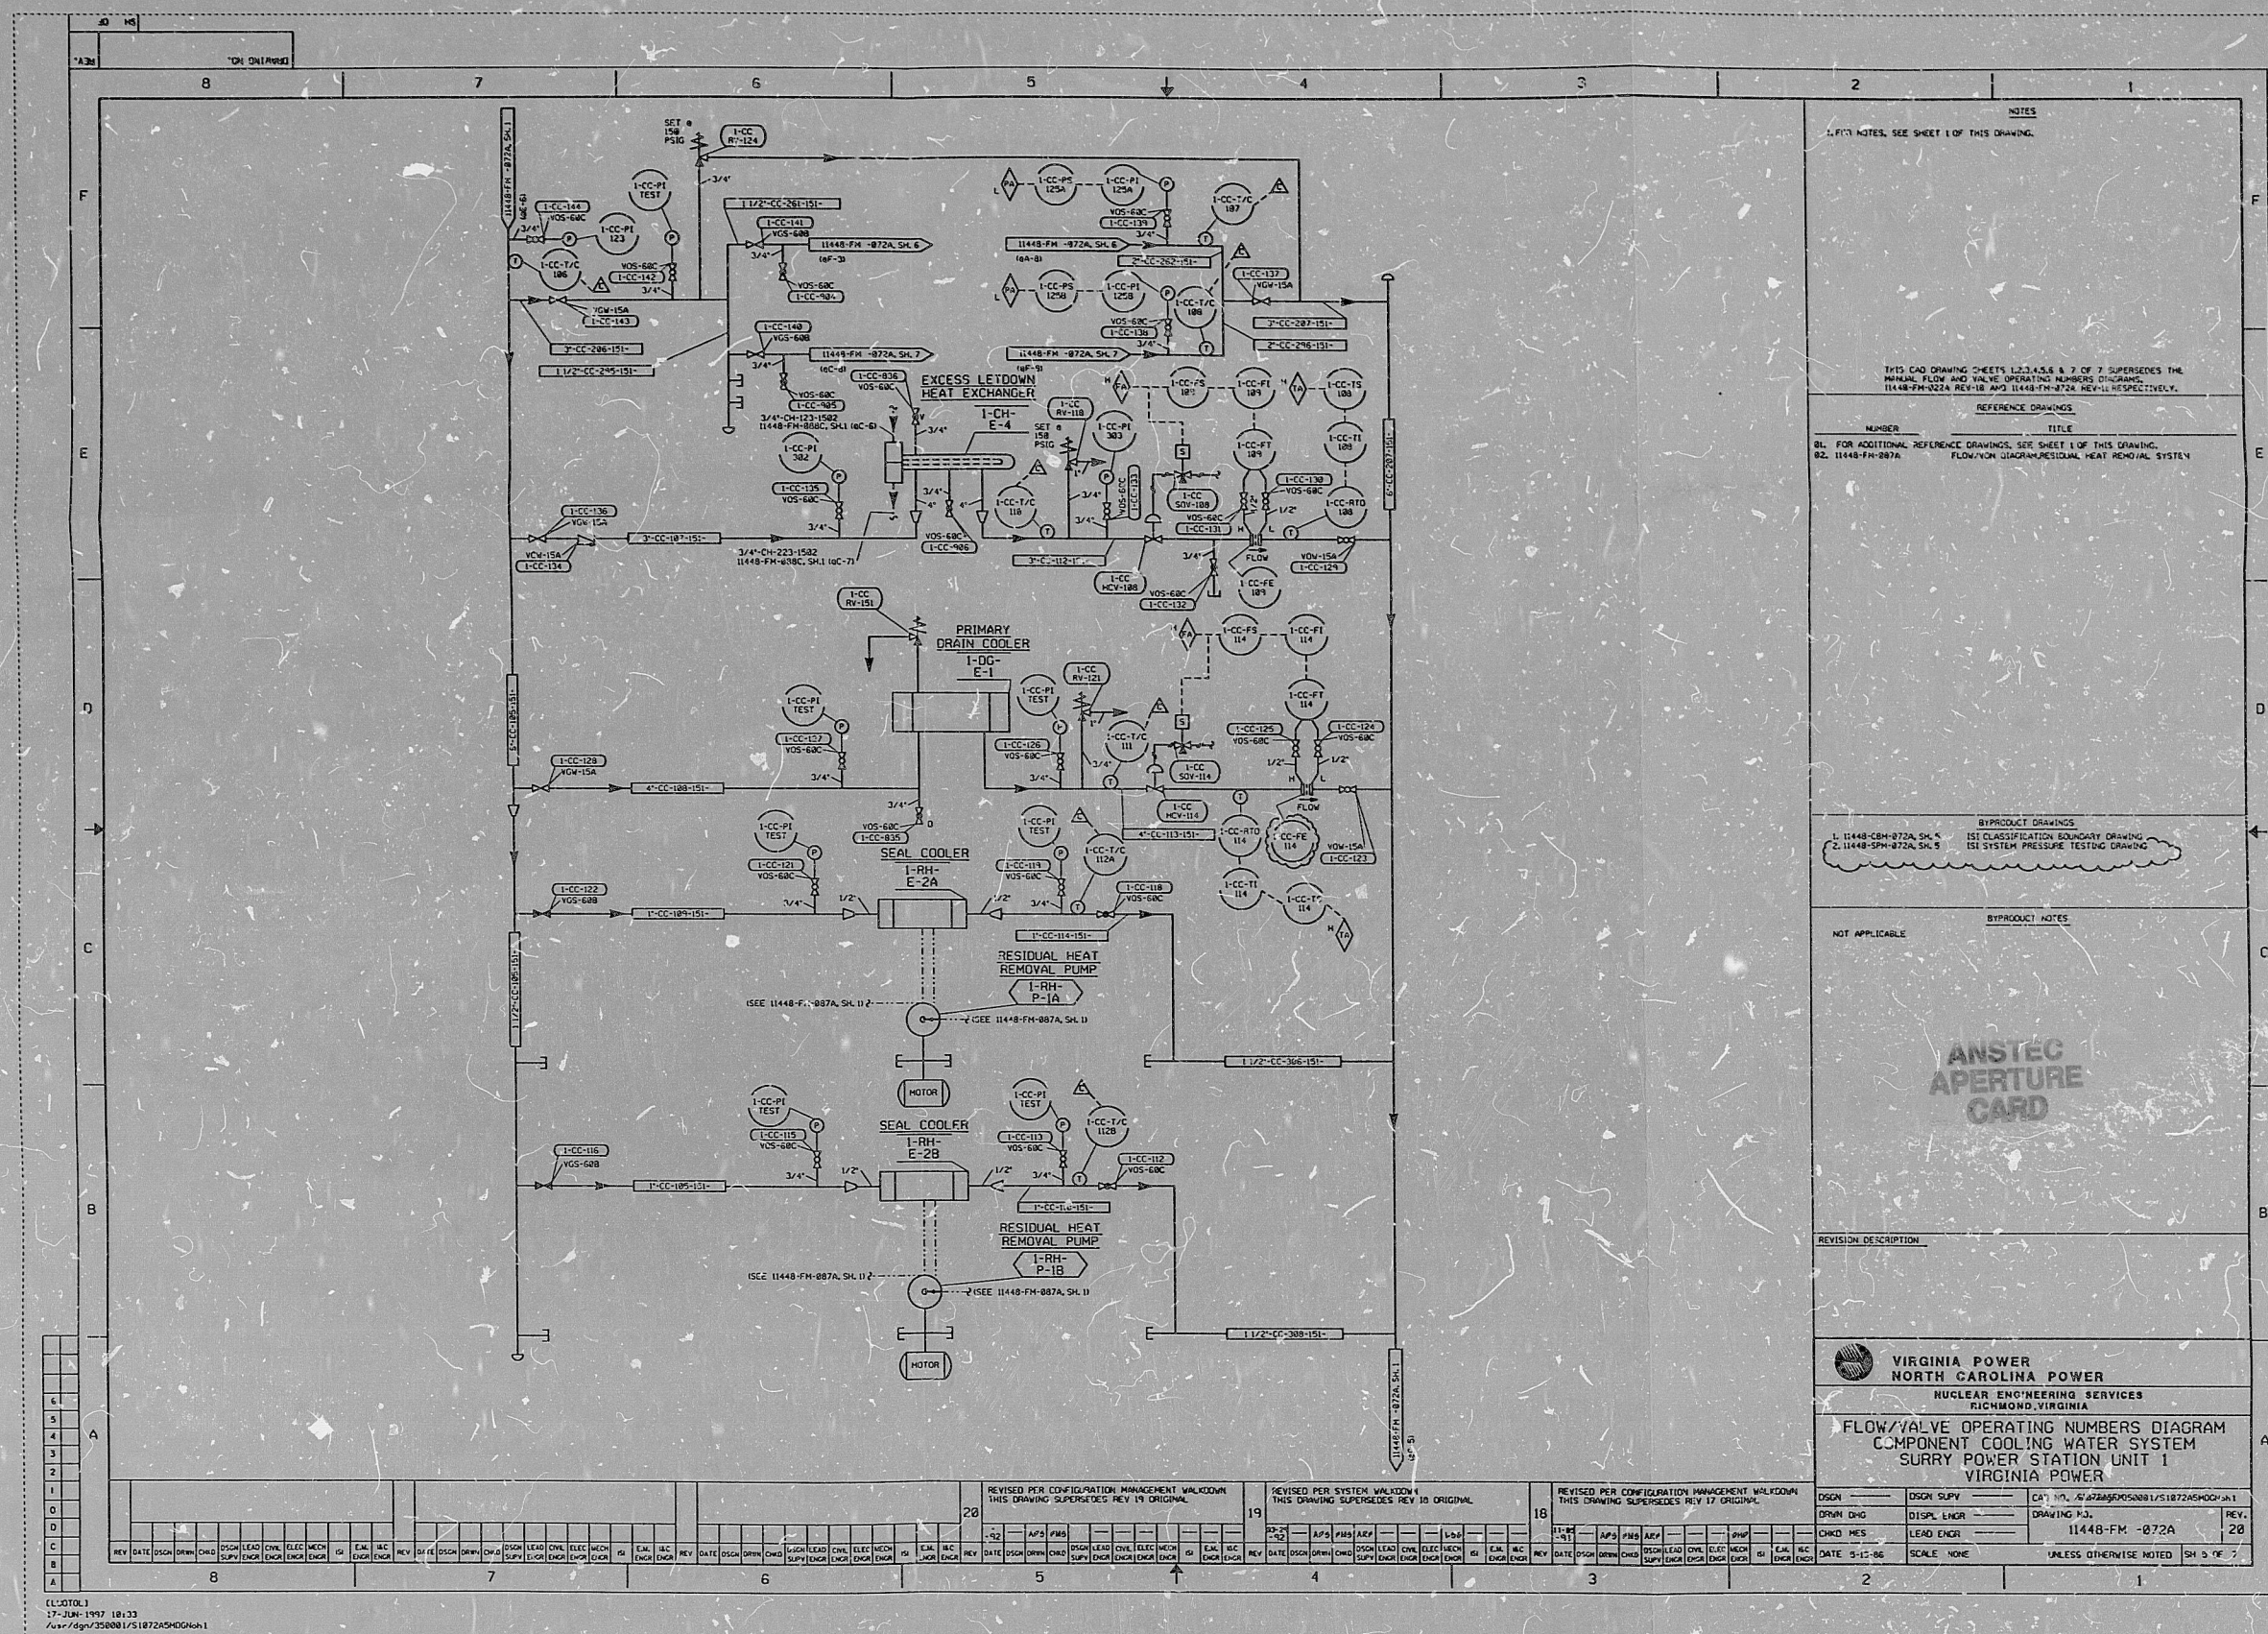

9803250261

PDR RIDS

9803250261

