


NOTES  
 1. SEE C-18022-C SH-3 FOR ER N8

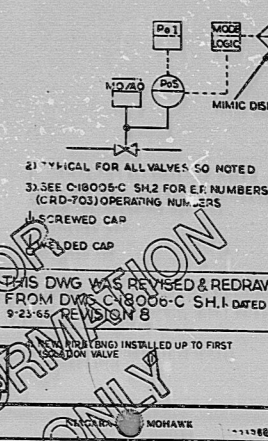

- 2. TYPICAL FOR ALL VALVES, SO NOTED
- 4. SCREWED CAP
- 5. WELDED CAP
- 7. MODIFICATION IN PROGRESS (REPRODUCIBLE EXISTS)

NO.	DATE	DESCRIPTION	BY	CHKD.

NIAGARA MOHAWK POWER CORPORATION	
NINE MILE POINT NUCLEAR STATION UNIT NO. 1	
DRYWELL & TORUS ISOLATION VALVES	
P&I DRAWING	
REVISED	10-20-66
BY	MS
CHKD.	MS
DATE	10-20-66
SCALE	NONE
PROJECT	C-18005-C
SHEET 10F-3	

9-MILE PT. DTM 3200-19

TI APERTURE CARD

8610090423

PDR RIDs

8610090423

