
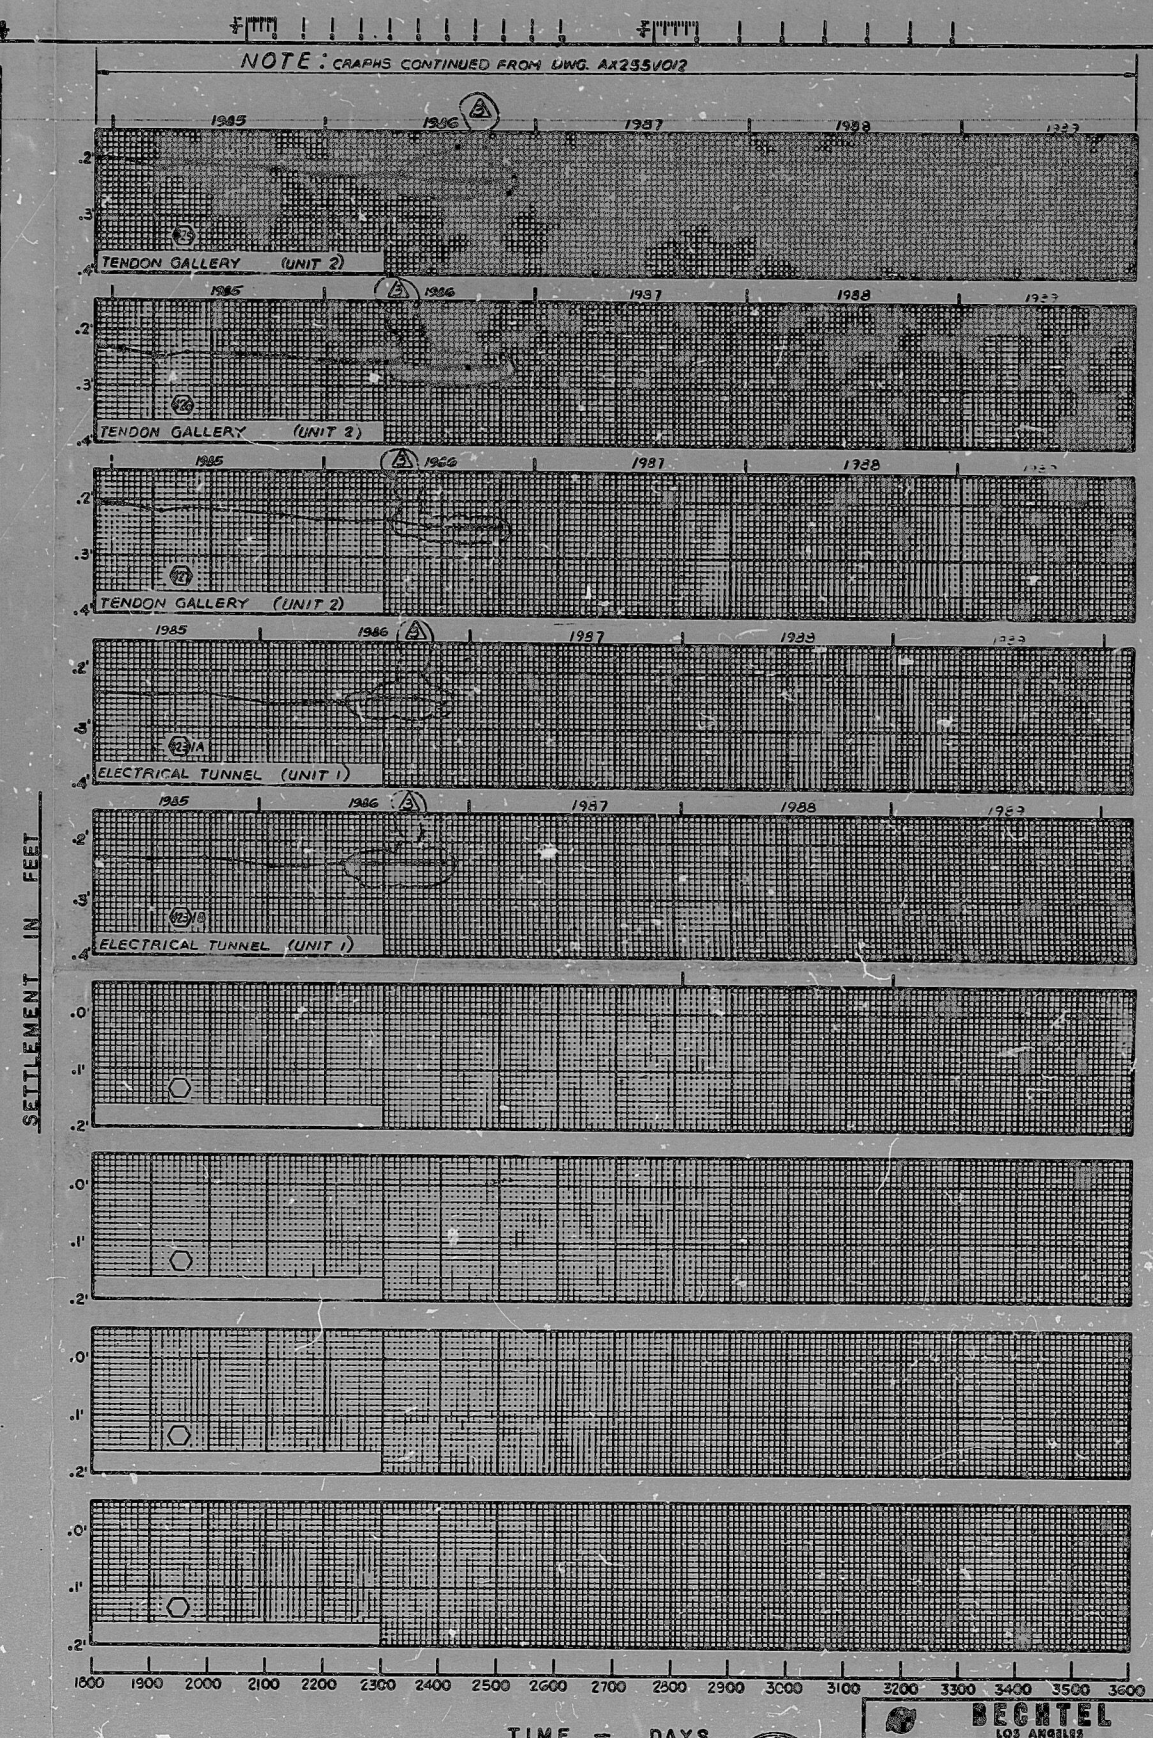


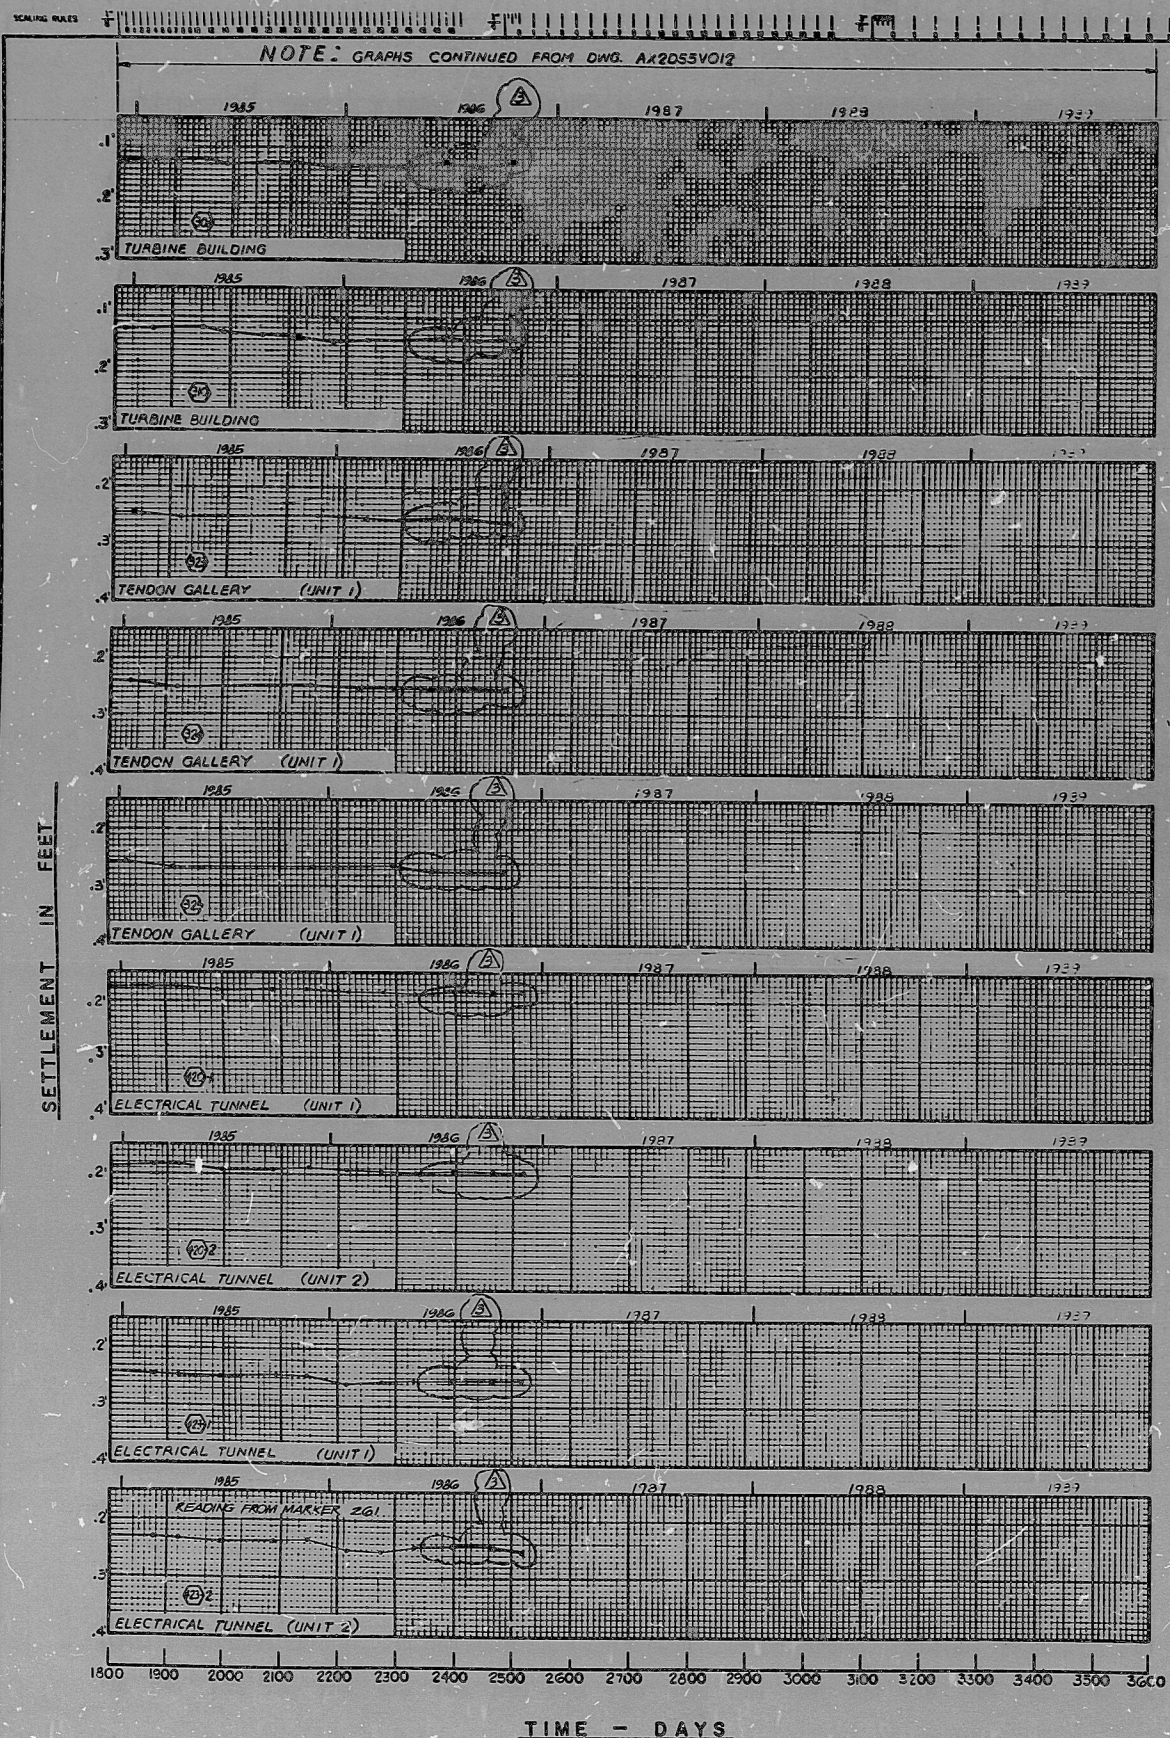

REV.	DATE	BY	CHK	APP	REV.	DATE	BY	CHK	APP
1					1				
2					2				
3					3				
4					4				
5					5				
6					6				
7					7				

BECHTEL
LOS ANGELES

GEORGIA POWER COMPANY
ALVIN W. VOGTLE NUCLEAR PLANT

SETTLEMENT OBSERVATION MARKERS
GRAPHS SHEET 7A

SCALE: NONE

DRAWING NO. AX255V028

REV. 3

TI
APERTURE
CARD

8706050343

PDR RIDS

