


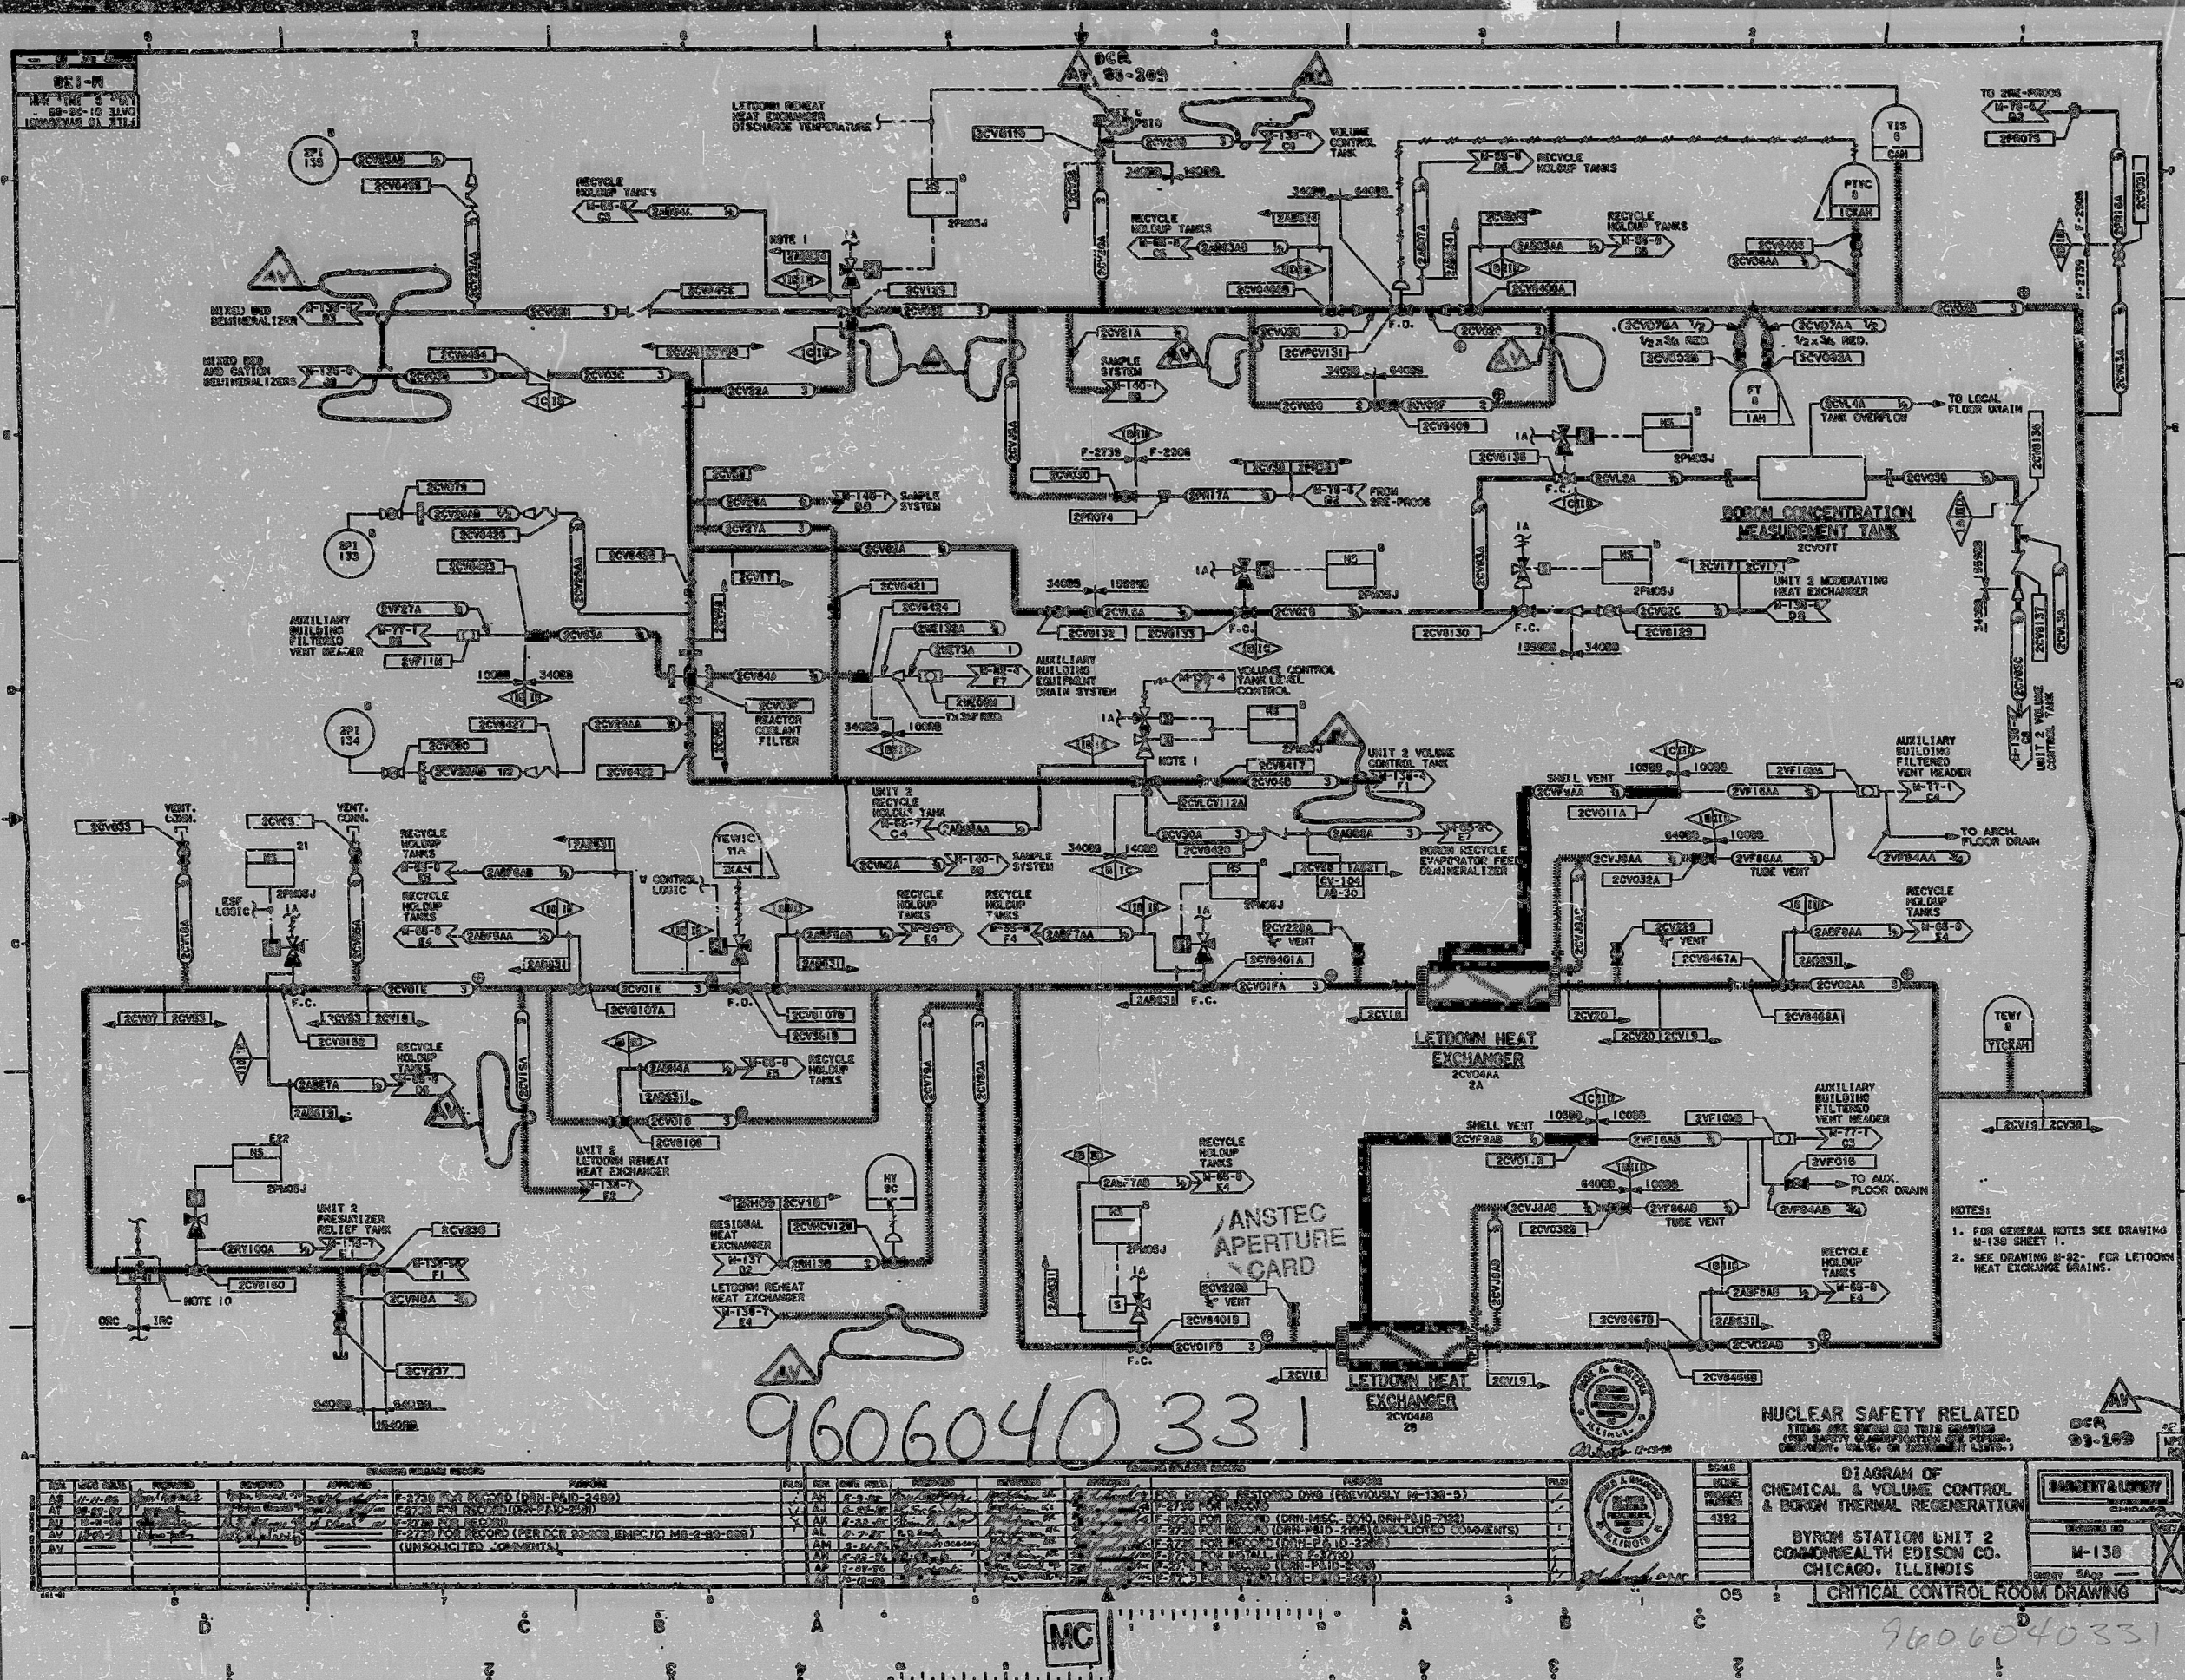

ITEM	DATE	REVISION	APPROVED	REASON

NUCLEAR SAFETY RELATED
ITEMS ARE SHOWN ON THIS DRAWING

DIAGRAM OF
CHEMICAL & VOLUME CONTROL
BYRON STATION UNIT 2
COMMONWEALTH EDISON CO.
CHICAGO, ILLINOIS

9606040 331
M-130
CRITICAL CONTROL ROOM DRAWING

PDR RIDS

9606040331

