


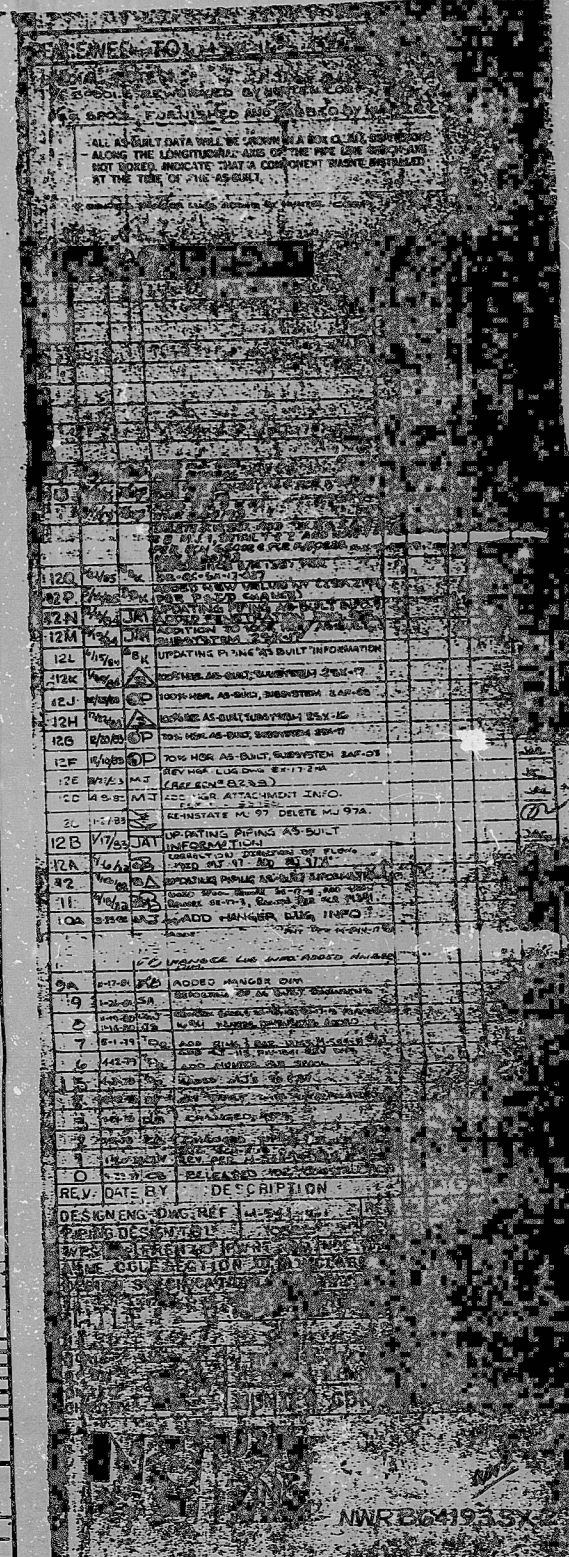

- FIVE PAGE DRAWS
- 2nd CONNECTIONS 4/10/2

[illegible]

9606040383 / AMT-50
APERTURE 9606040383
CARD

PDR RIDS

9606040383

