



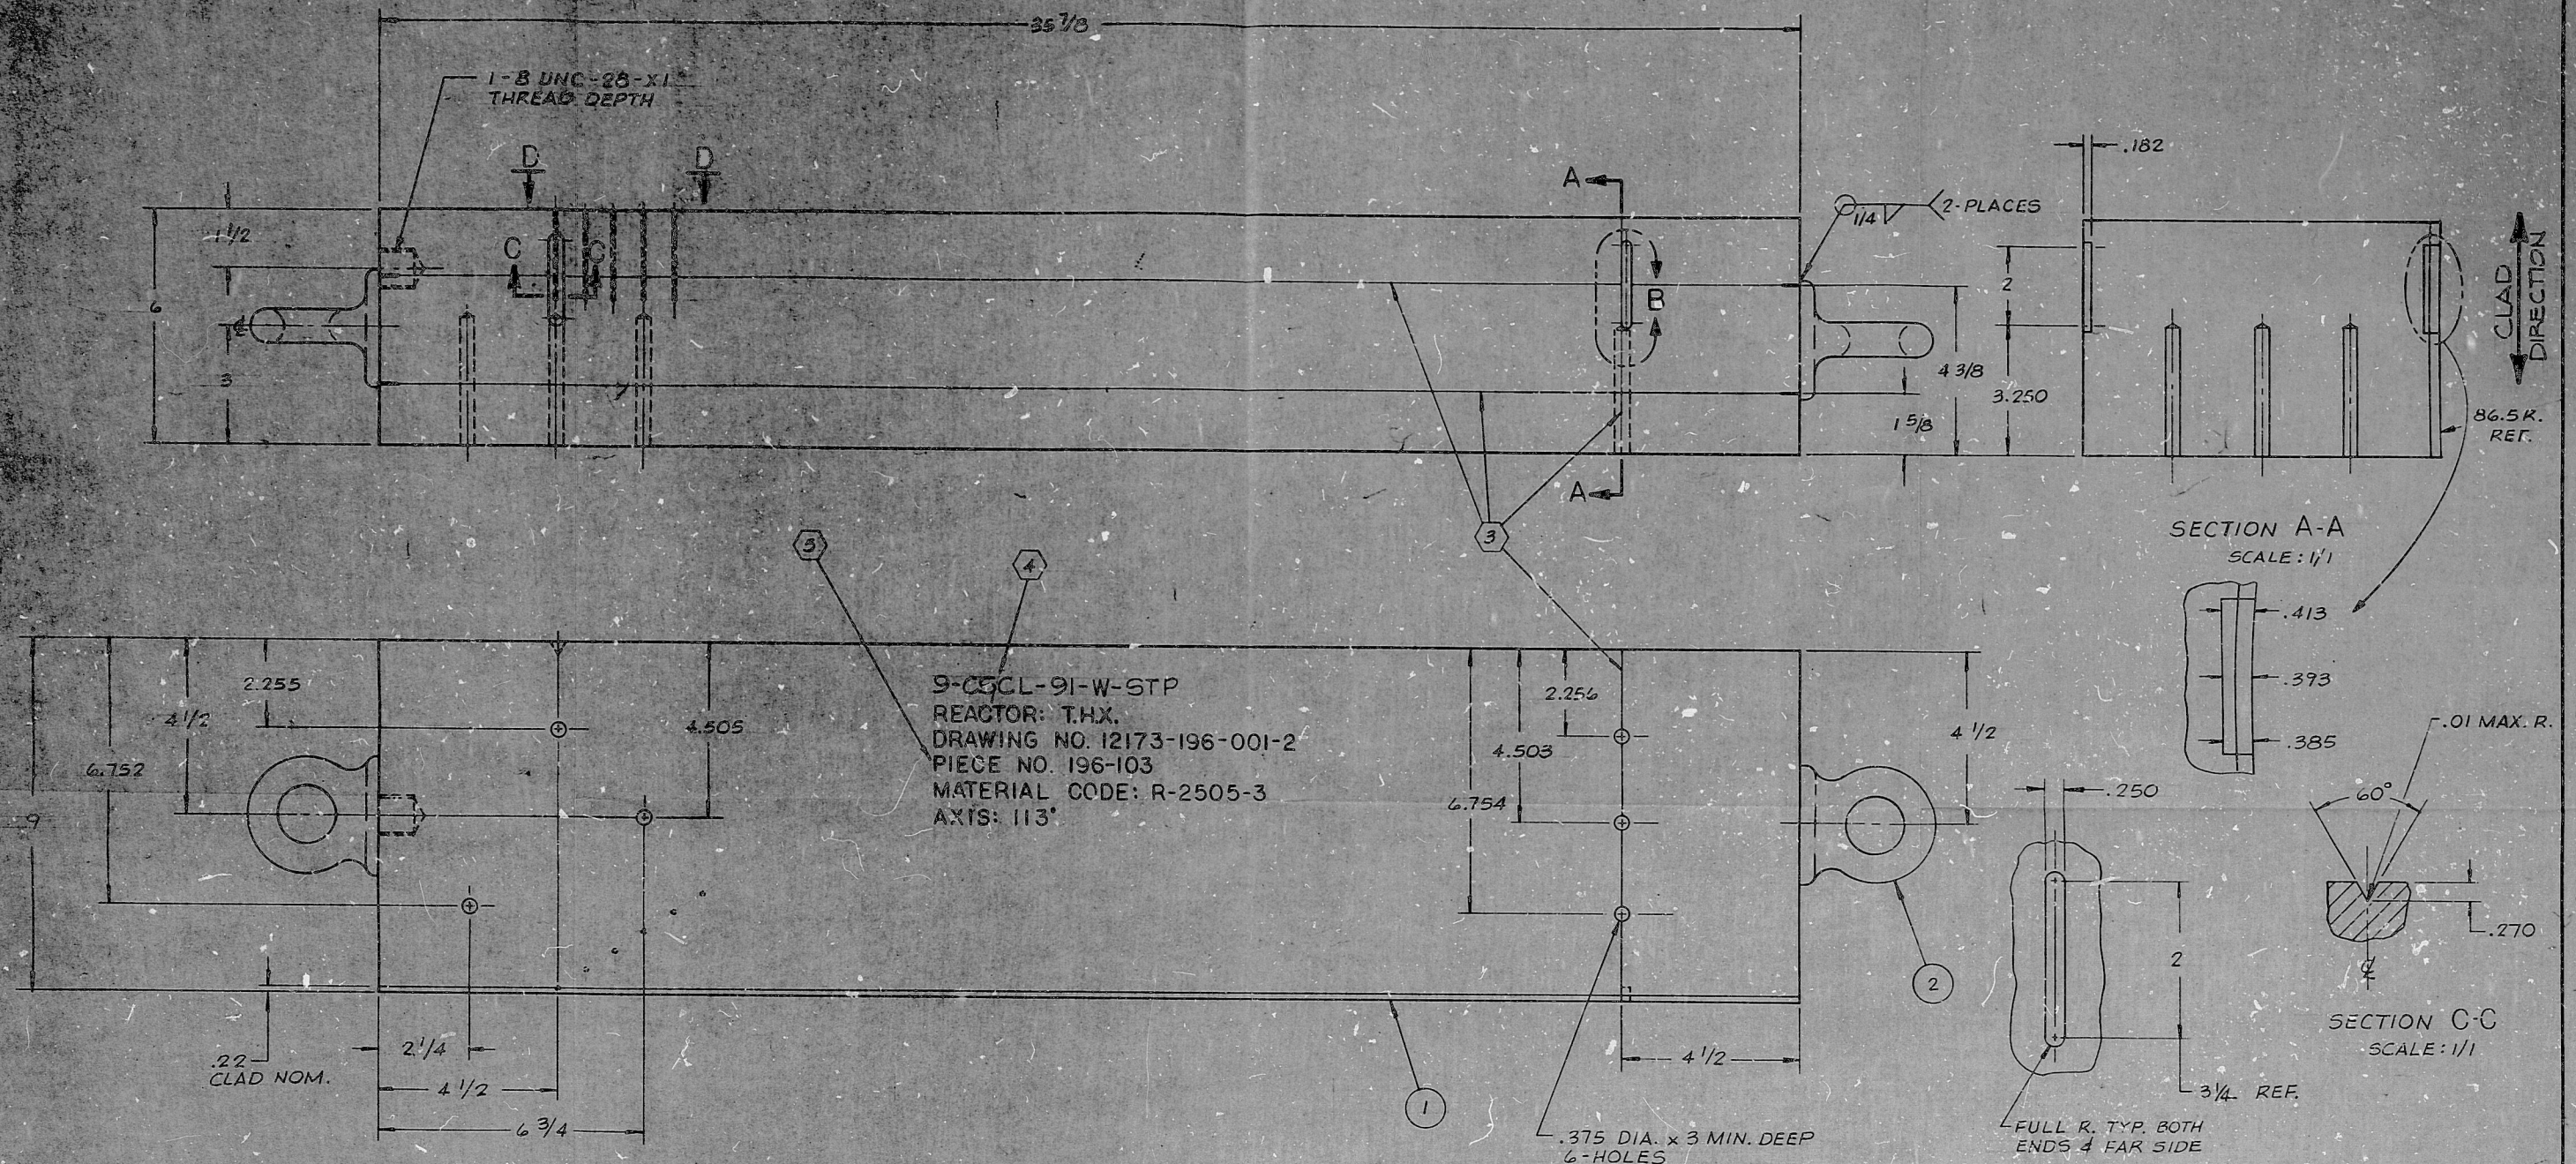

NOTES:

1. DIMENSIONS ARE AS-BUILT.
2. BLOCK DESIGNED BY COMBUSTION ENGINEERING CORP. REFERENCE DWG. E-12173-196-001 REV. 02.
3. SCRIBE CENTERLINES AS SHOWN .003 TO .005 WIDE AND DEEP WHERE NOTED. STEEL STAMP OR MILL CUT AN INDEX MARK AT ENDS OF EACH CENTERLINE AS SHOWN 1/32 x 1/32 x 1/4 LG.
4. STEEL STAMP ID. NO. AS SHOWN ON SURFACE INDICATED IN 1/4 HIGH CHARACTERS.
5. THE EXISTING INFORMATION IS STEEL STAMPED ON SURFACE AS SHOWN IN 1/4 HIGH CHARACTERS.

EXCEPT AS MAY BE OTHERWISE PROVIDED BY CONTRACT, THESE DRAWINGS AND SPECIFICATIONS ARE THE PROPERTY OF SOUTHWEST RESEARCH INSTITUTE, ARE ISSUED IN STRICT CONFIDENCE, AND SHALL NOT BE REPRODUCED, OR COPIED, OR USED AS THE BASIS FOR THE MANUFACTURE OR SALE OF APPARATUS WITHOUT PERMISSION.

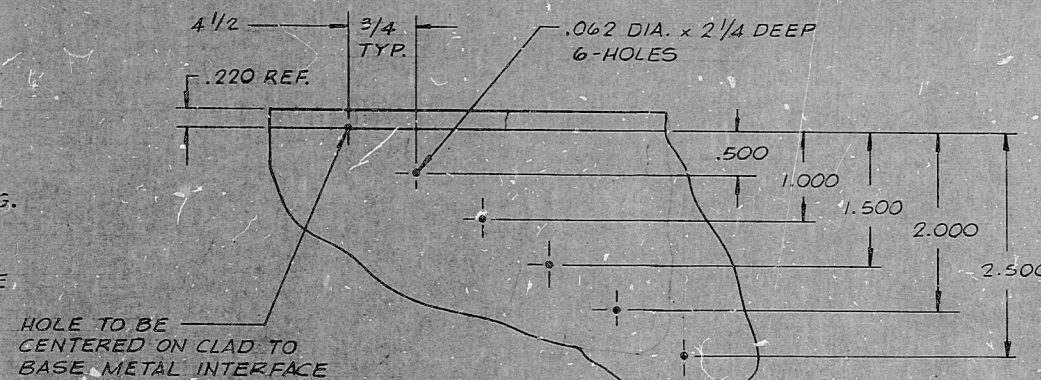

VIEW D-D
SCALE: 1/1

DETAIL - B
SCALE: 1/1

MT
APERTURE
CARD

9-CSCL-91-W-STP

2	2	LIFTING EYE	MCMASTER CARR 3024 T26
1	1	BLOCK	
PARTS LIST			
SOUTHWEST RESEARCH INSTITUTE			
QUALITY ASSURANCE SYSTEMS AND ENGINEERING DIVISION			
SAN ANTONIO, TEXAS			
9" CLAD VESSEL			
UT CALIBRATION BLOCK			
SOUTH TEXAS PROJECT UNIT 2			
SCALE 1/2			
CD-5770-695			
REV.			

LET	DCN NR	DATE	CHK	DSGN MGR	PROJ MGR	QA MGR

REVISIONS

PDR RIDS

8707060415

