


UNCONTROLLED COPY

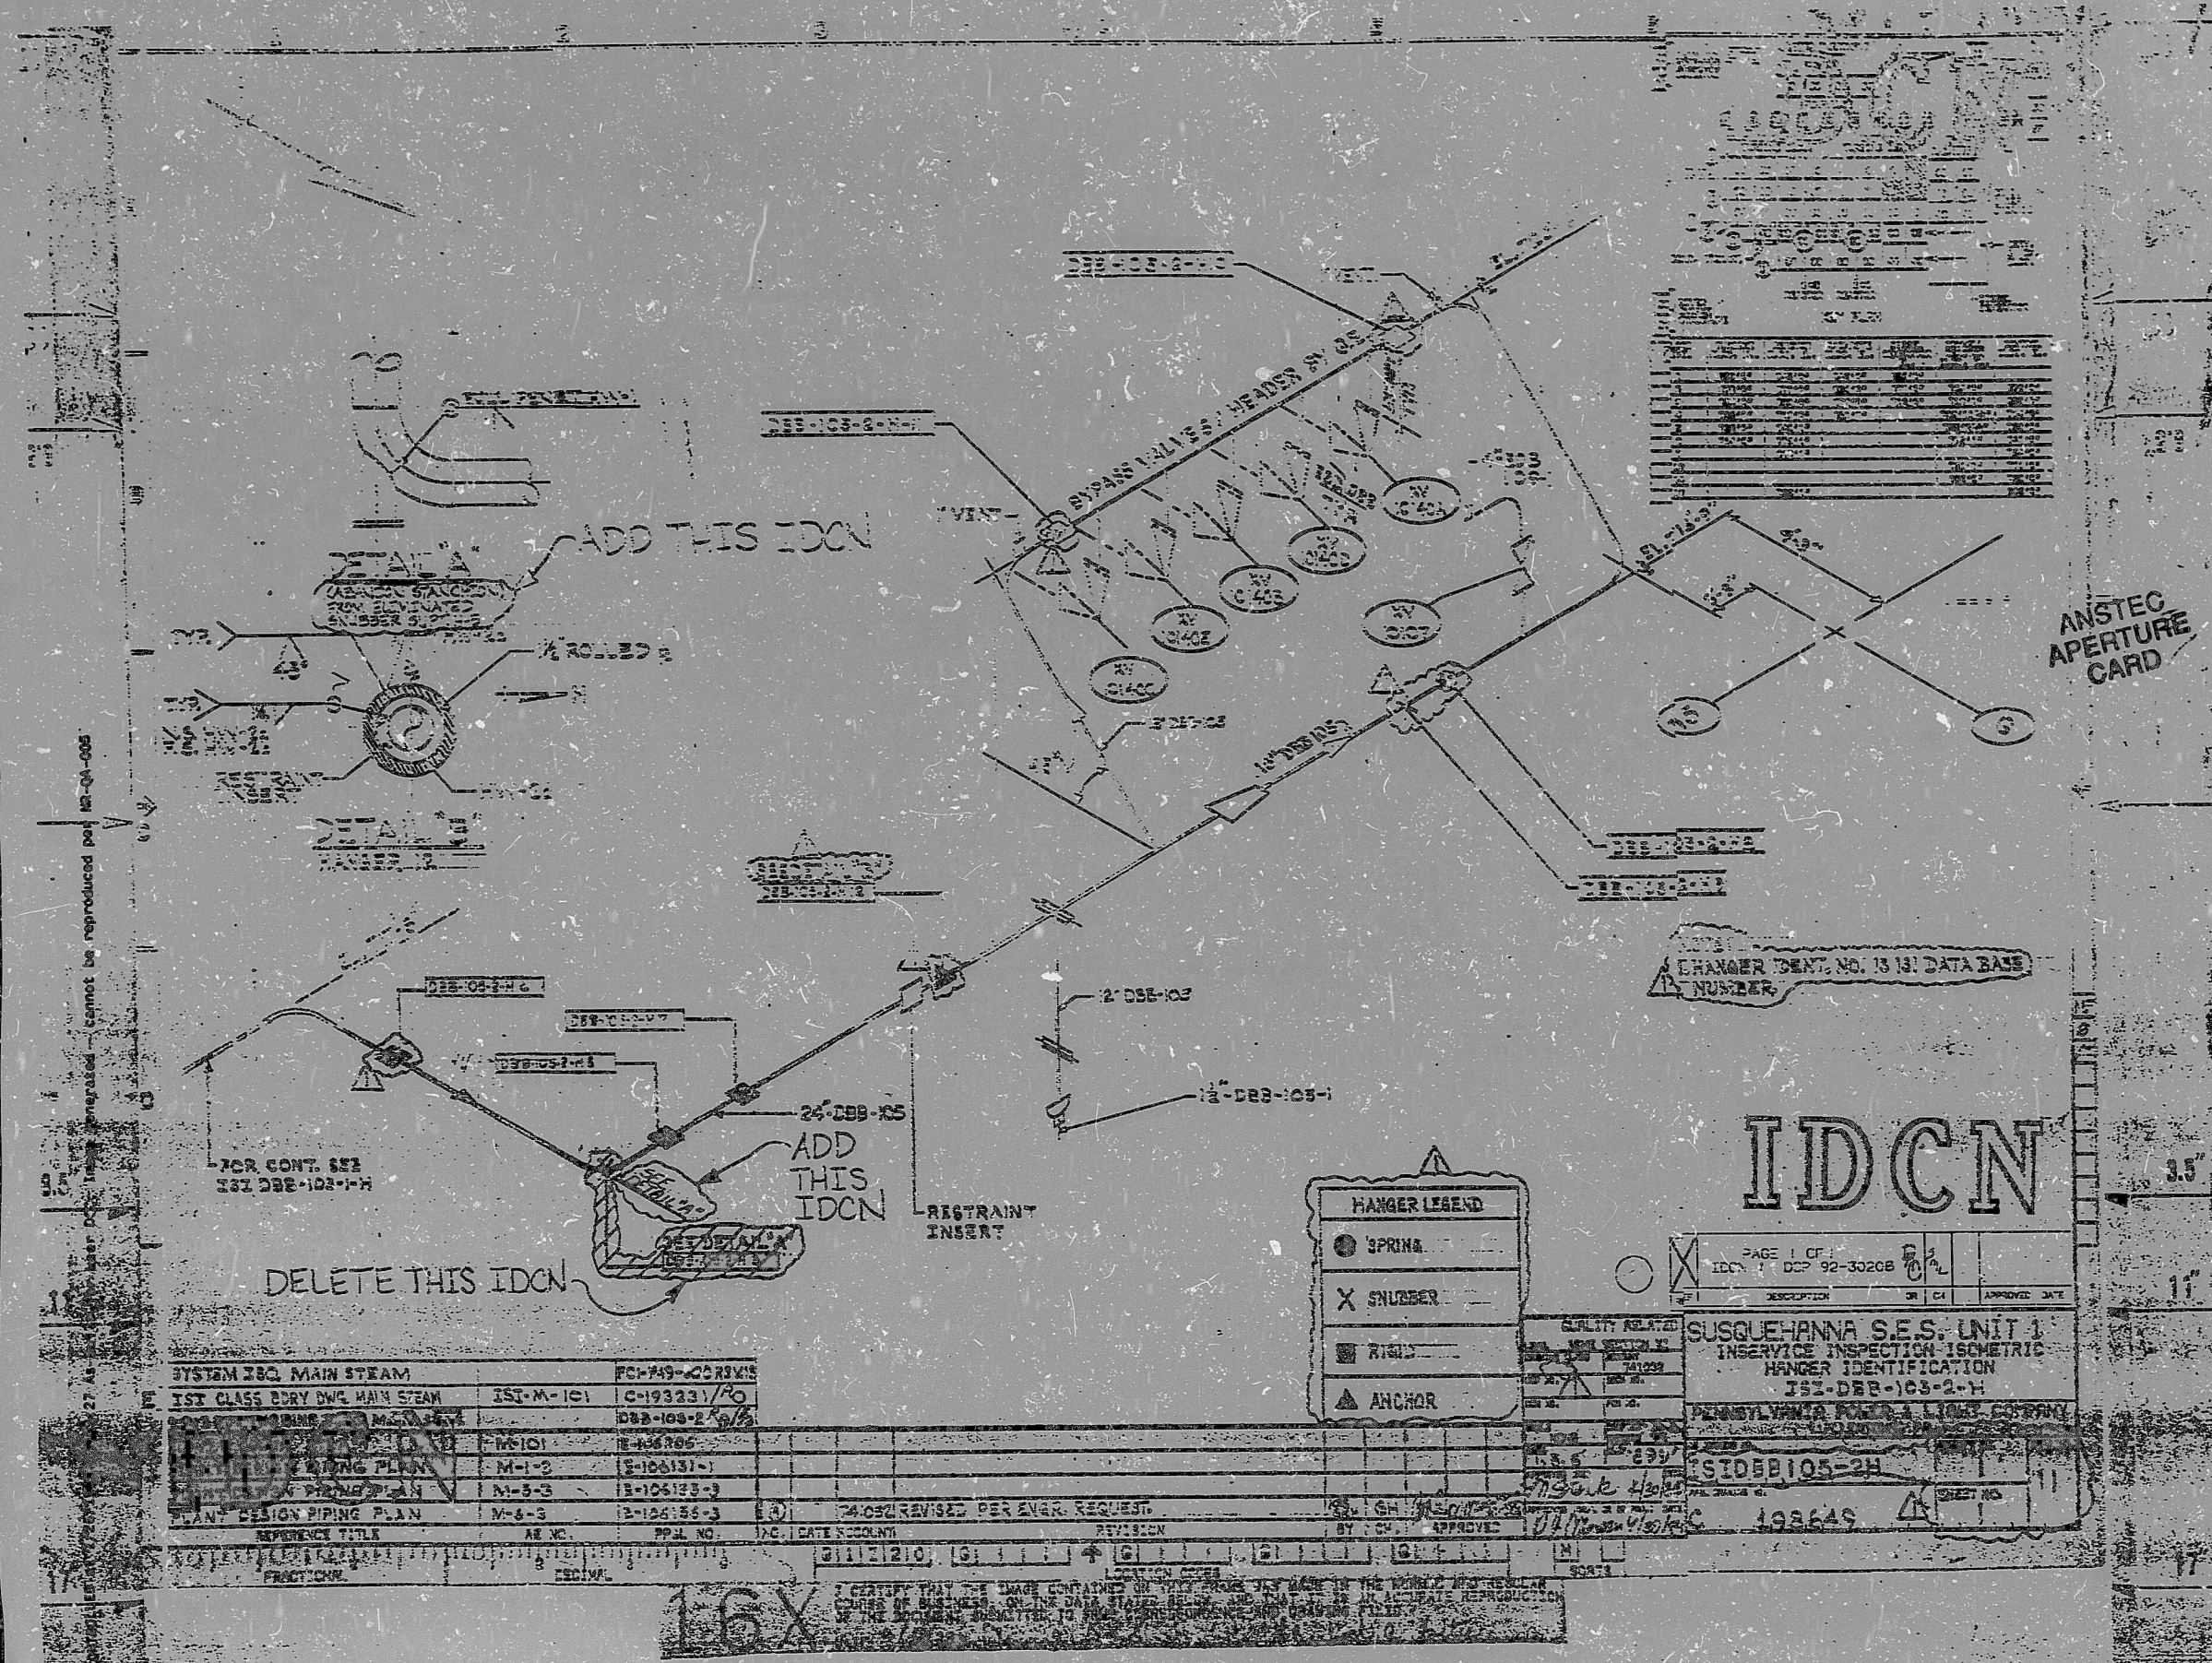

PDR RIDS

9507170180

