


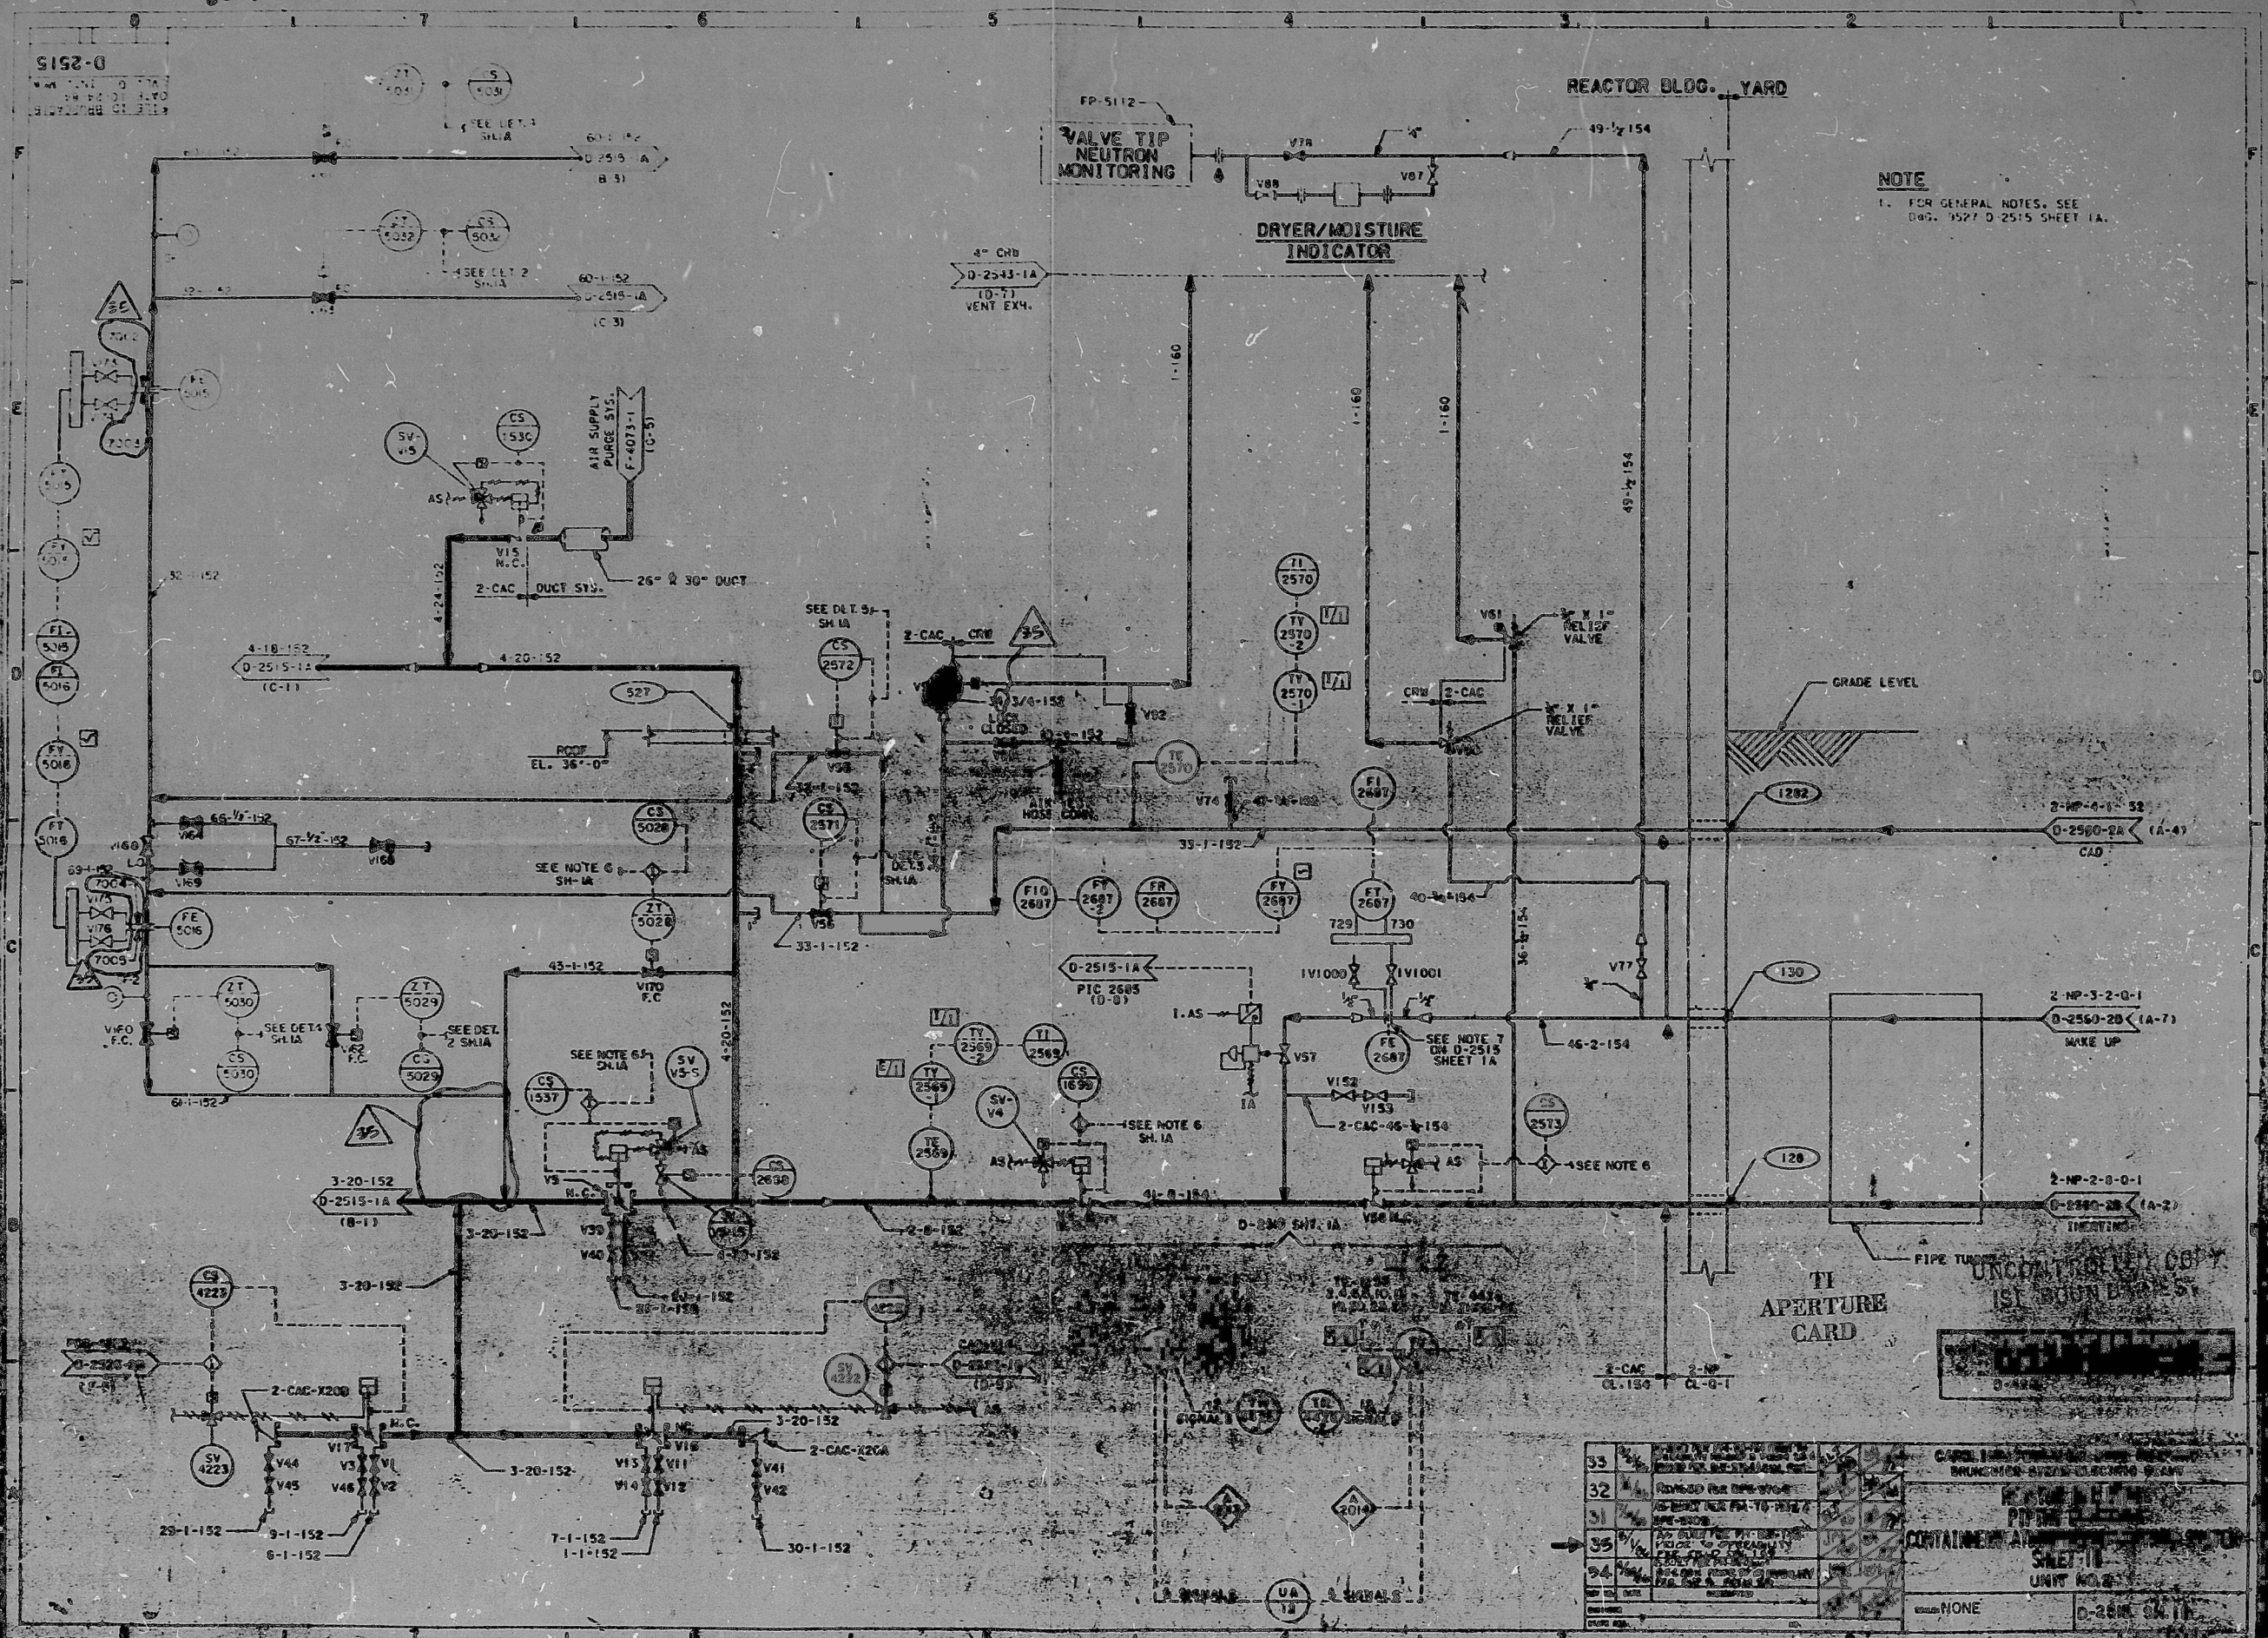

NOTE

1. FOR GENERAL NOTES, SEE
DoG. 9527 D-2515 SHEET 1A.

UNCONTROLLED COPY
ISI BOUNDED 5.

COPIES

[illegible]

5610290570

PDR RIDS

8610290370

