


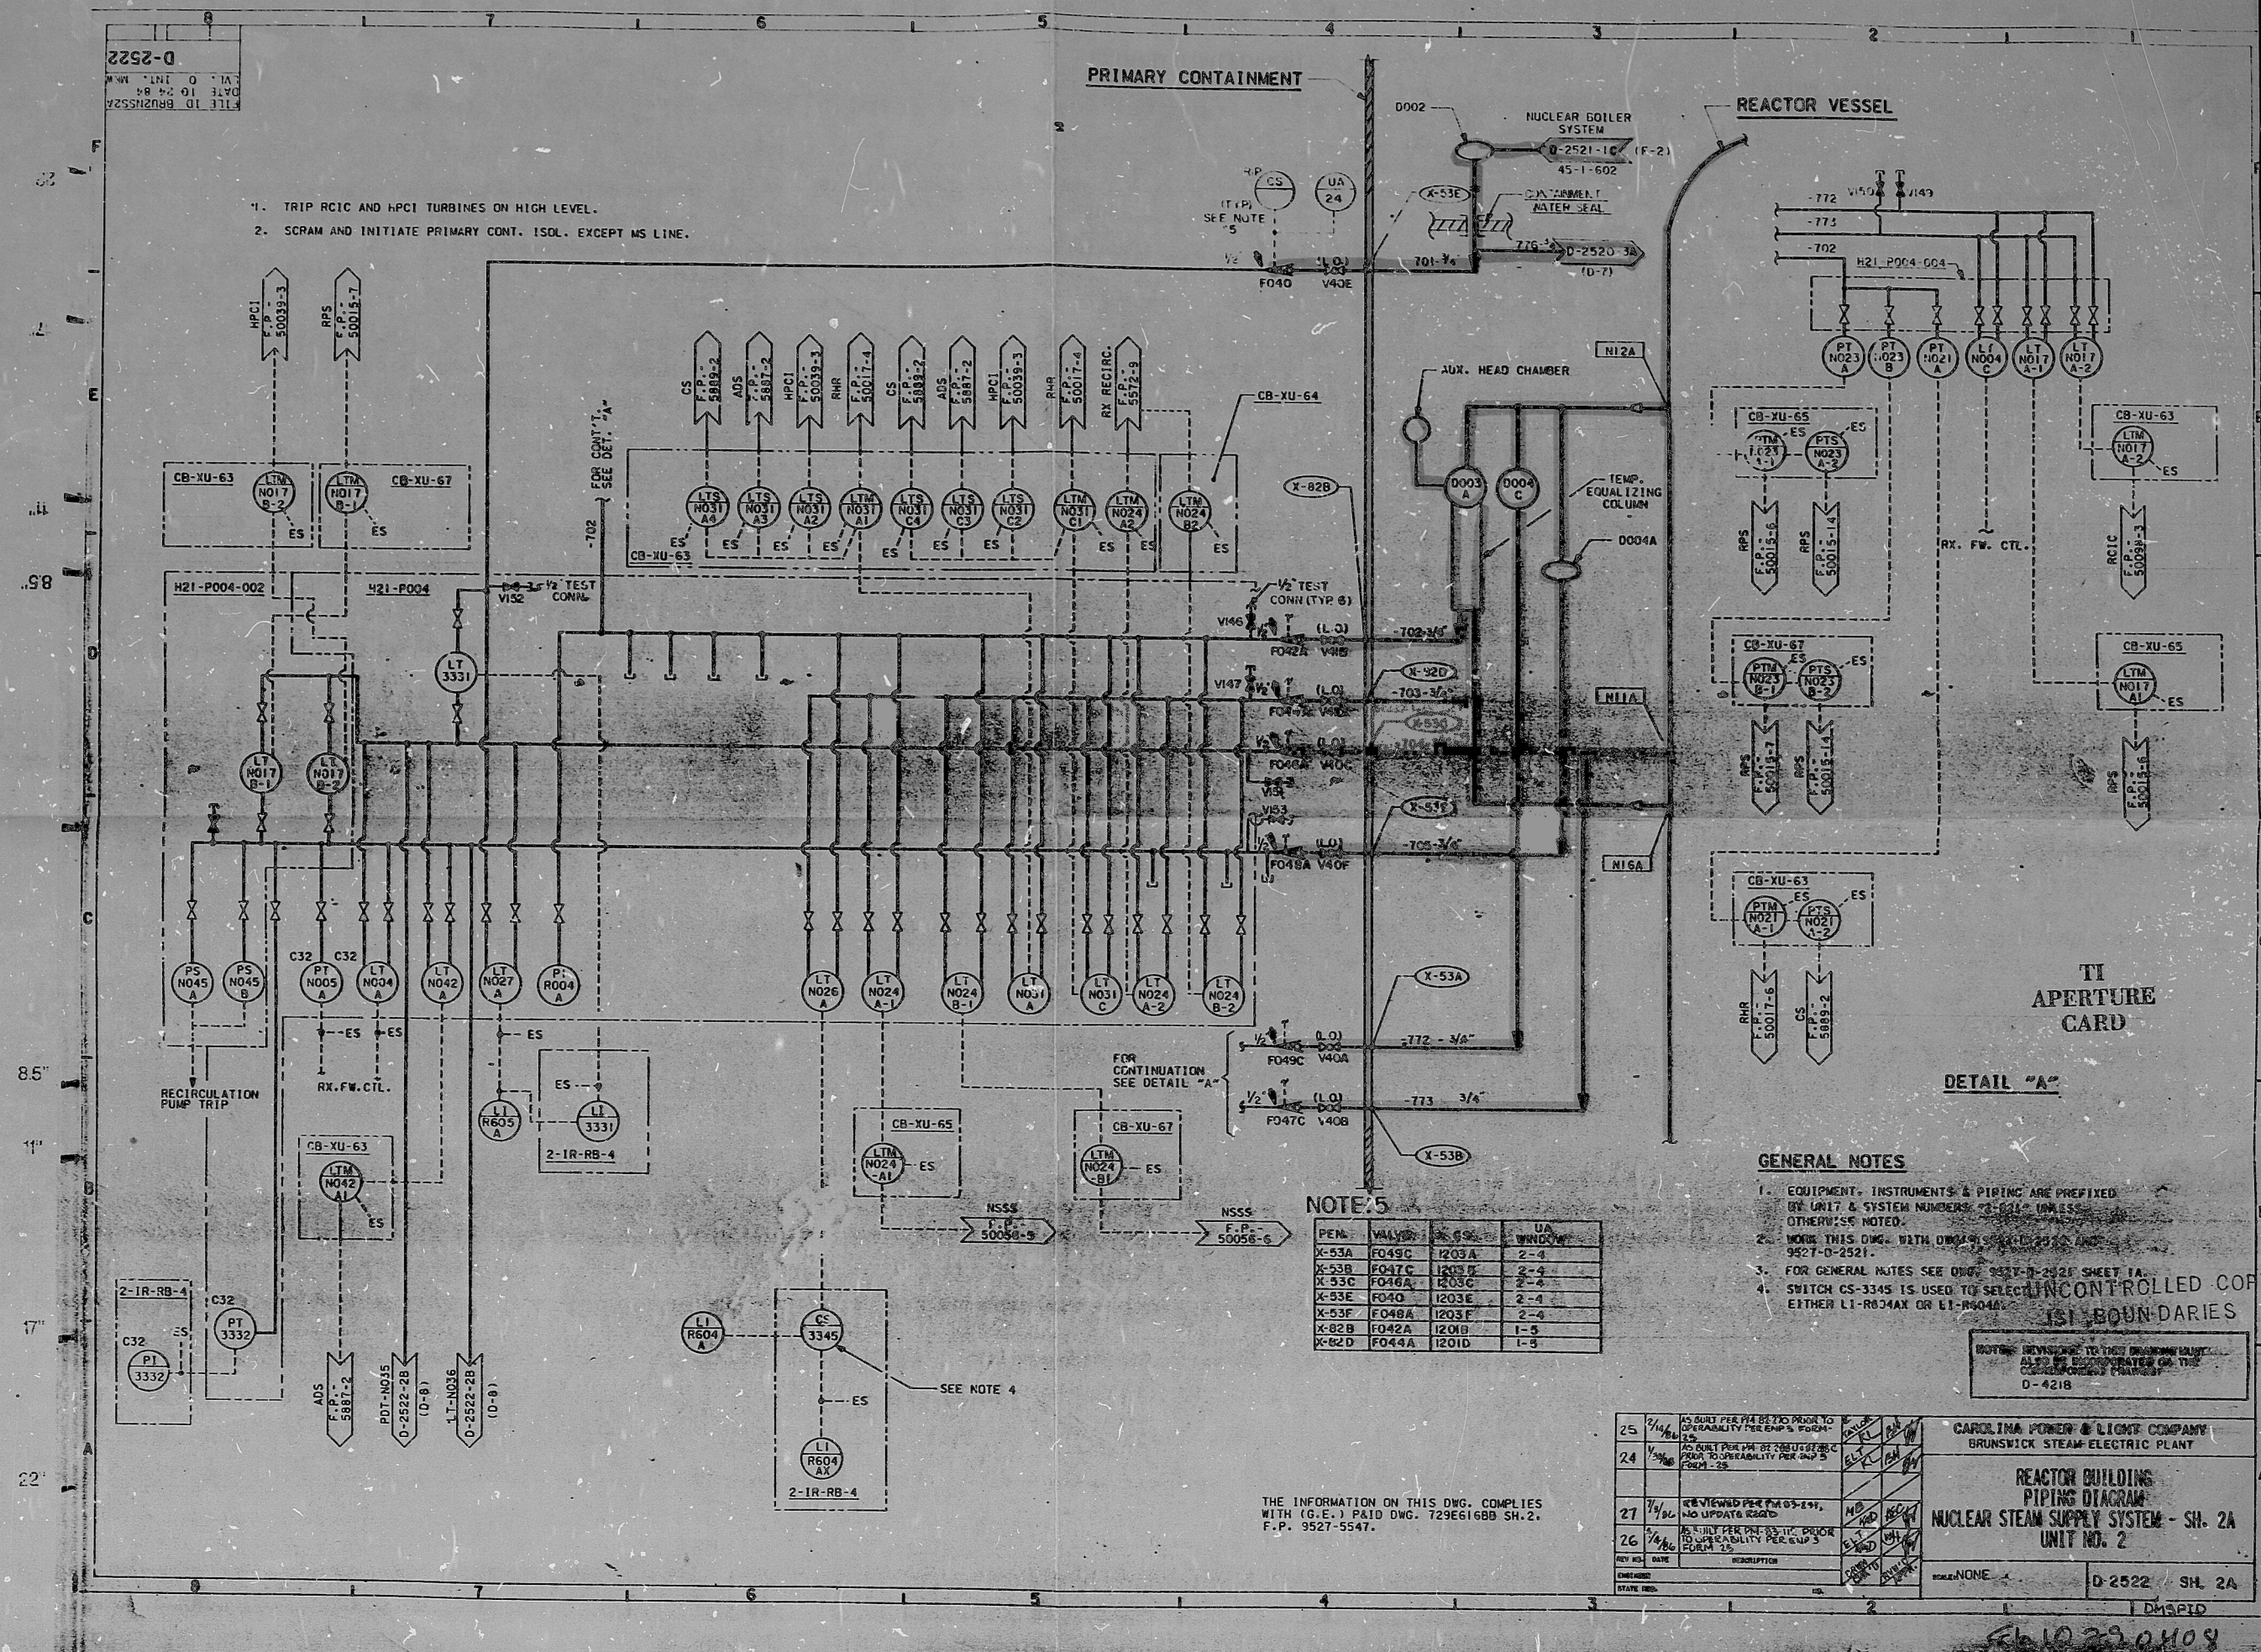

PDR RIDS

8610290408

