




UNCONTROLLED COPY
FOR INFORMATION ONLY

PDR RIDS

8707140127

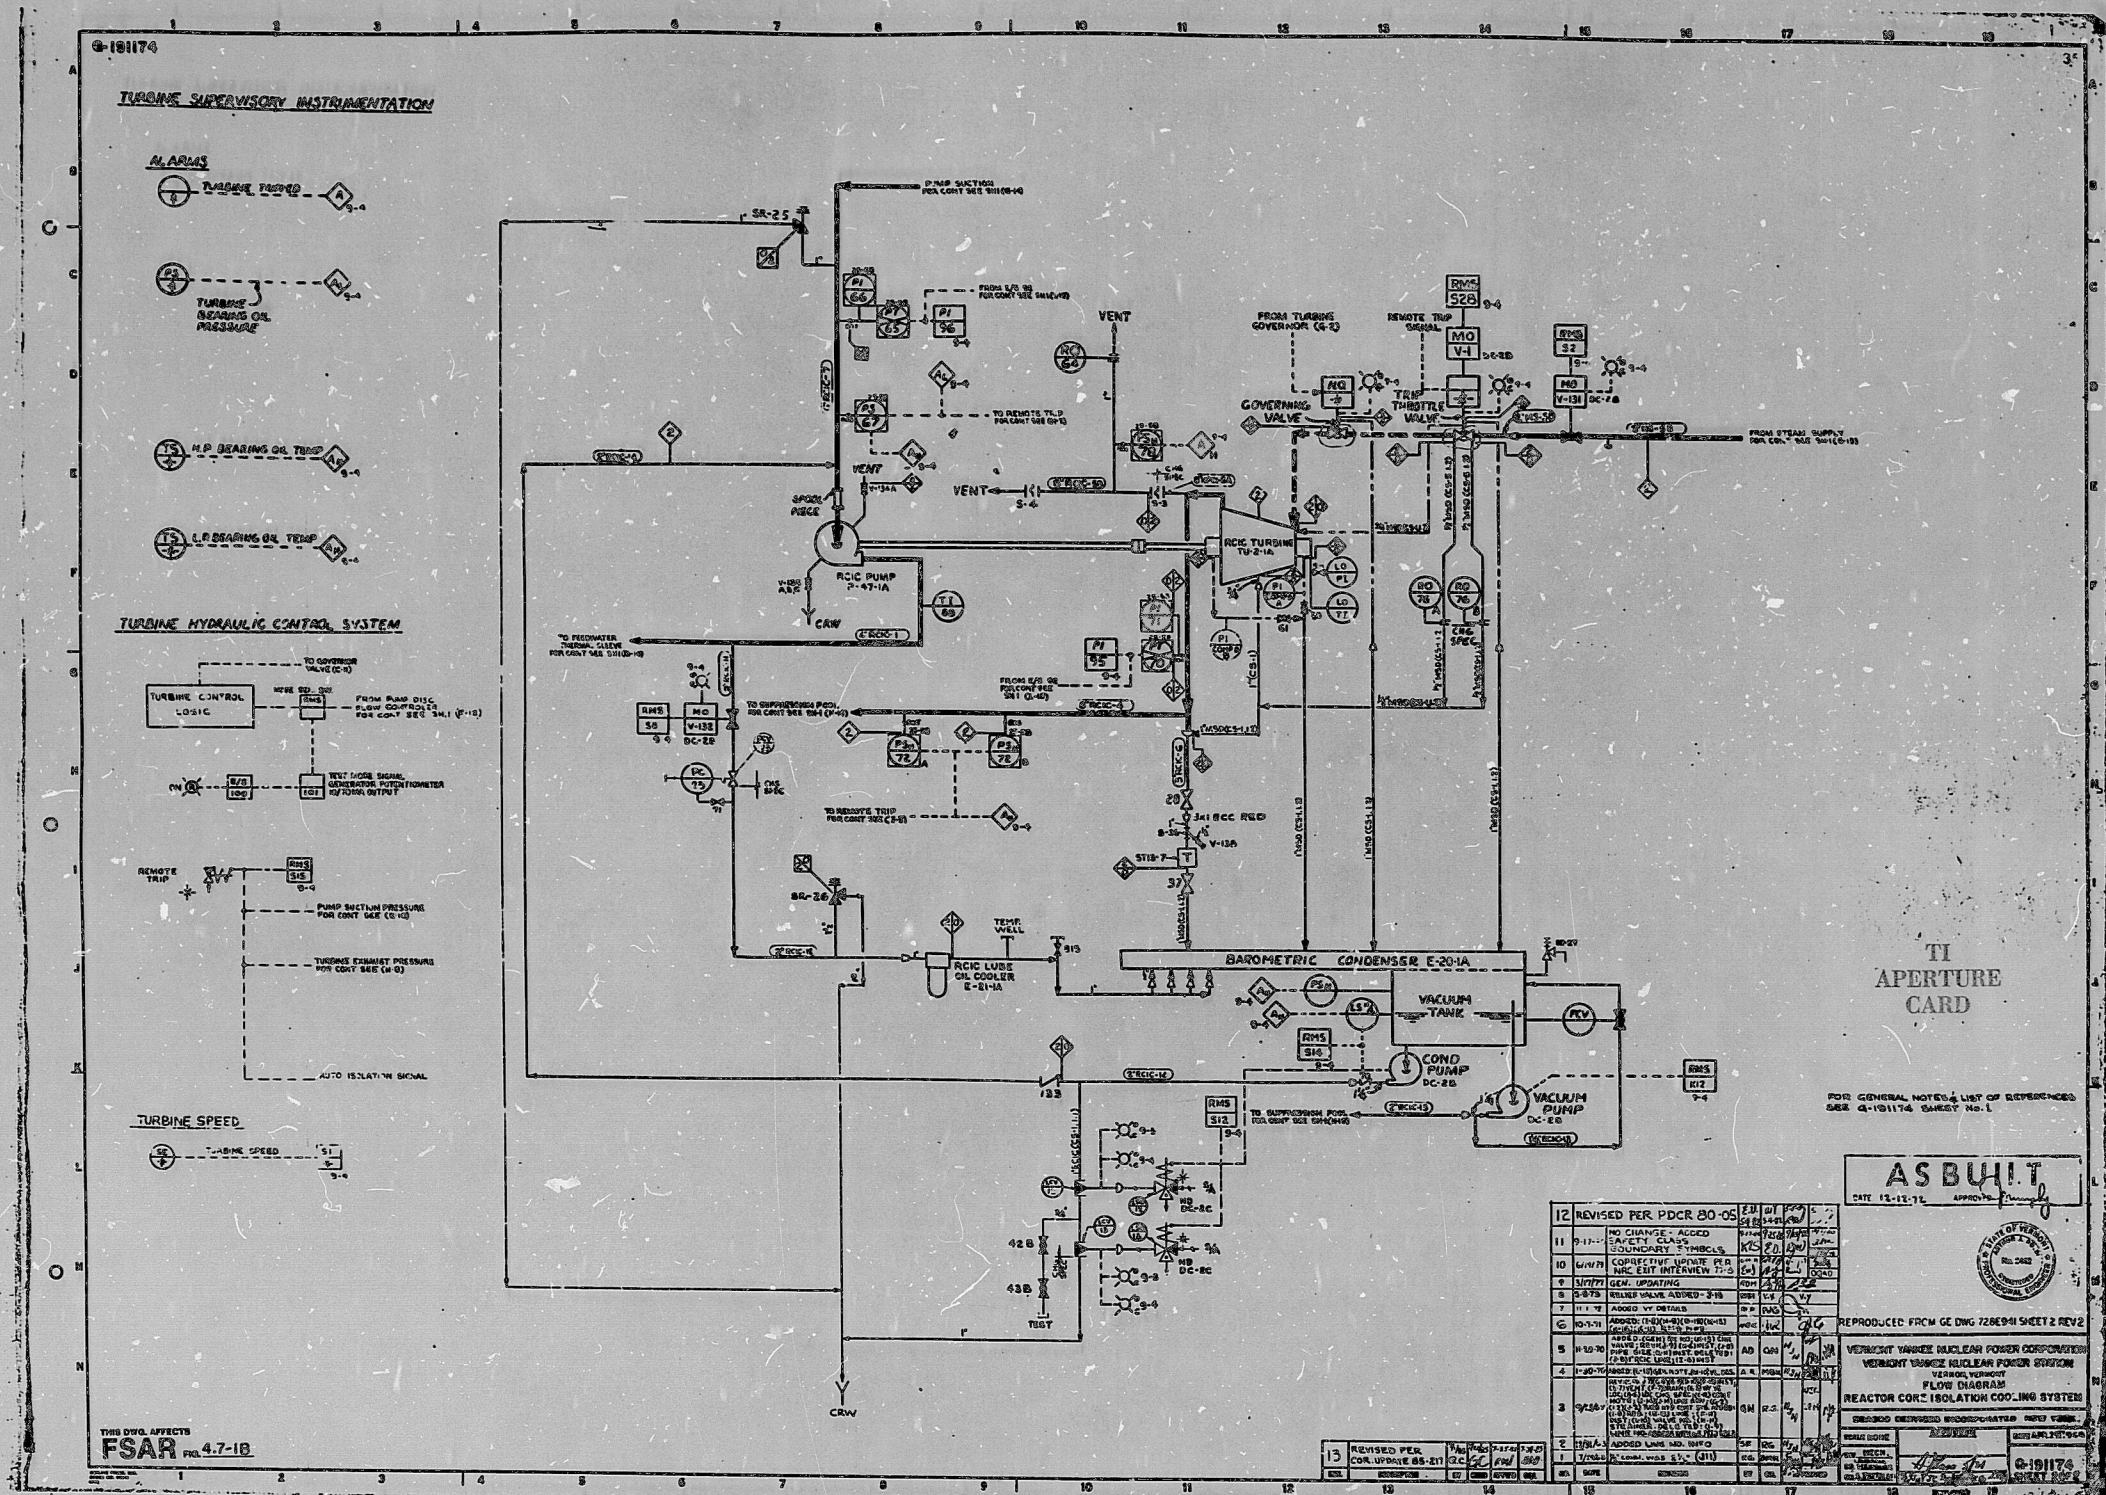