


ATTACHMENT 2

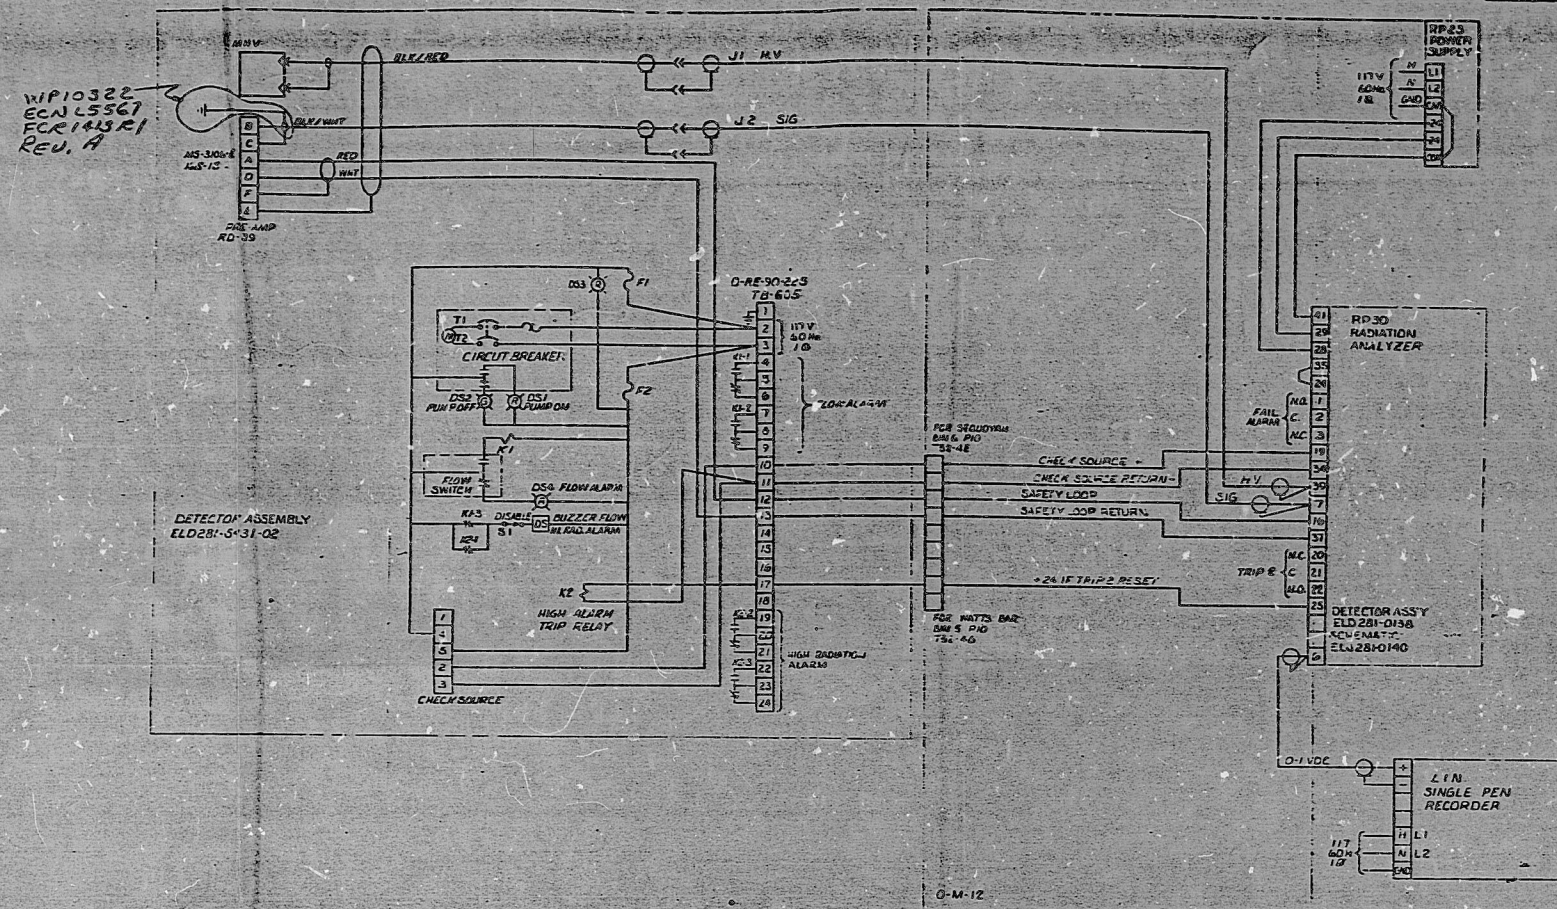

3. ALL RELAYS ARE SHOWN DE-ENERGIZED.
RELAY OUT PUTS ARE LABELED FOR NORMAL OPERATION
2. ALL POWER WIRING TO BE AWG #14 3/5
1. REF DWG NO. ELE281-3433
NOTES:

Revised to comply with customer configuration
for FCR1413 R1 - 28 FEB 1963
AC112

REV	DATE	BY	CHKD	APPV	DATE	REASON
1	28 FEB 1963	AC112				

NOT SUITABLE
FOR MICROFILM

MT
APERTURE
CARD

PHOTOGRAPHED
IN KNOXVILLE

20X 110619

8707150437

PDR RIDS

8707150437

