


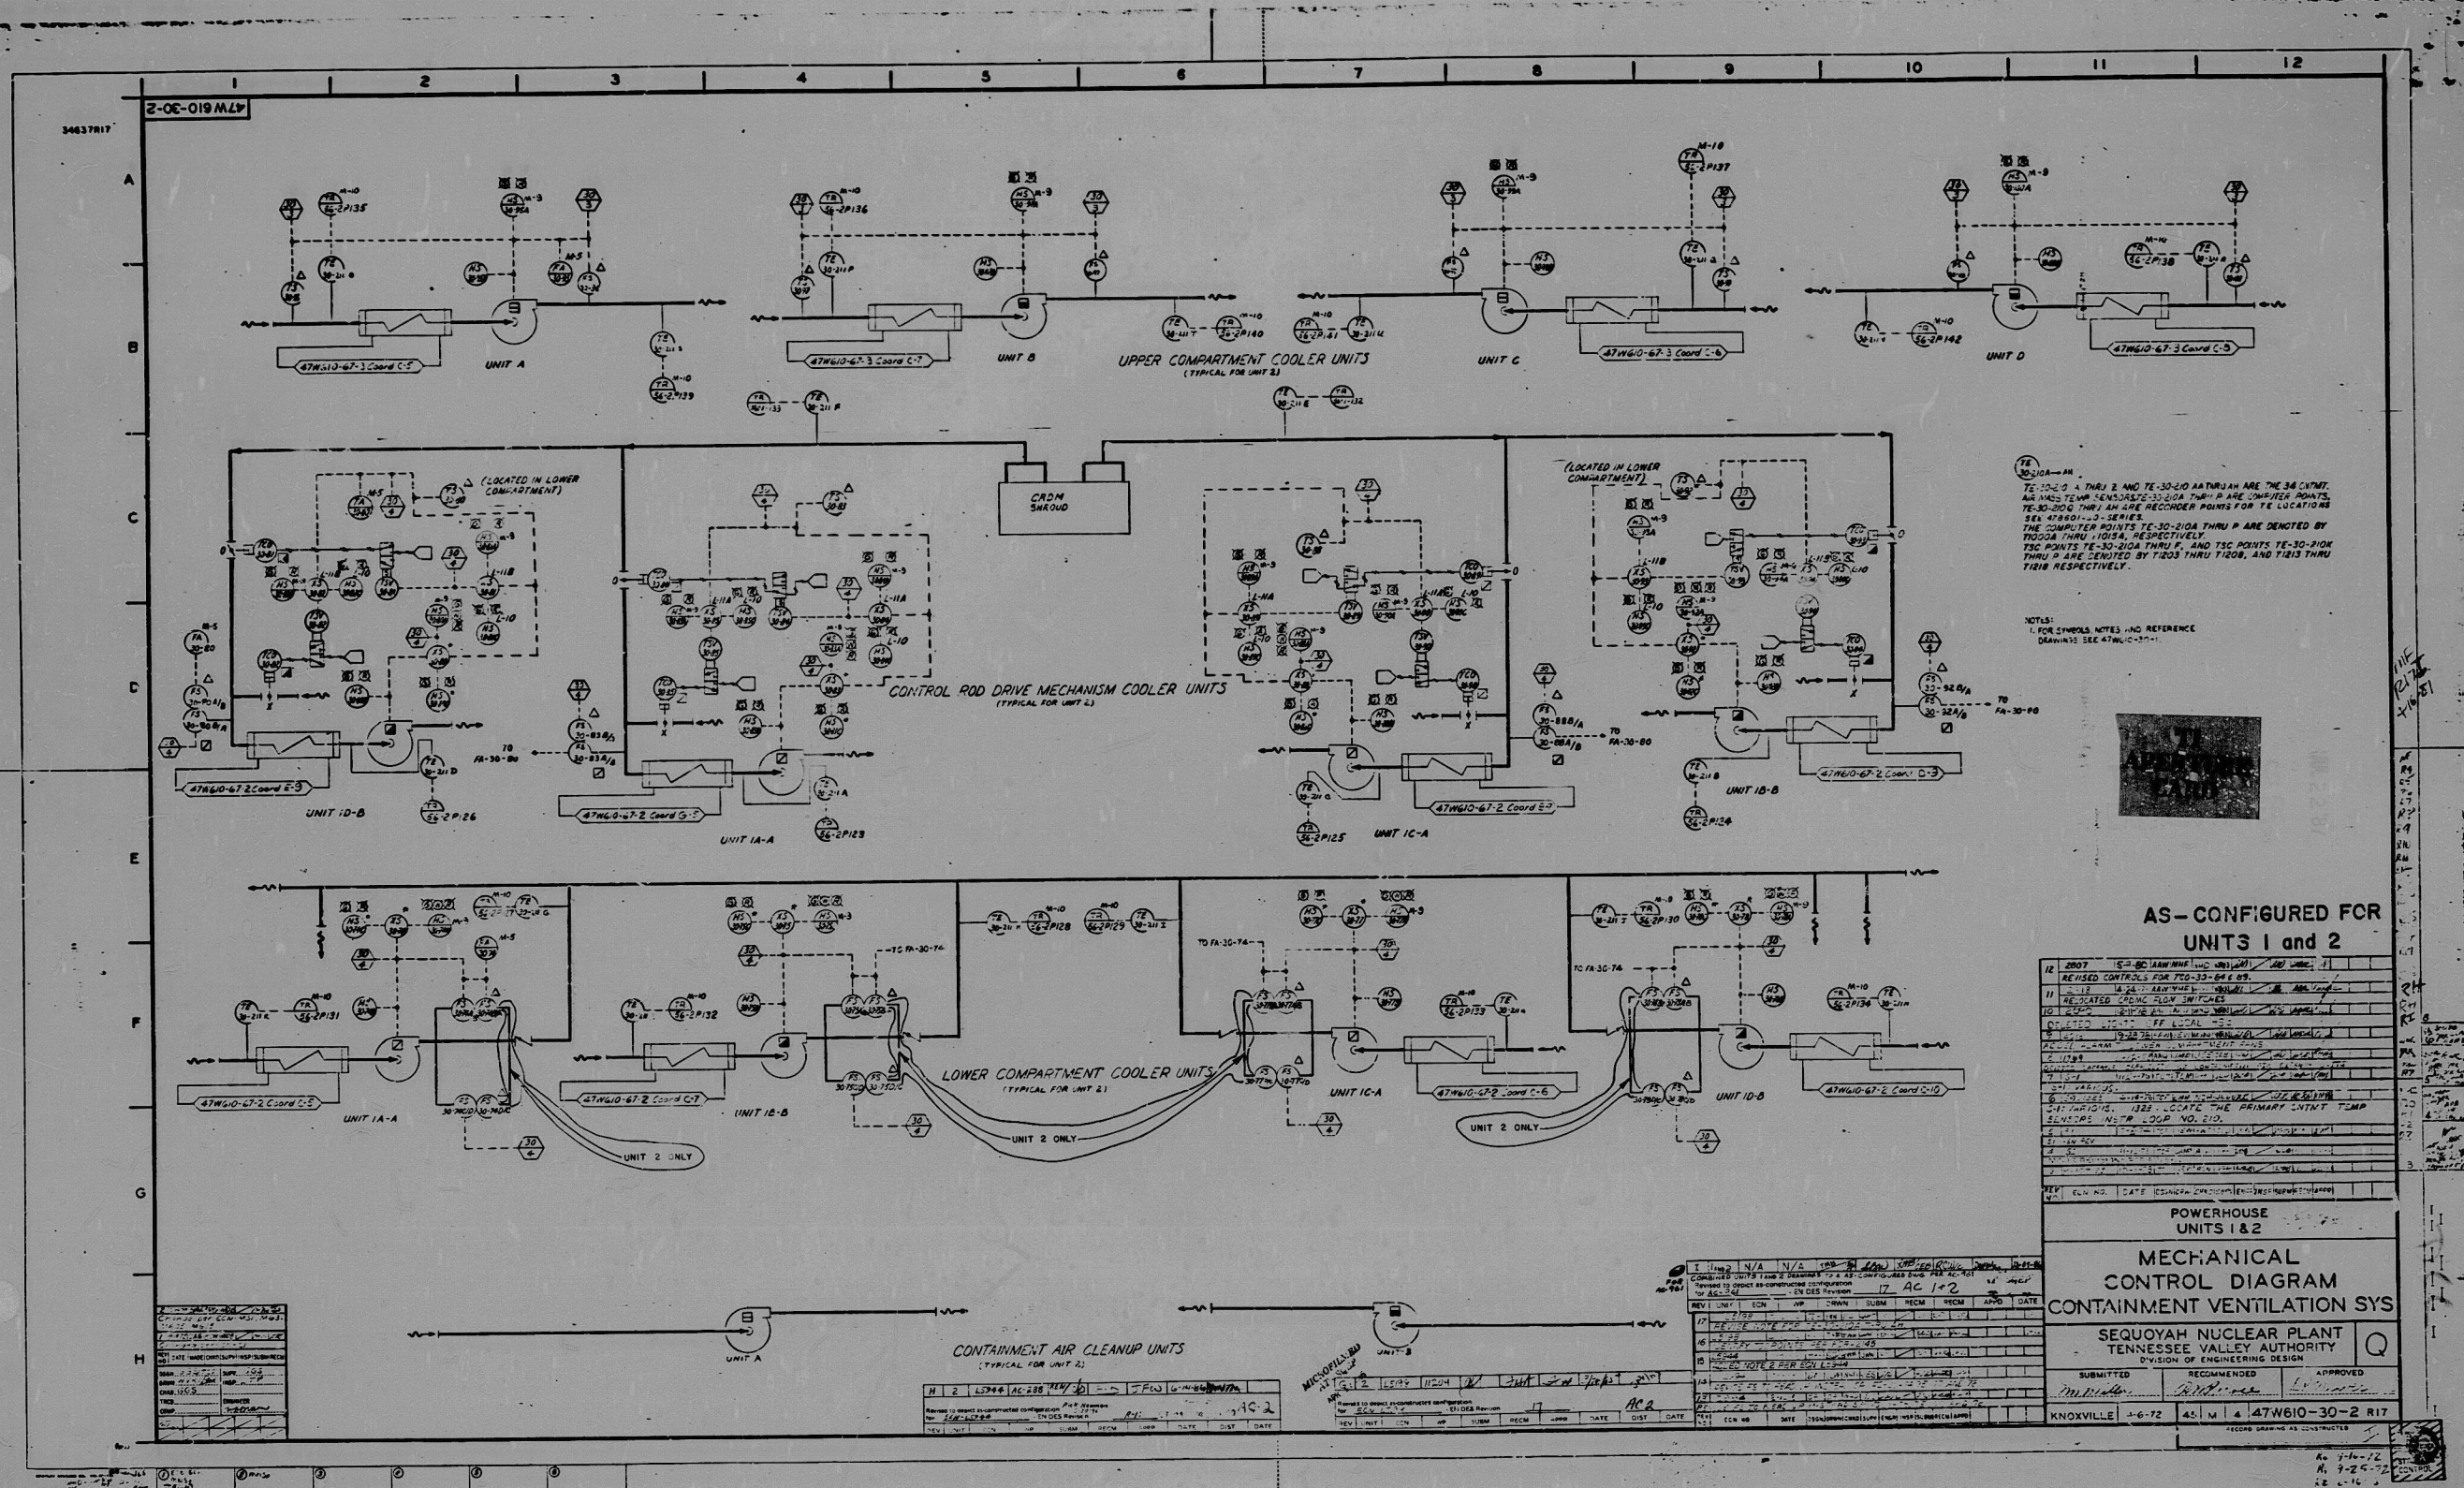

87087168724

PDR RIDS

