


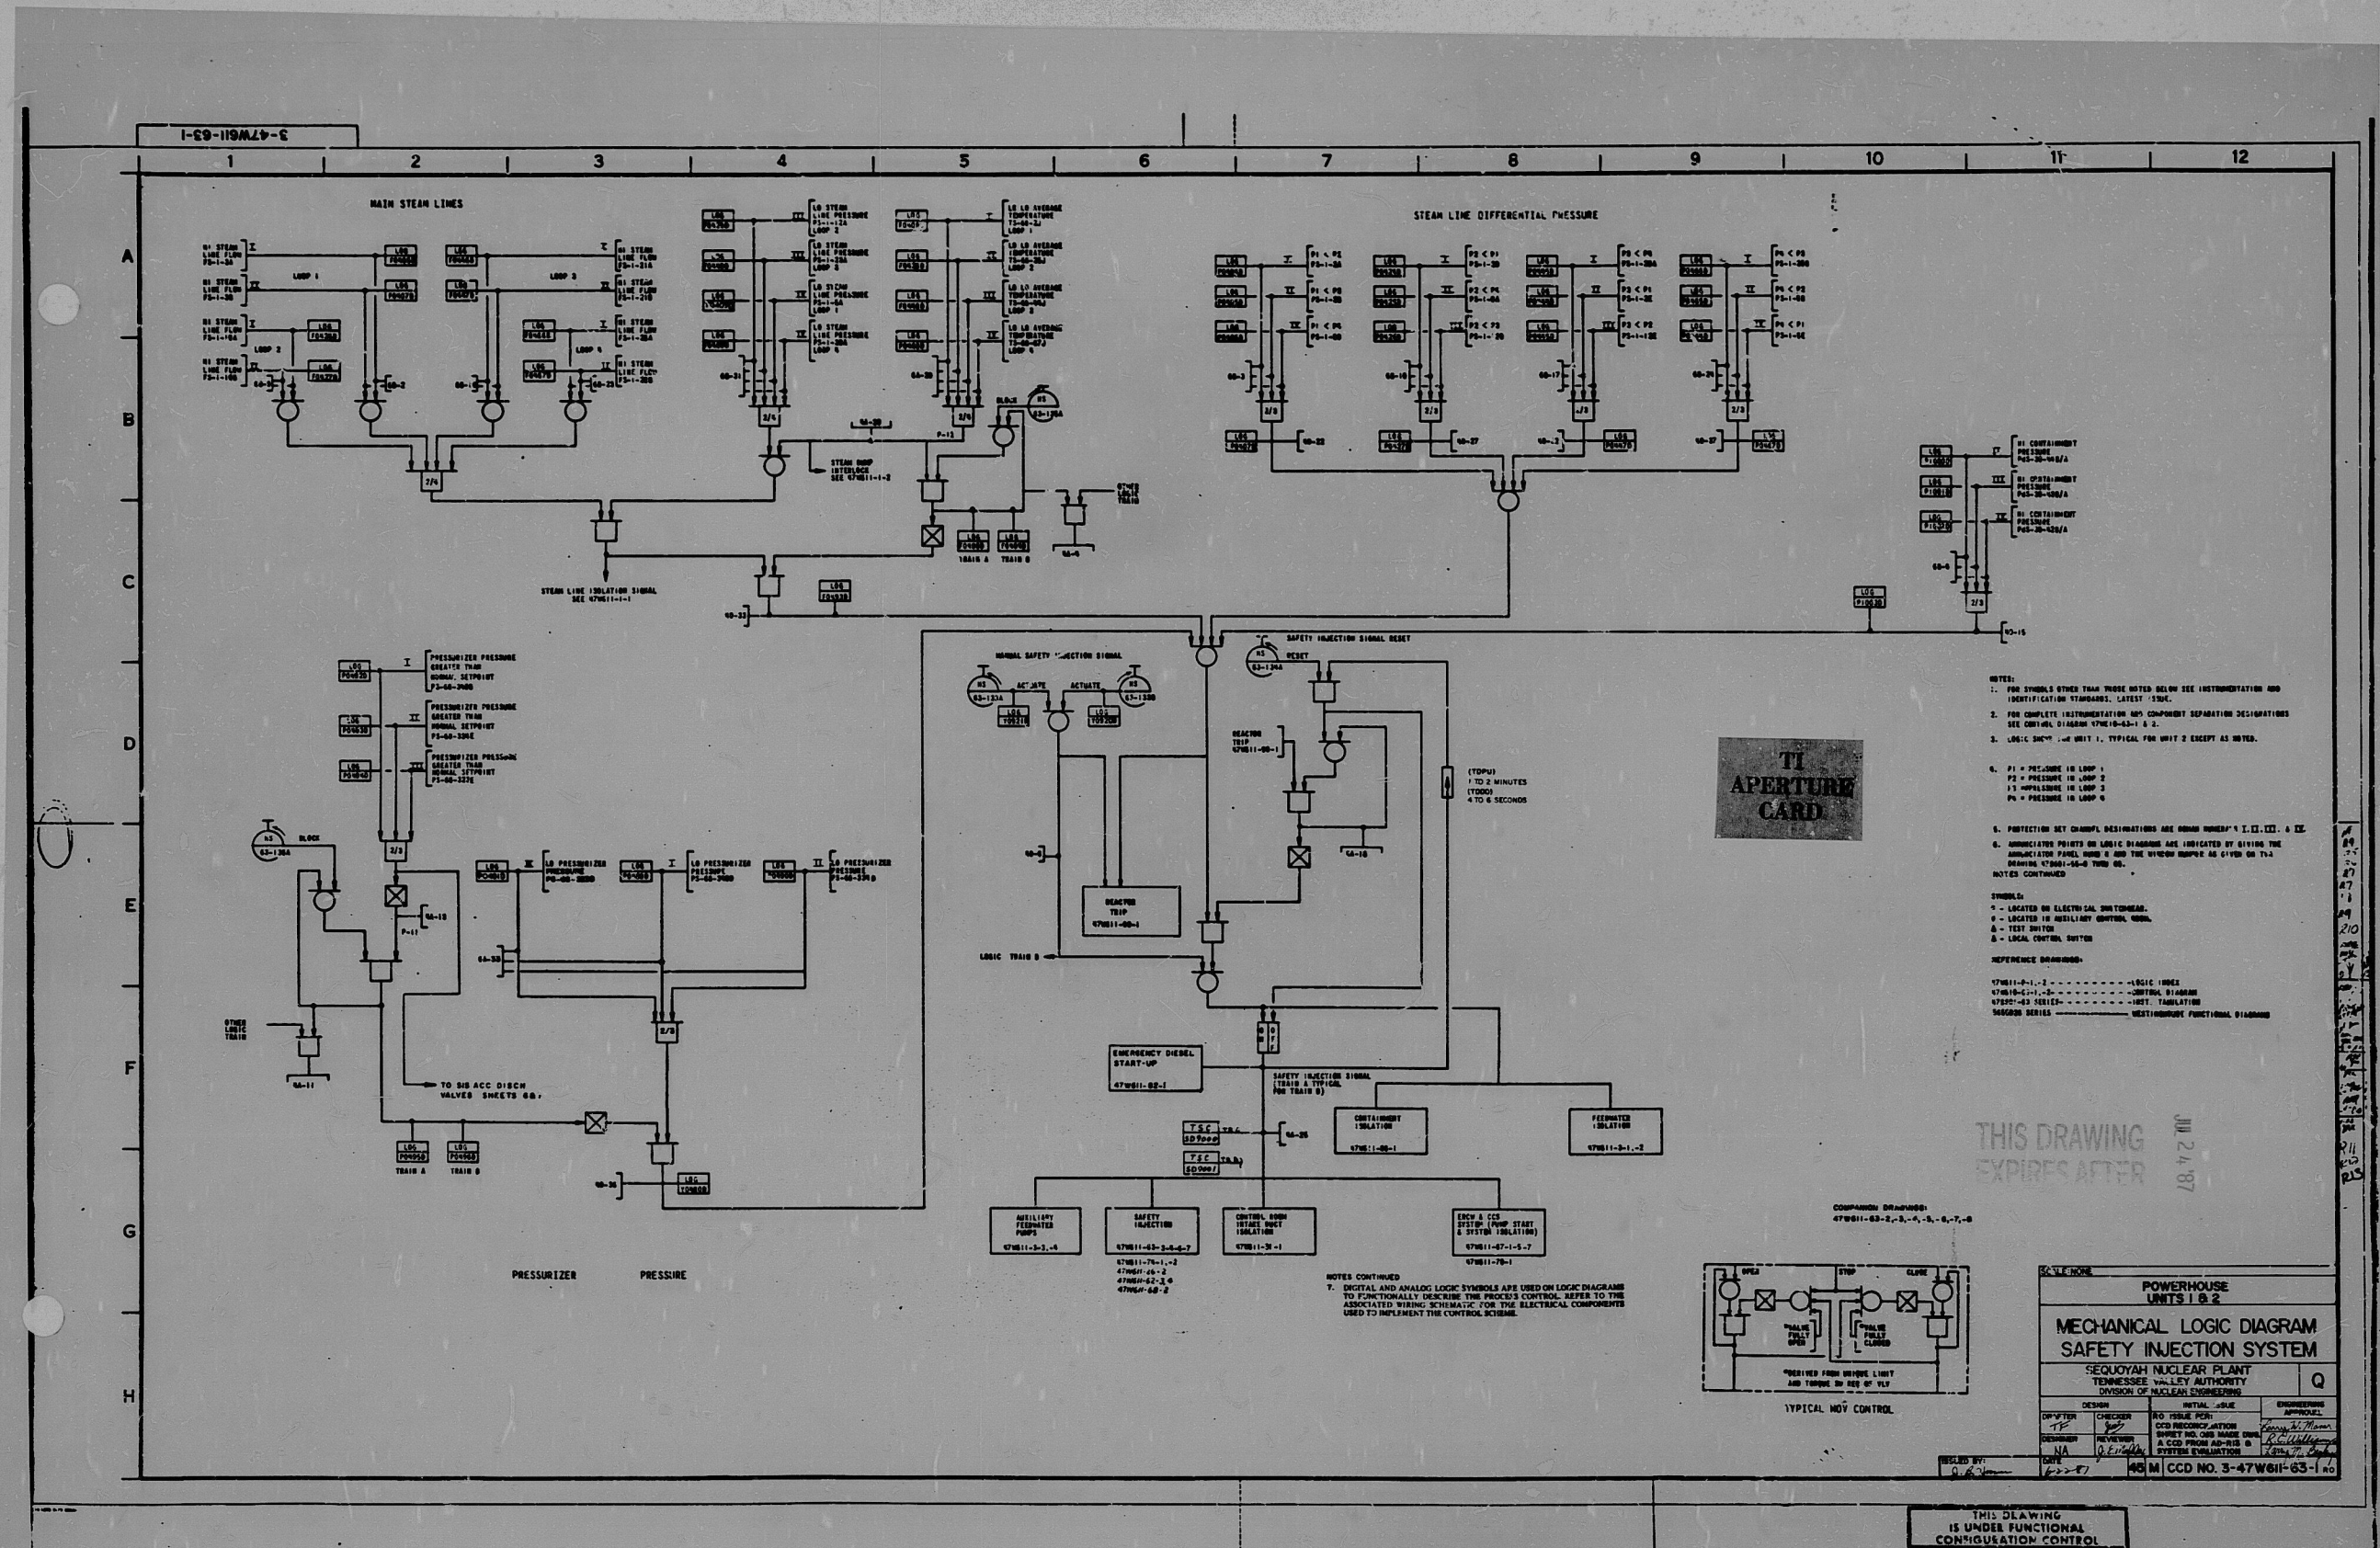

THIS DRAWING
EXPIRES AFTER
JUL 24 87

POWERHOUSE UNITS 1 & 2			
MECHANICAL LOGIC DIAGRAM SAFETY INJECTION SYSTEM			
SEQUOYAH NUCLEAR PLANT TENNESSEE VALLEY AUTHORITY DIVISION OF NUCLEAR SUBSYSTEMS			
DESIGN	INITIAL	DATE	Q
CCD NO. 3-47W611-63-1			

THIS DRAWING
IS UNDER FUNCTIONAL
CONFIGURATION CONTROL

PDR RIDS

820717/85

