


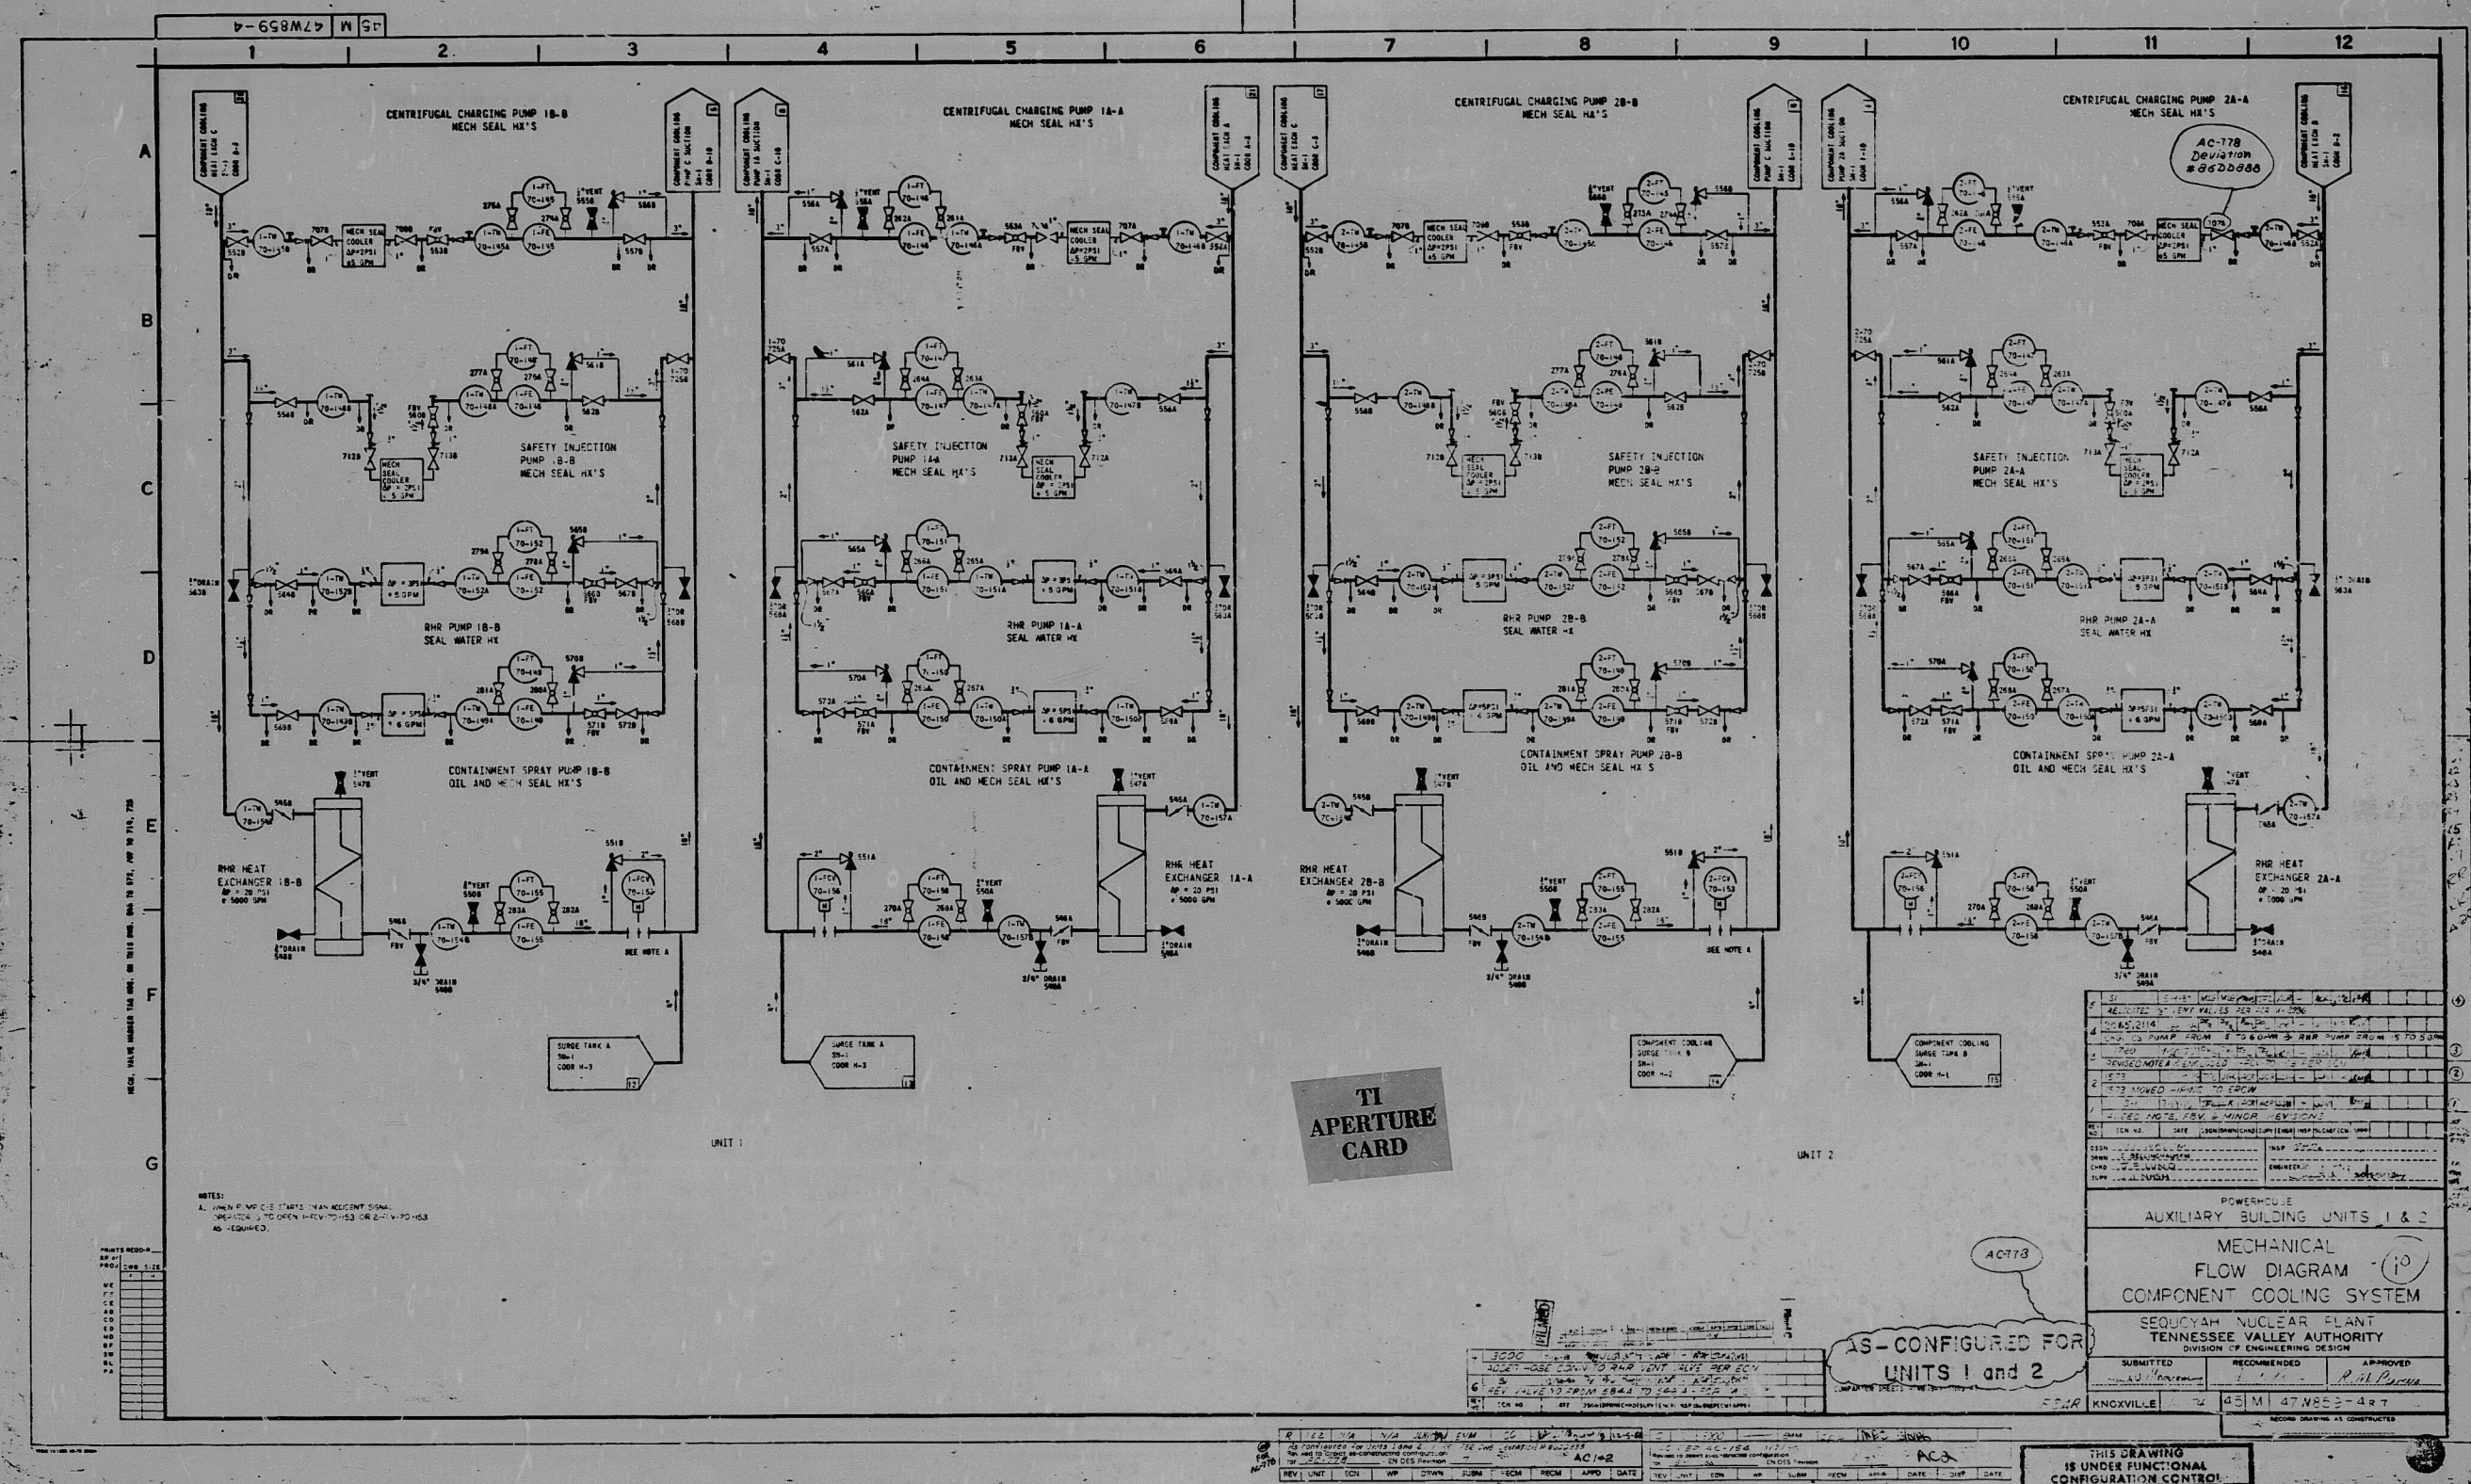

8168112818

PDR RIDS

