


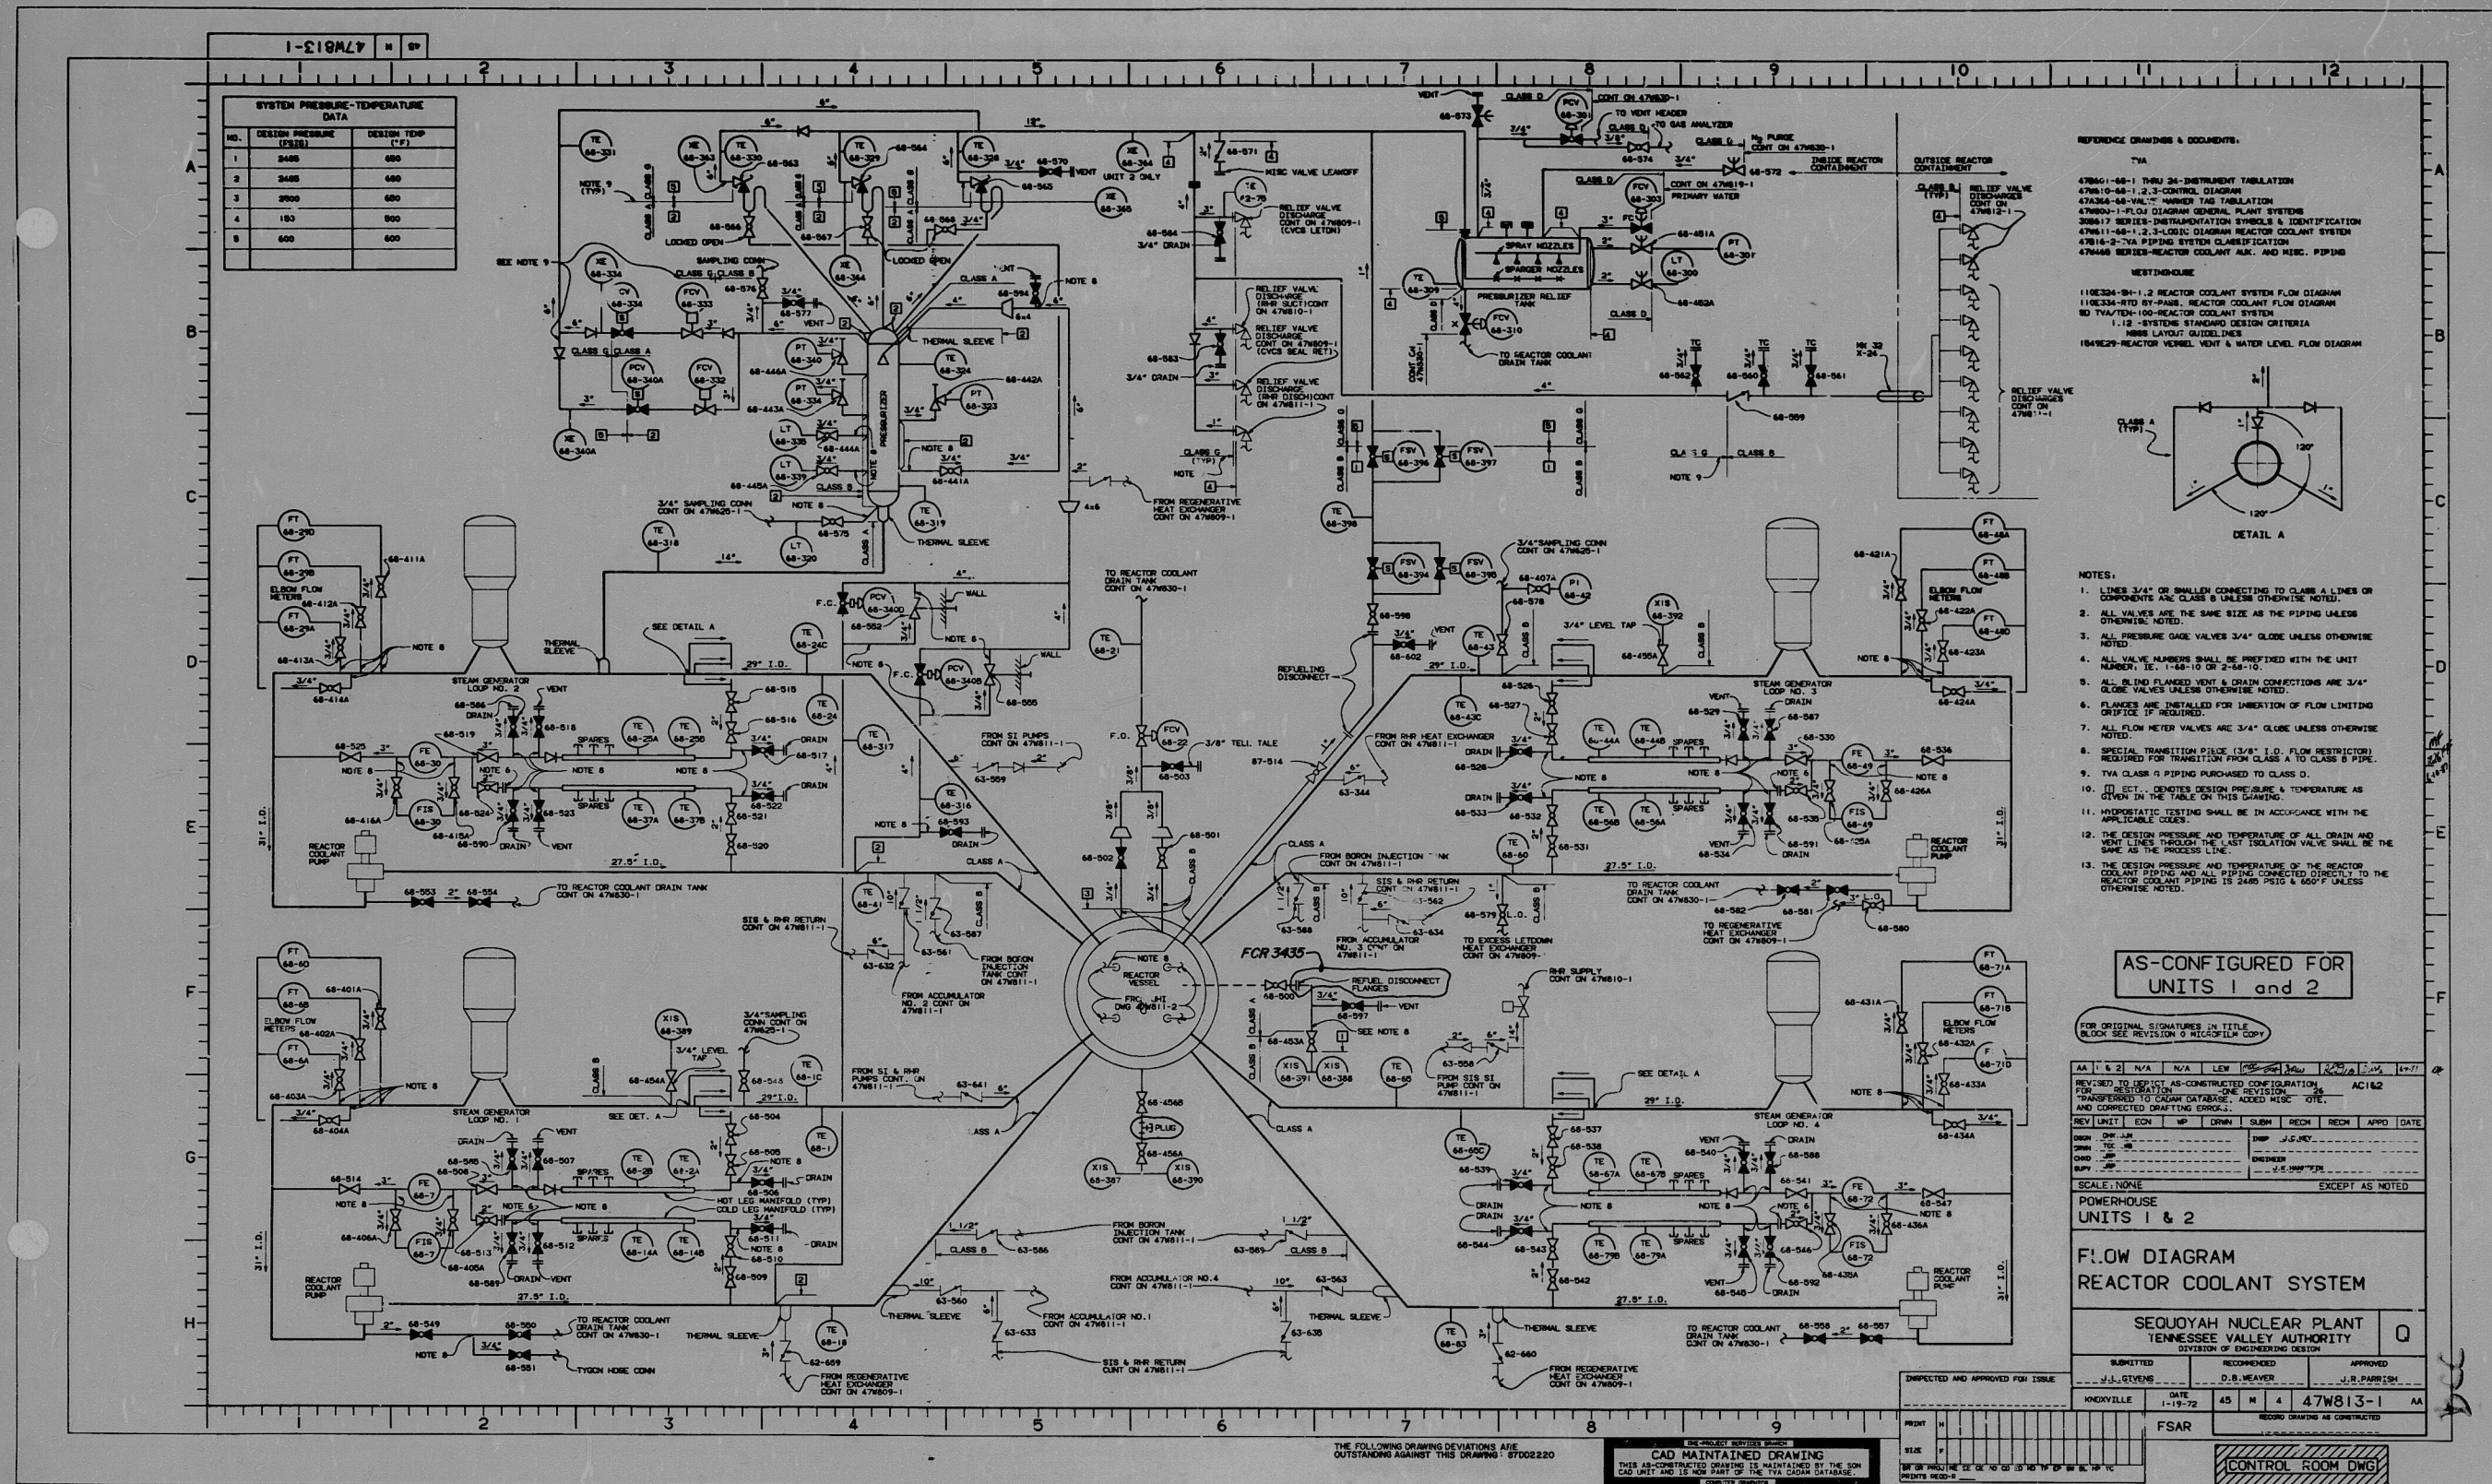



PDR RIDS

8707200096

