


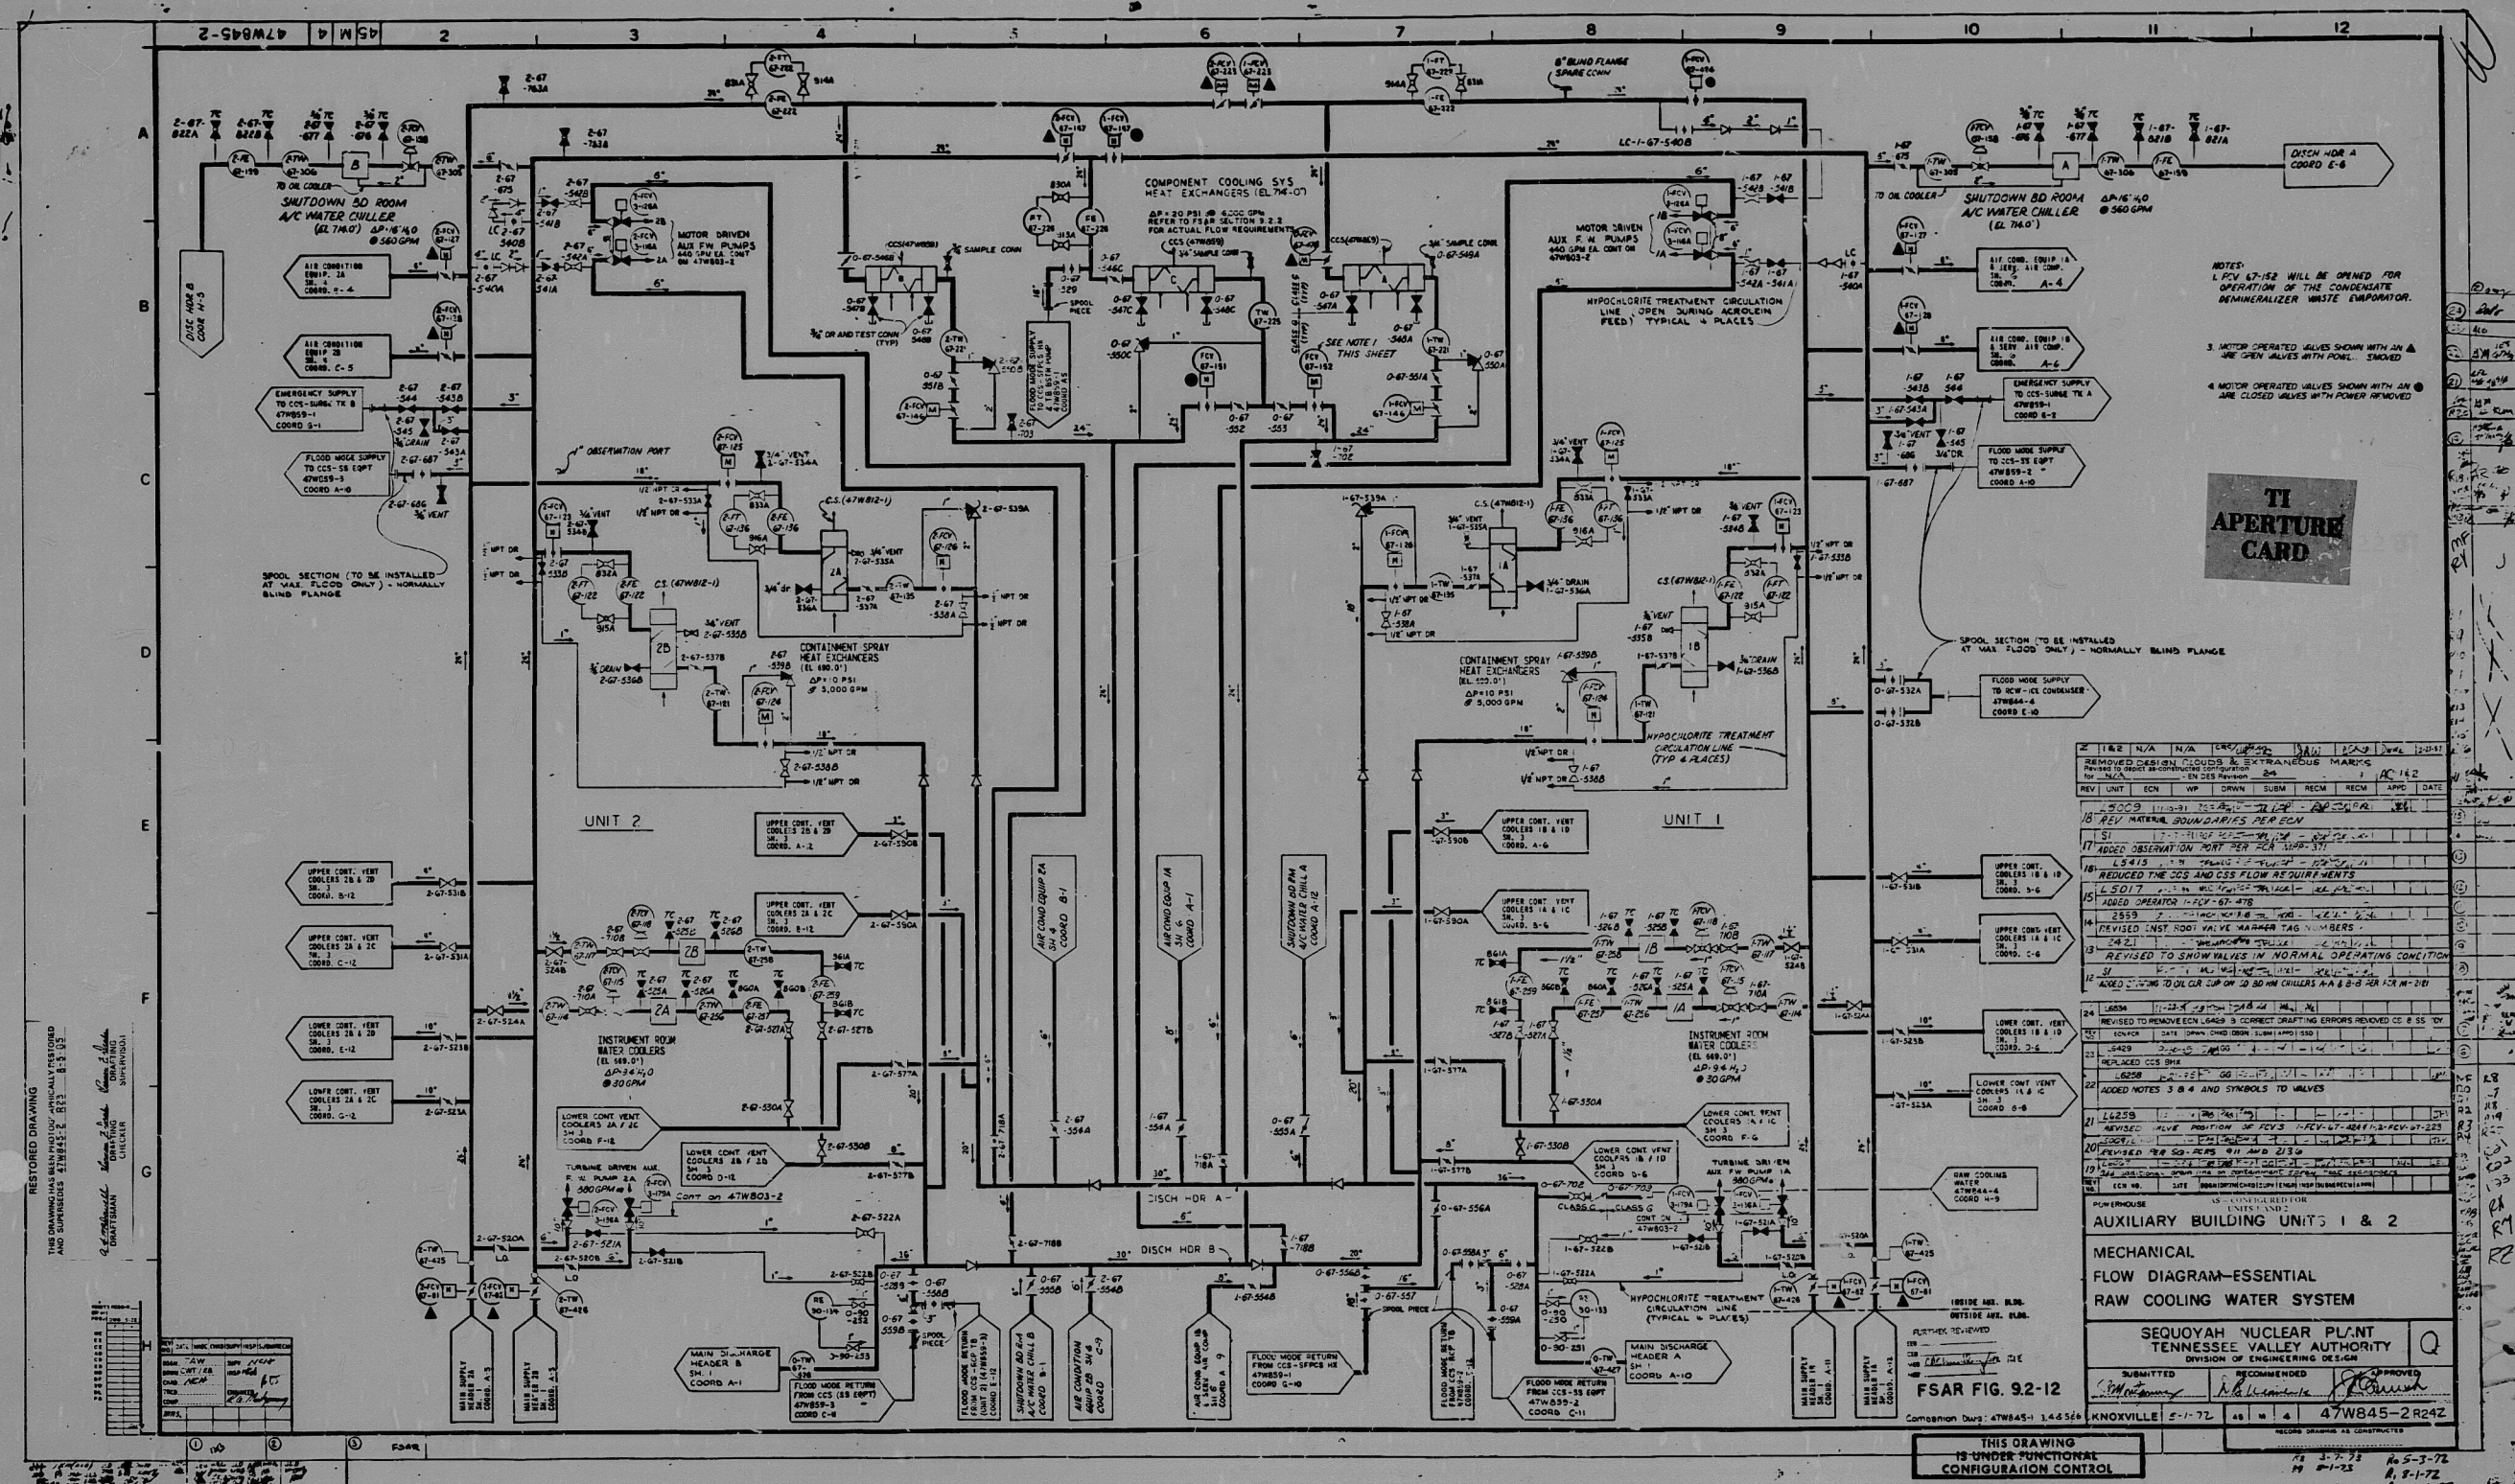

800024382

PDR RIDS

