


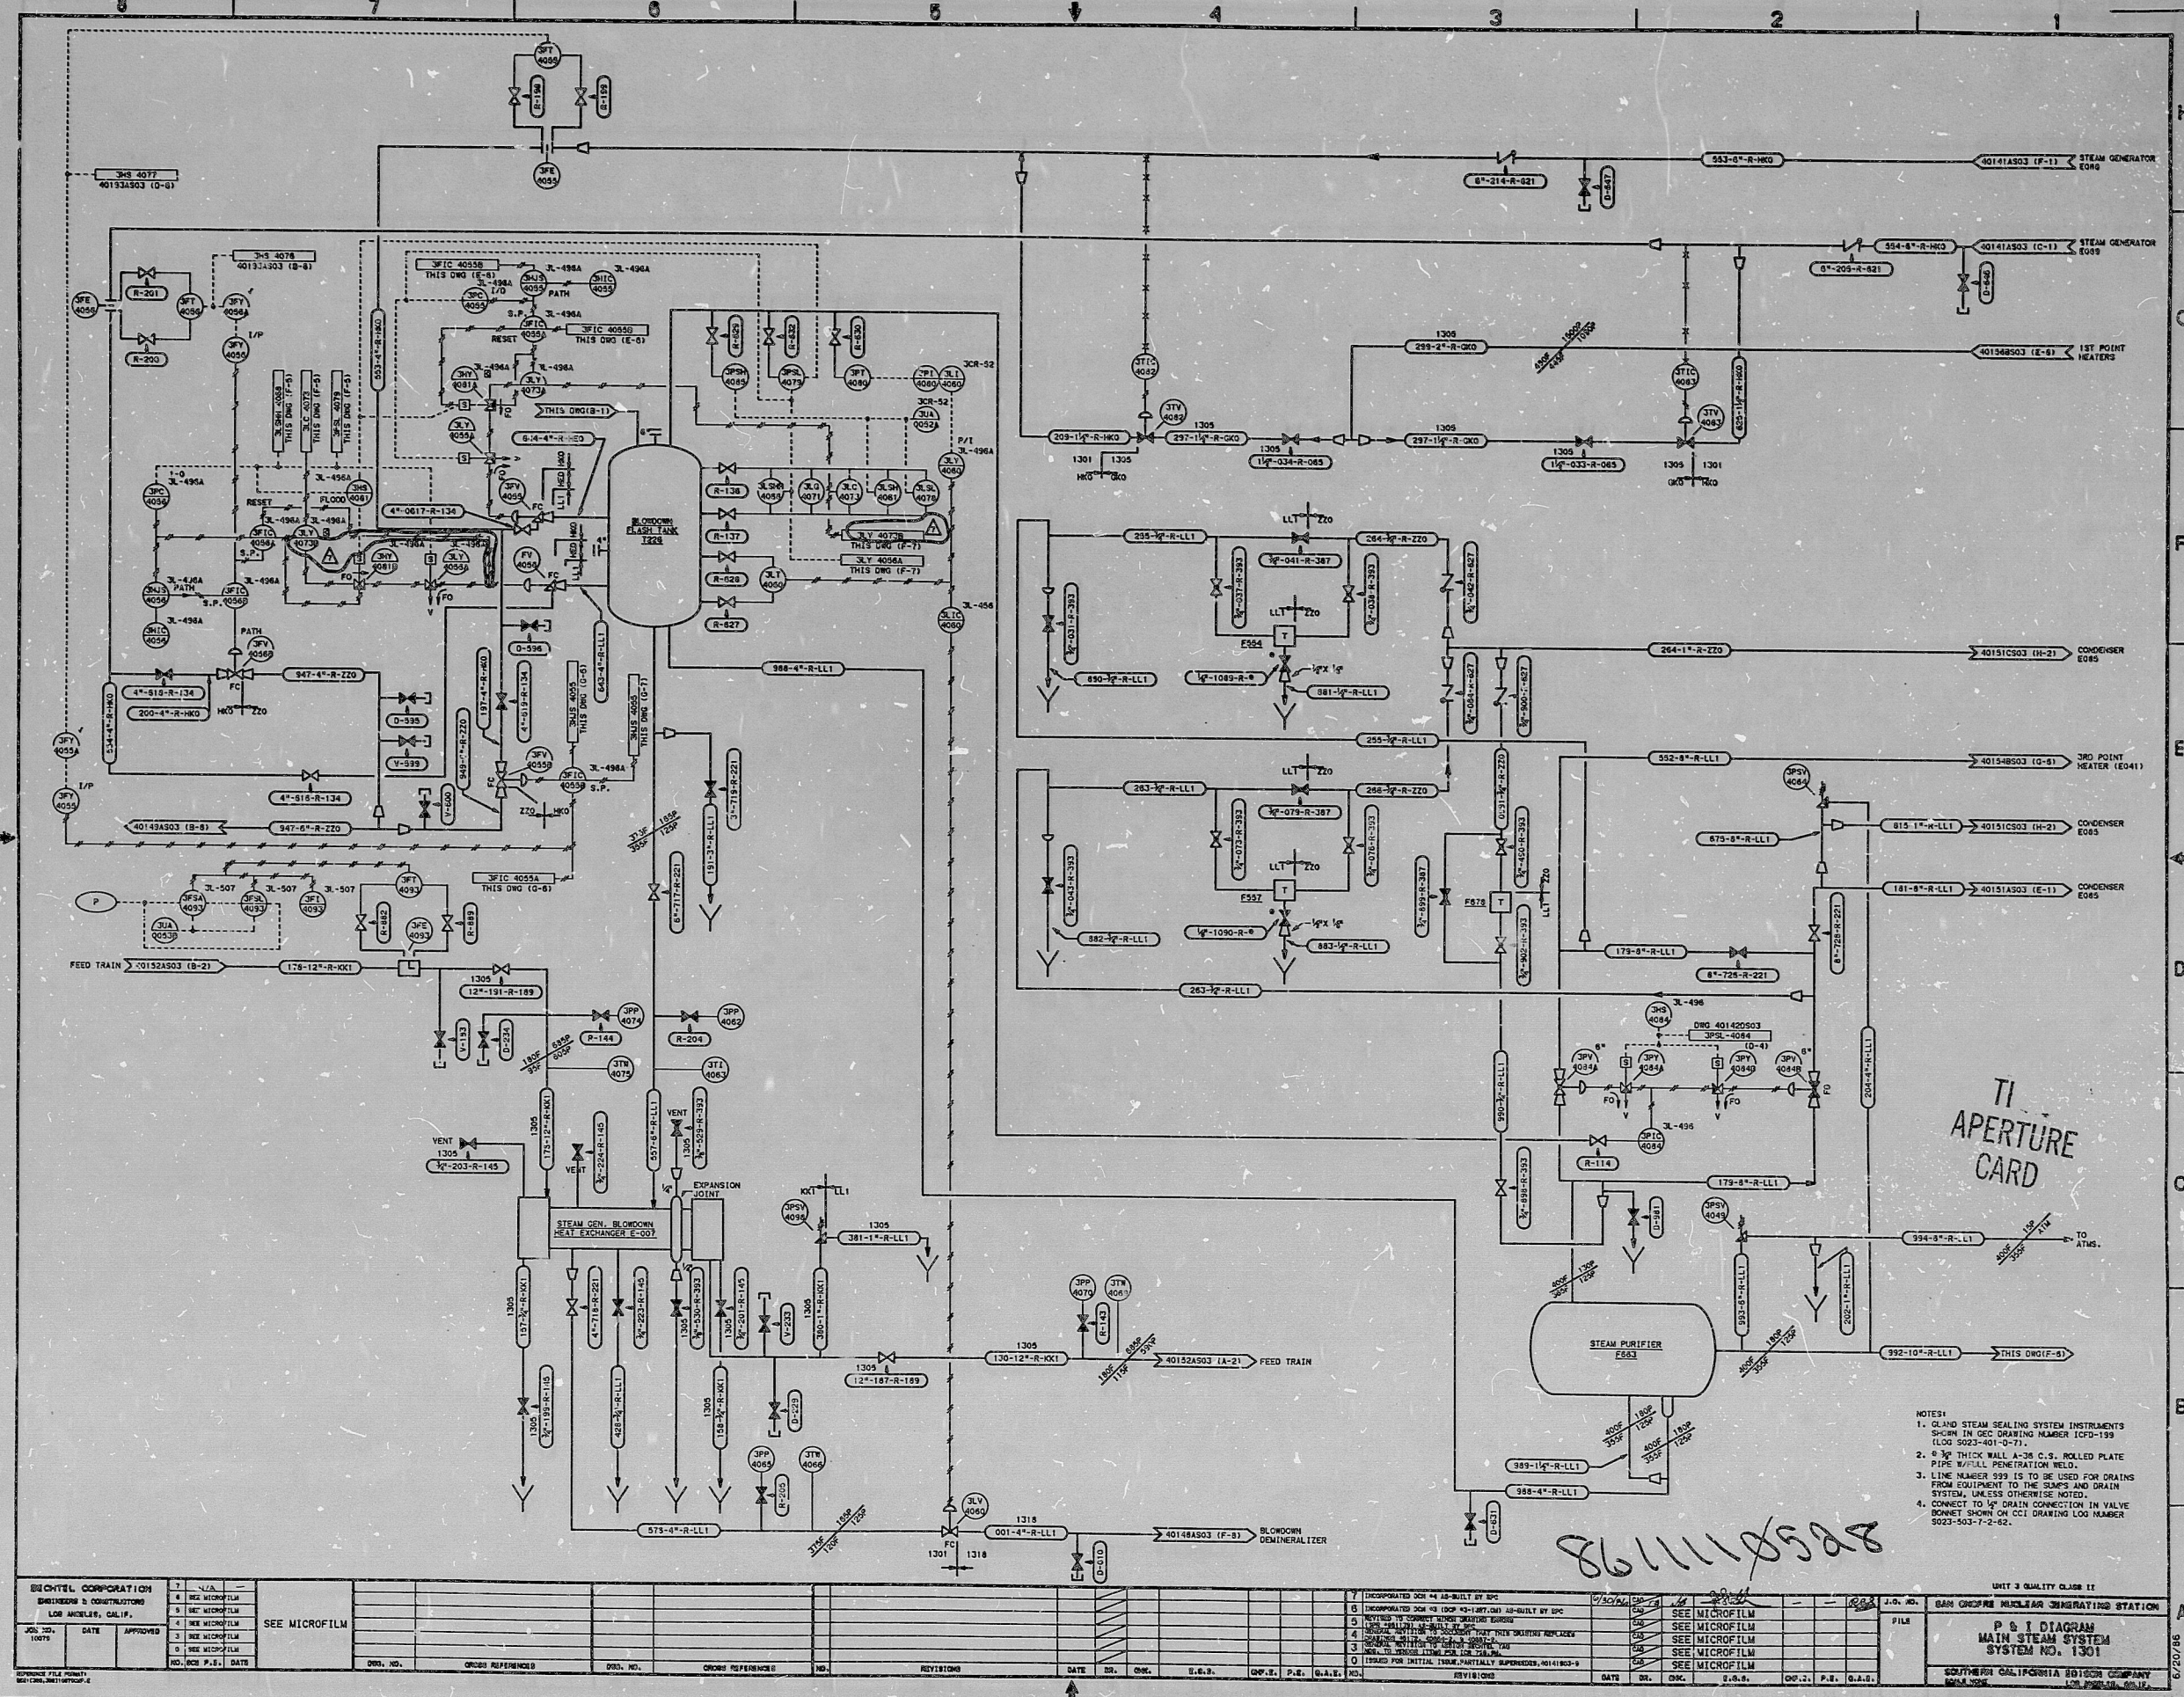

- NOTES:
1. GROUND STEAM SEALING SYSTEM INSTRUMENTS SHOWN IN DEC DRAWING NUMBER 1000-199 (LOD 8002-001-0-71).
 2. 6" THICK WALL A-36 C.S. ROLLED PLATE PIPE W/ALL PENETRATION WELD.
 3. LINE NUMBER 999 IS TO BE USED FOR DRAINING FROM EQUIPMENT TO THE SUMP AND DRAIN SYSTEM, UNLESS OTHERWISE NOTED.
 4. CONNECT TO 1" DRAIN CONNECTION IN VALVE BOWEN SHOWN ON CCI DRAWING LOD NUMBER 8002-503-7-2-62.

BRECHTEL CORPORATION DIVISION OF CONSTRUCTION LOS ANGELES, CALIF.										SEE MICROFILM										7 8 9 
---	--	--	--	--	--	--	--	--	--	---------------	--	--	--	--	--	--	--	--	--	---	--	--	--	--	--	--	--	--	--

PDR RIDS

8611110528

