
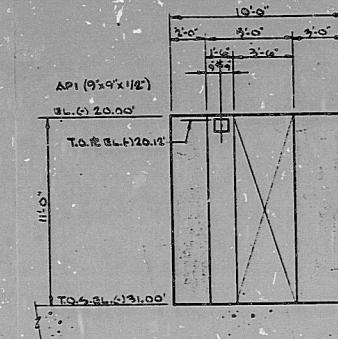
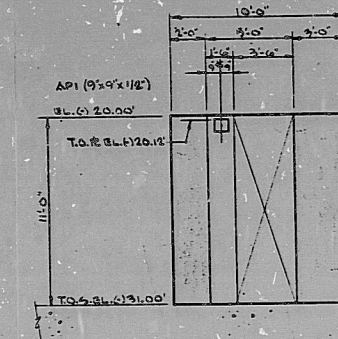
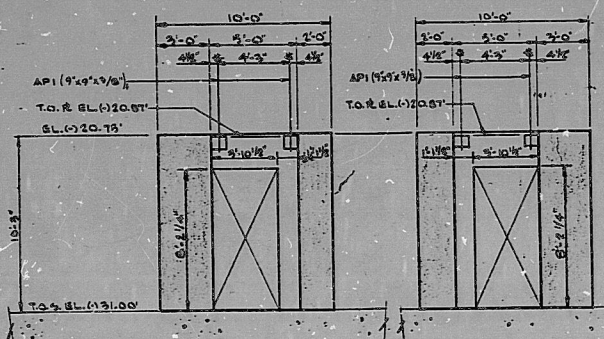
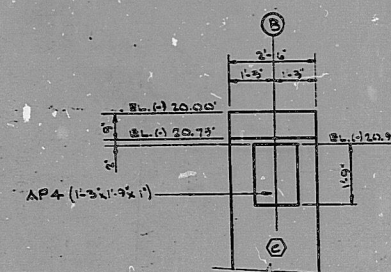
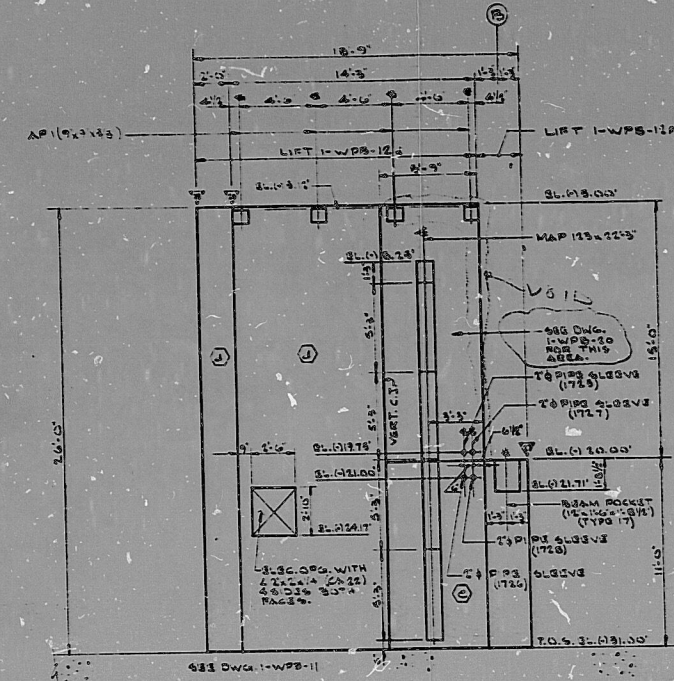
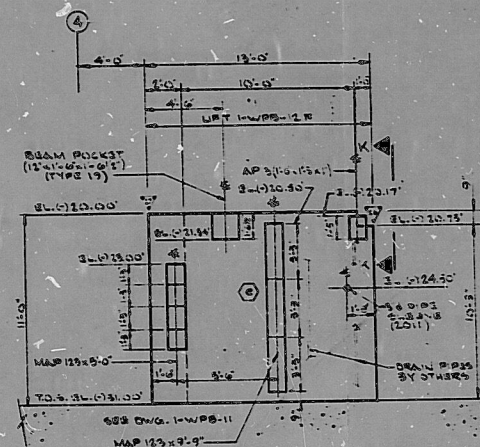


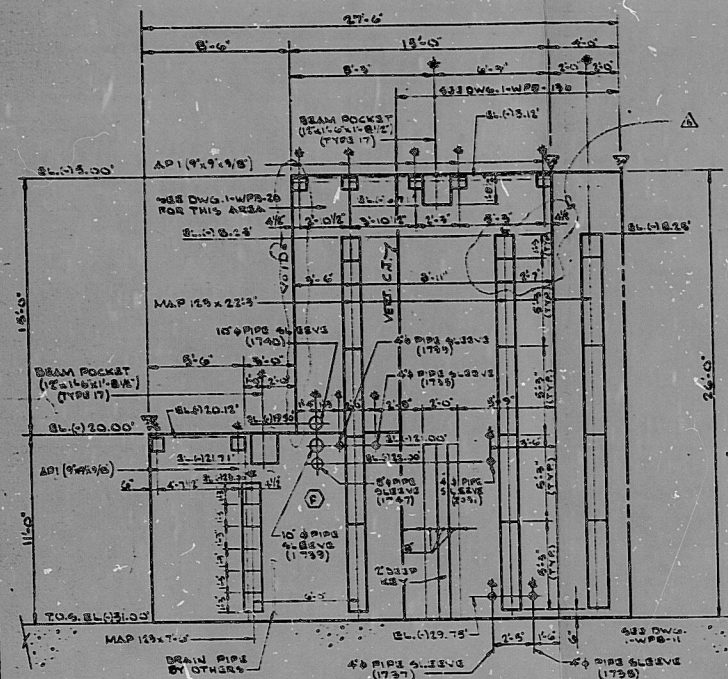

TI
APERTURE
CARD

FOR CRAFT USE
NOT FOR CHECK OUT
CHECK PRINT
U.E. & C. COPY

REV	1	ADD REMOVED HOLD	6/7/79	
ADD	PIPE 3"X3" FURNACE HOLD	11/5/79	5/2	
REV	2	ADD C.T. FURNACE HOLD	11/6/79	5/2
ADD	HOLD FOR OPTIMISE	11/7/79	5/2	
REV	PIPE 1"X1" PERLA 06/05/80	11/21/79	5/2	
REVISED	C.T.	12/18/79	5/2	
REV.		DESCRIPTION	DATE	APPR.

PERINI

POWER CONSTRUCTORS INC.

PROJECT SEABROOK STATION
SNH 223.9763-006-1

SUBJECT WASTE PROCESS BLDG.
WALLS FROM EL. 431.00 TO (VARIES)

DRAWN	T. SILVA	APPR.		DATE
SCALE	AS SHOWN			
DATE	10/31/79			
SIZ	DRAWING	WPS-12	(5.4)	REV NO. 10

SAFETY RELATED ITEM

[illegible][illegible]

PDR RIDS

8709030274

