


12177-PID-30C-4

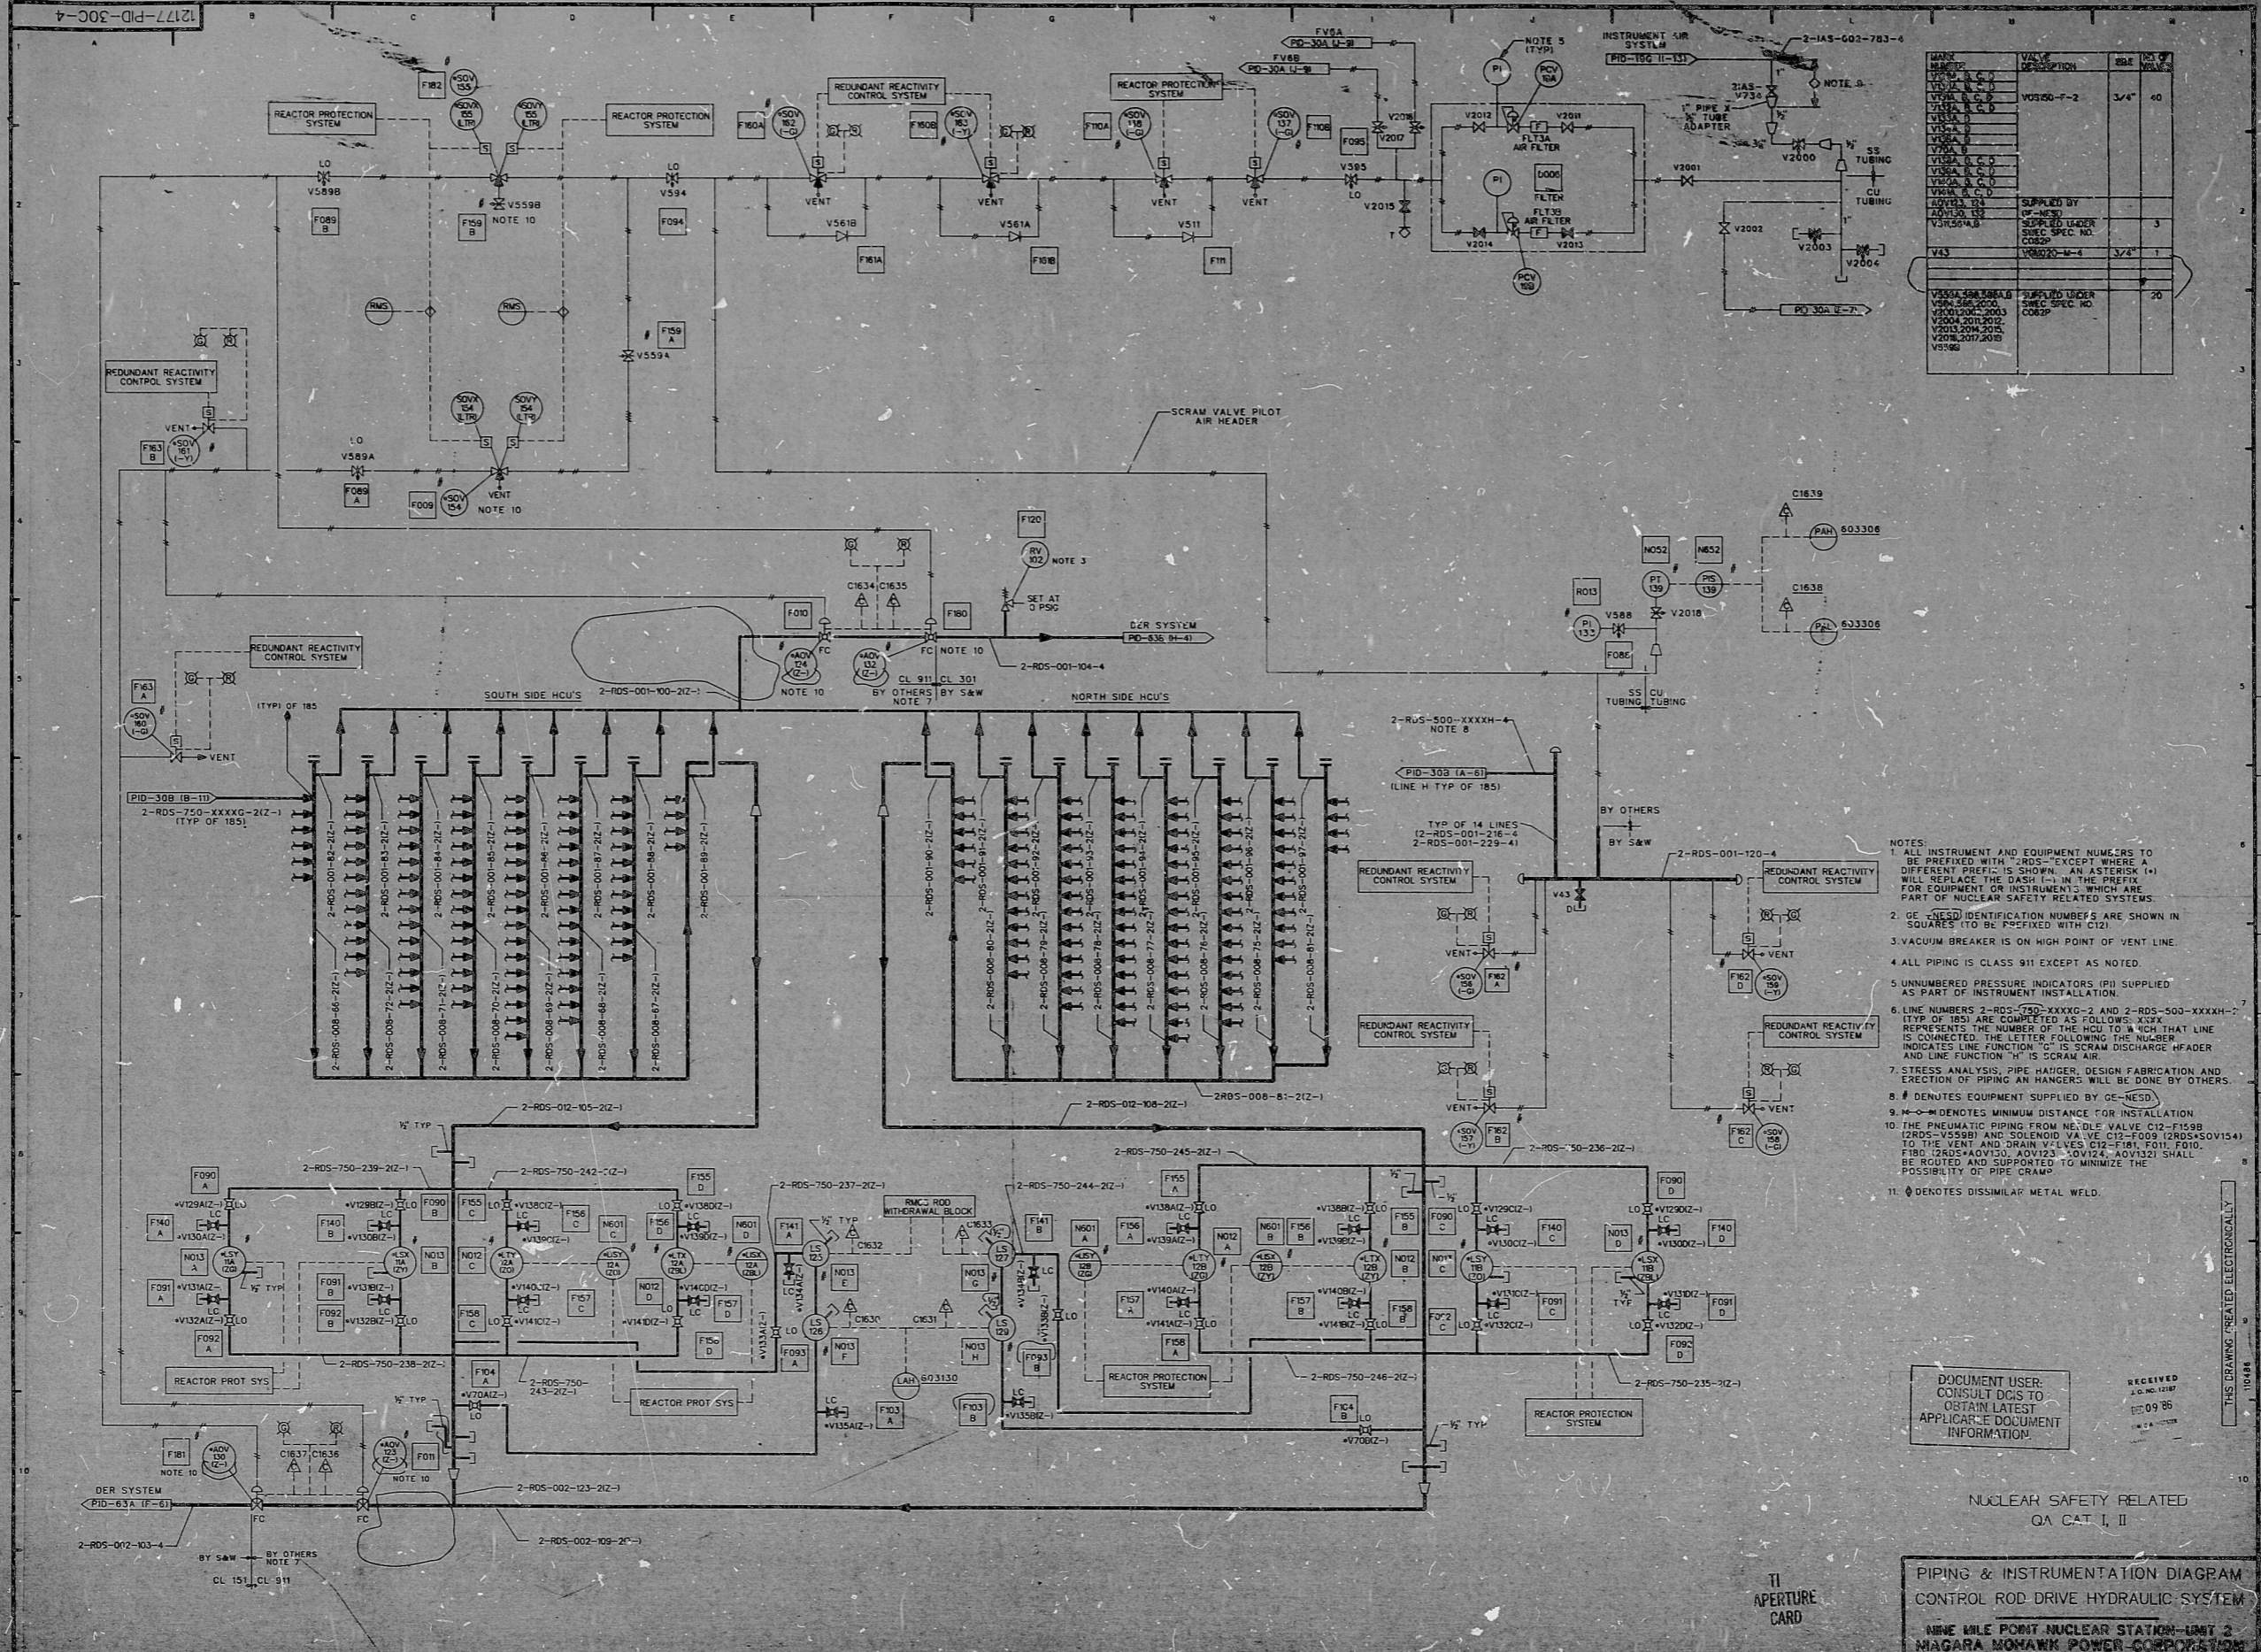

MARK	VALVE	DESCRIPTION	SIZE	MT

- NOTES:
1. ALL INSTRUMENT AND EQUIPMENT NUMBERS TO BE PREFIXED WITH 2-RDS- EXCEPT WHERE A DIFFERENT PREFIX IS SHOWN. AN ASTERISK (*) WILL REPLACE THE DASH (-) IN THE PREFIX FOR EQUIPMENT OR INSTRUMENTS WHICH ARE PART OF NUCLEAR SAFETY RELATED SYSTEMS.
 2. GE (AESD) IDENTIFICATION NUMBERS ARE SHOWN IN SQUARES (TO BE PREFIXED WITH C12).
 3. VACUUM BREAKER IS ON HIGH POINT OF VENT LINE.
 4. ALL PIPING IS CLASS 911 EXCEPT AS NOTED.
 5. UNNUMBERED PRESSURE INDICATORS (PI) SUPPLIED AS PART OF INSTRUMENT INSTALLATION.
 6. LINE NUMBERS 2-RDS-750-XXXX-2 AND 2-RDS-500-XXXX-2 TYP OF 185 ARE CONVERTED AS FOLLOWS: XXXX REPRESENTS THE NUMBER OF THE HCU TO WHICH THAT LINE IS CONNECTED. THE LETTER FOLLOWING THE NUMBER INDICATES LINE FUNCTION: 'C' IS SCRAM DISCHARGE HEADER AND LINE FUNCTION 'H' IS SCRAM AIR.
 7. STRESS ANALYSIS, PIPE HANGER, DESIGN FABRICATION AND ERECTION OF PIPING AND HANGERS WILL BE DONE BY OTHERS.
 8. # DENOTES EQUIPMENT SUPPLIED BY GE-NEED.
 9. #--#--# DENOTES MINIMUM DISTANCE FOR INSTALLATION.
 10. THE PNEUMATIC PIPING FROM NEEDLE VALVE C12-F1598 (2-RDS-V5598) AND SOLENOID VALVE C12-F009 (2-RDS-V5015) TO THE VENT AND DRAIN V-LINES C12-F181, F011, F010, F180 (2-RDS-ADV130, ADV123, ADV124, ADV132) SHALL BE ROUTED AND SUPPORTED TO MINIMIZE THE POSSIBILITY OF PIPE CRAMP.
 11. # DENOTES DISSIMILAR METAL WELD.

DOCUMENT USER:
CONSULT DCIS TO
OBTAIN LATEST
APPLICABLE DOCUMENT
INFORMATION

NUCLEAR SAFETY RELATED
QA CAT. I, II

PIPING & INSTRUMENTATION DIAGRAM
CONTROL ROD DRIVE HYDRAULIC SYSTEM

NINE MILE POINT NUCLEAR STATION-UNIT 2
NIAGARA MOHAWK POWER CORPORATION
STONE & WEBSTER ENGINEERING CORPORATION
CORNY, N.Y.

T1
APERTURE
CARD

INCORPORATES ECH NO'S RDS-014, 403, 603, 604, 014	AS 18510 ISSUE INCORPORATES ECH NO'S RDS-014, 403, 603, 604, 014	INCORPORATES ECH NO'S RDS-004, 088, 011, 013	ORIGINAL ISSUE INCORPORATES ECH NO'S RDS-004, 011, 007
--	--	---	--

PDR RIDS

8709170052

