


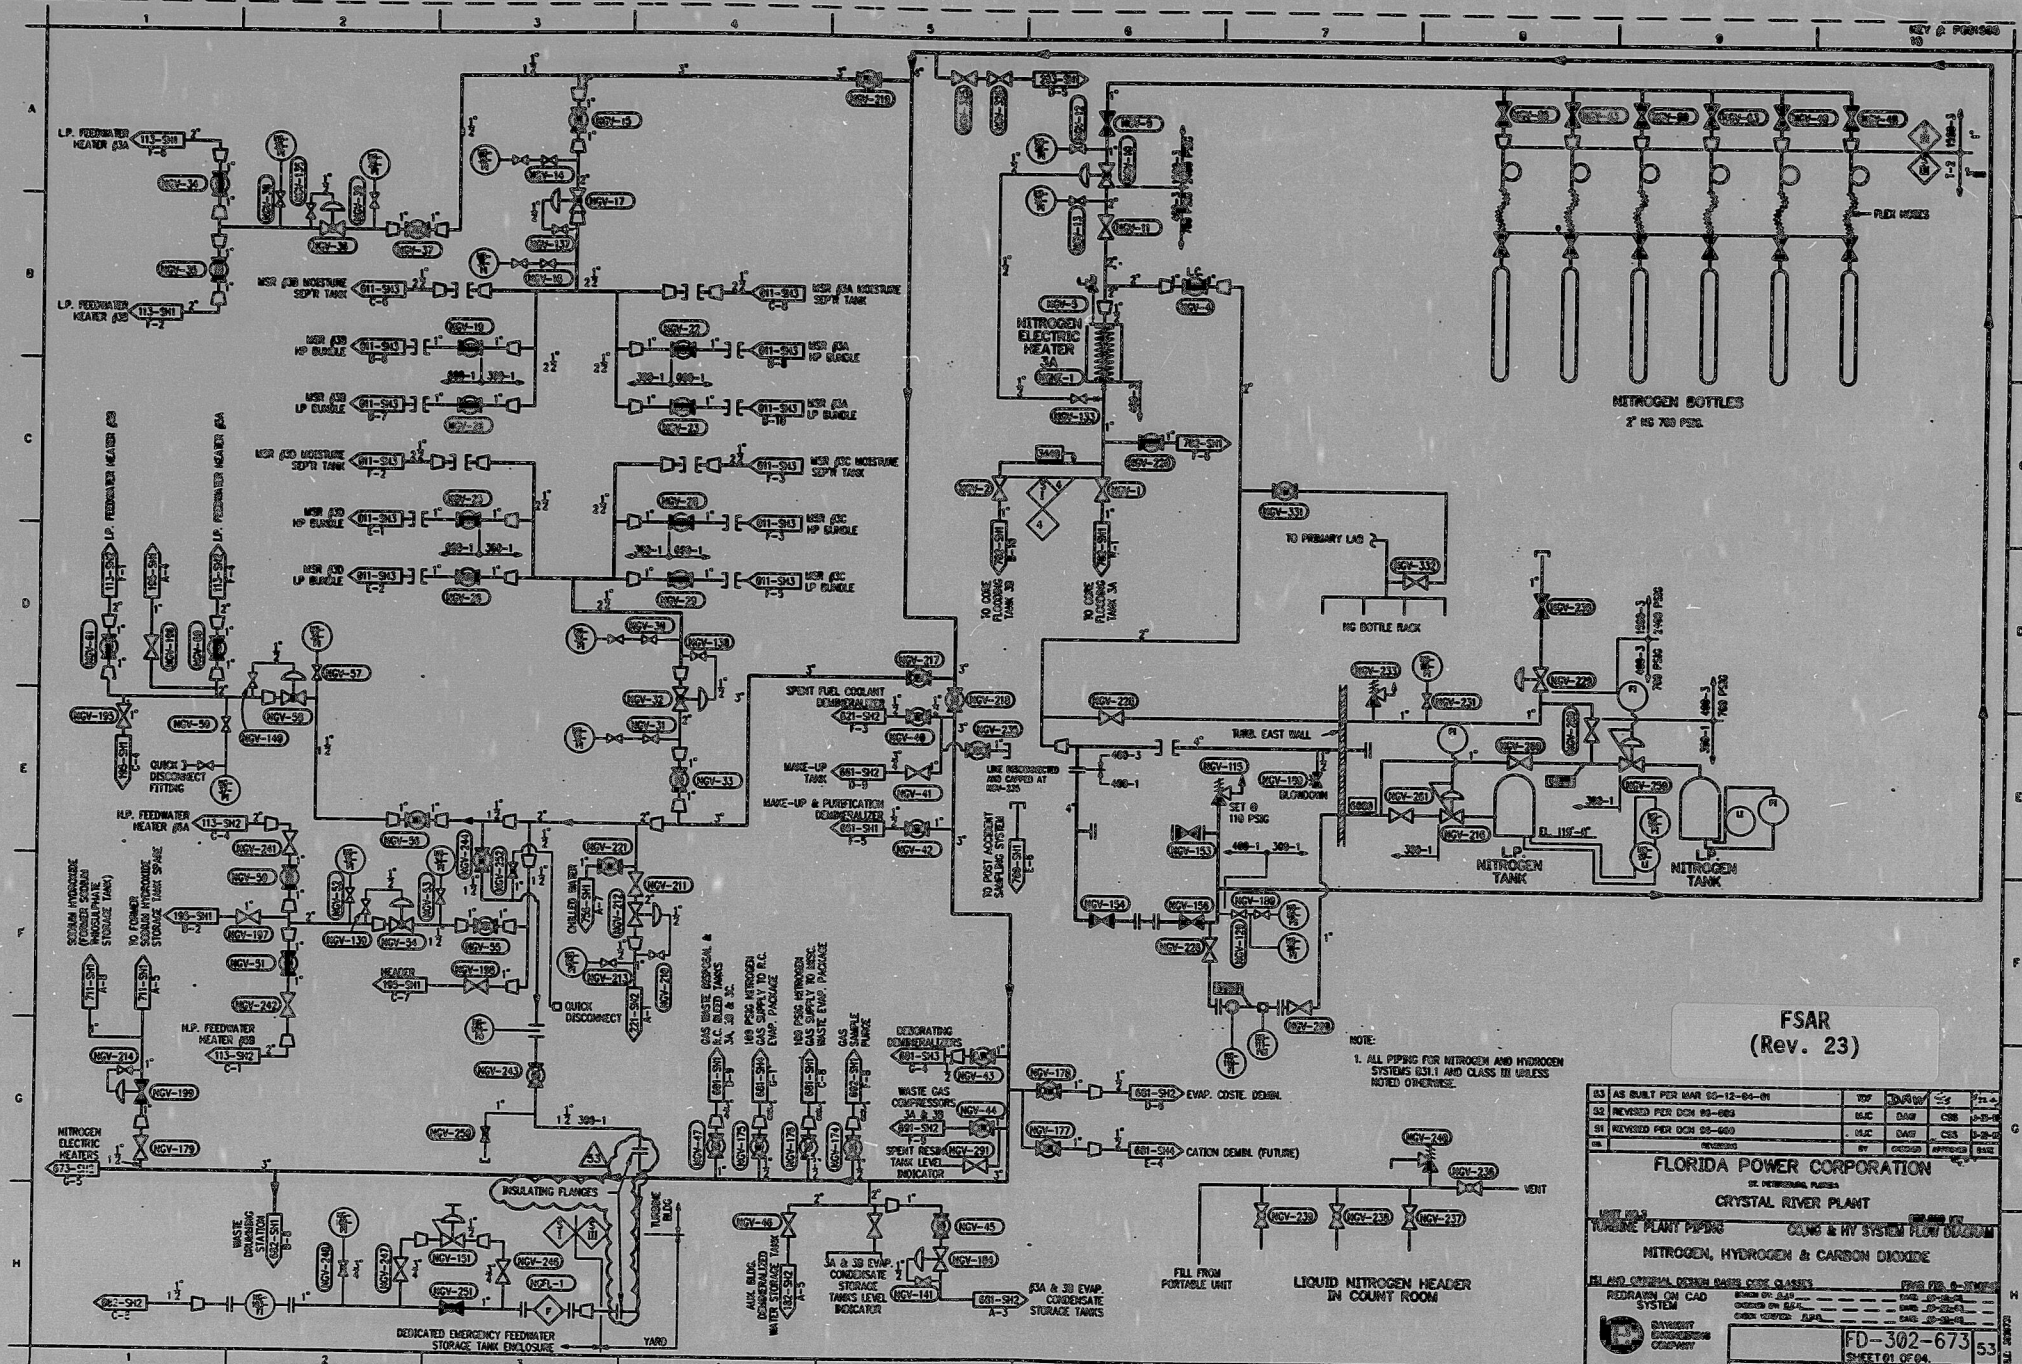

ANSTEC
APERTURE
CARD

9611290113

PDR RIDS

9611290113

