


12177-PID-538-6

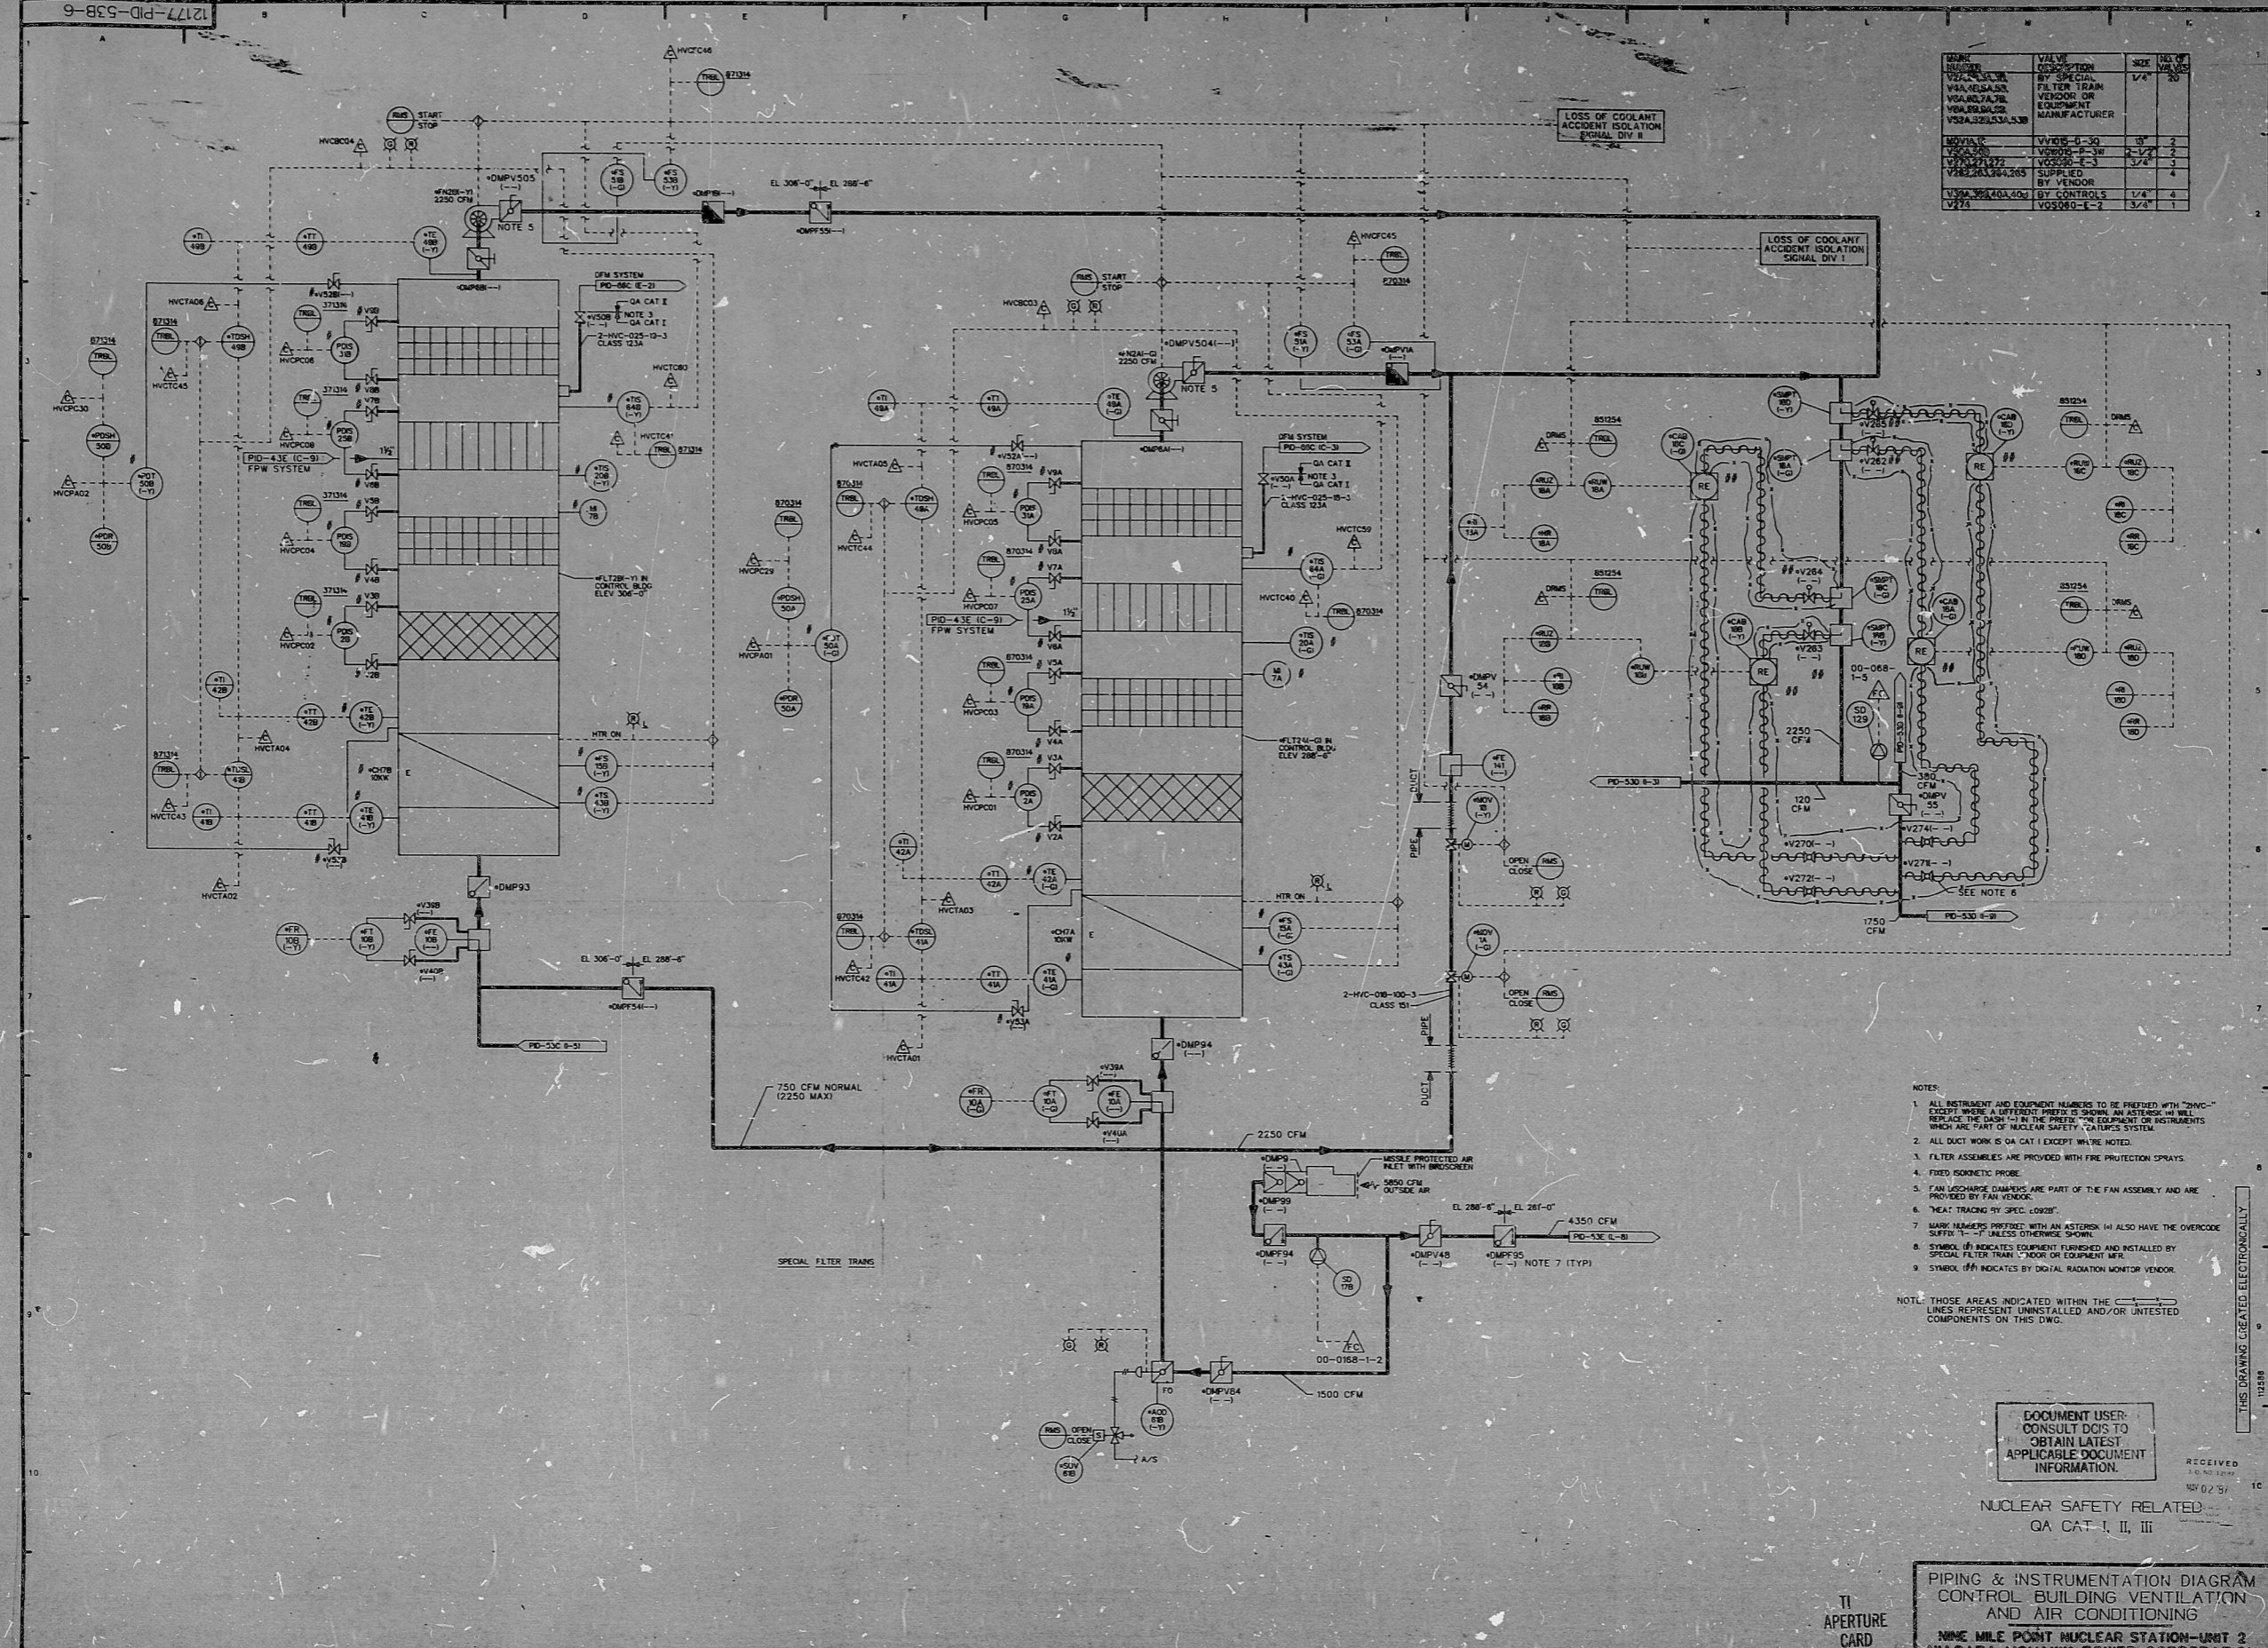


- NOTES:
1. ALL INSTRUMENT AND EQUIPMENT NUMBERS TO BE PREFIXED WITH "20VC" EXCEPT WHERE A DIFFERENT PREFIX IS SHOWN. AN ASTERISK (*) WILL REPLACE THE DASH (-) IN THE PREFIX FOR INSTRUMENTS WHICH ARE PART OF NUCLEAR SAFETY SYSTEM.
 2. ALL DUCT WORK IS QA CAT I EXCEPT WHERE NOTED.
 3. FILTER ASSEMBLIES ARE PROVIDED WITH FIRE PROTECTION SPRAYS.
 4. FIXED SONNETIC PROBE.
 5. FAN LEAKAGE DAMPERS ARE PART OF THE FAN ASSEMBLY AND ARE PROVIDED BY FAN VENDOR.
 6. "TAC" TRACKING BY SPEC. 02079.
 7. MARK NUMBERS PREFIXED WITH AN ASTERISK (*) ALSO HAVE THE OVERCOCK SAFETY TYPED UNLESS OTHERWISE SHOWN.
 8. SYMBOL (F) INDICATES EQUIPMENT FURNISHED AND INSTALLED BY SPECIAL FILTER TRAN TRAN OR EQUIPMENT MFR.
 9. SYMBOL (M) INDICATES BY DIGITAL RADIATION MONITOR VENDOR.
- NOTE: THOSE AREAS INDICATED WITHIN THE LINES REPRESENT UNINSTALLED AND/OR UNTESTED COMPONENTS ON THIS DWG.

DOCUMENT USER CONSULT DCS TO OBTAIN LATEST APPLICABLE DOCUMENT INFORMATION.

NUCLEAR SAFETY RELATED QA CAT I, II, III


TI APERTURE CARD


12177-PID-538-6

PDR RIDS

8709170132

