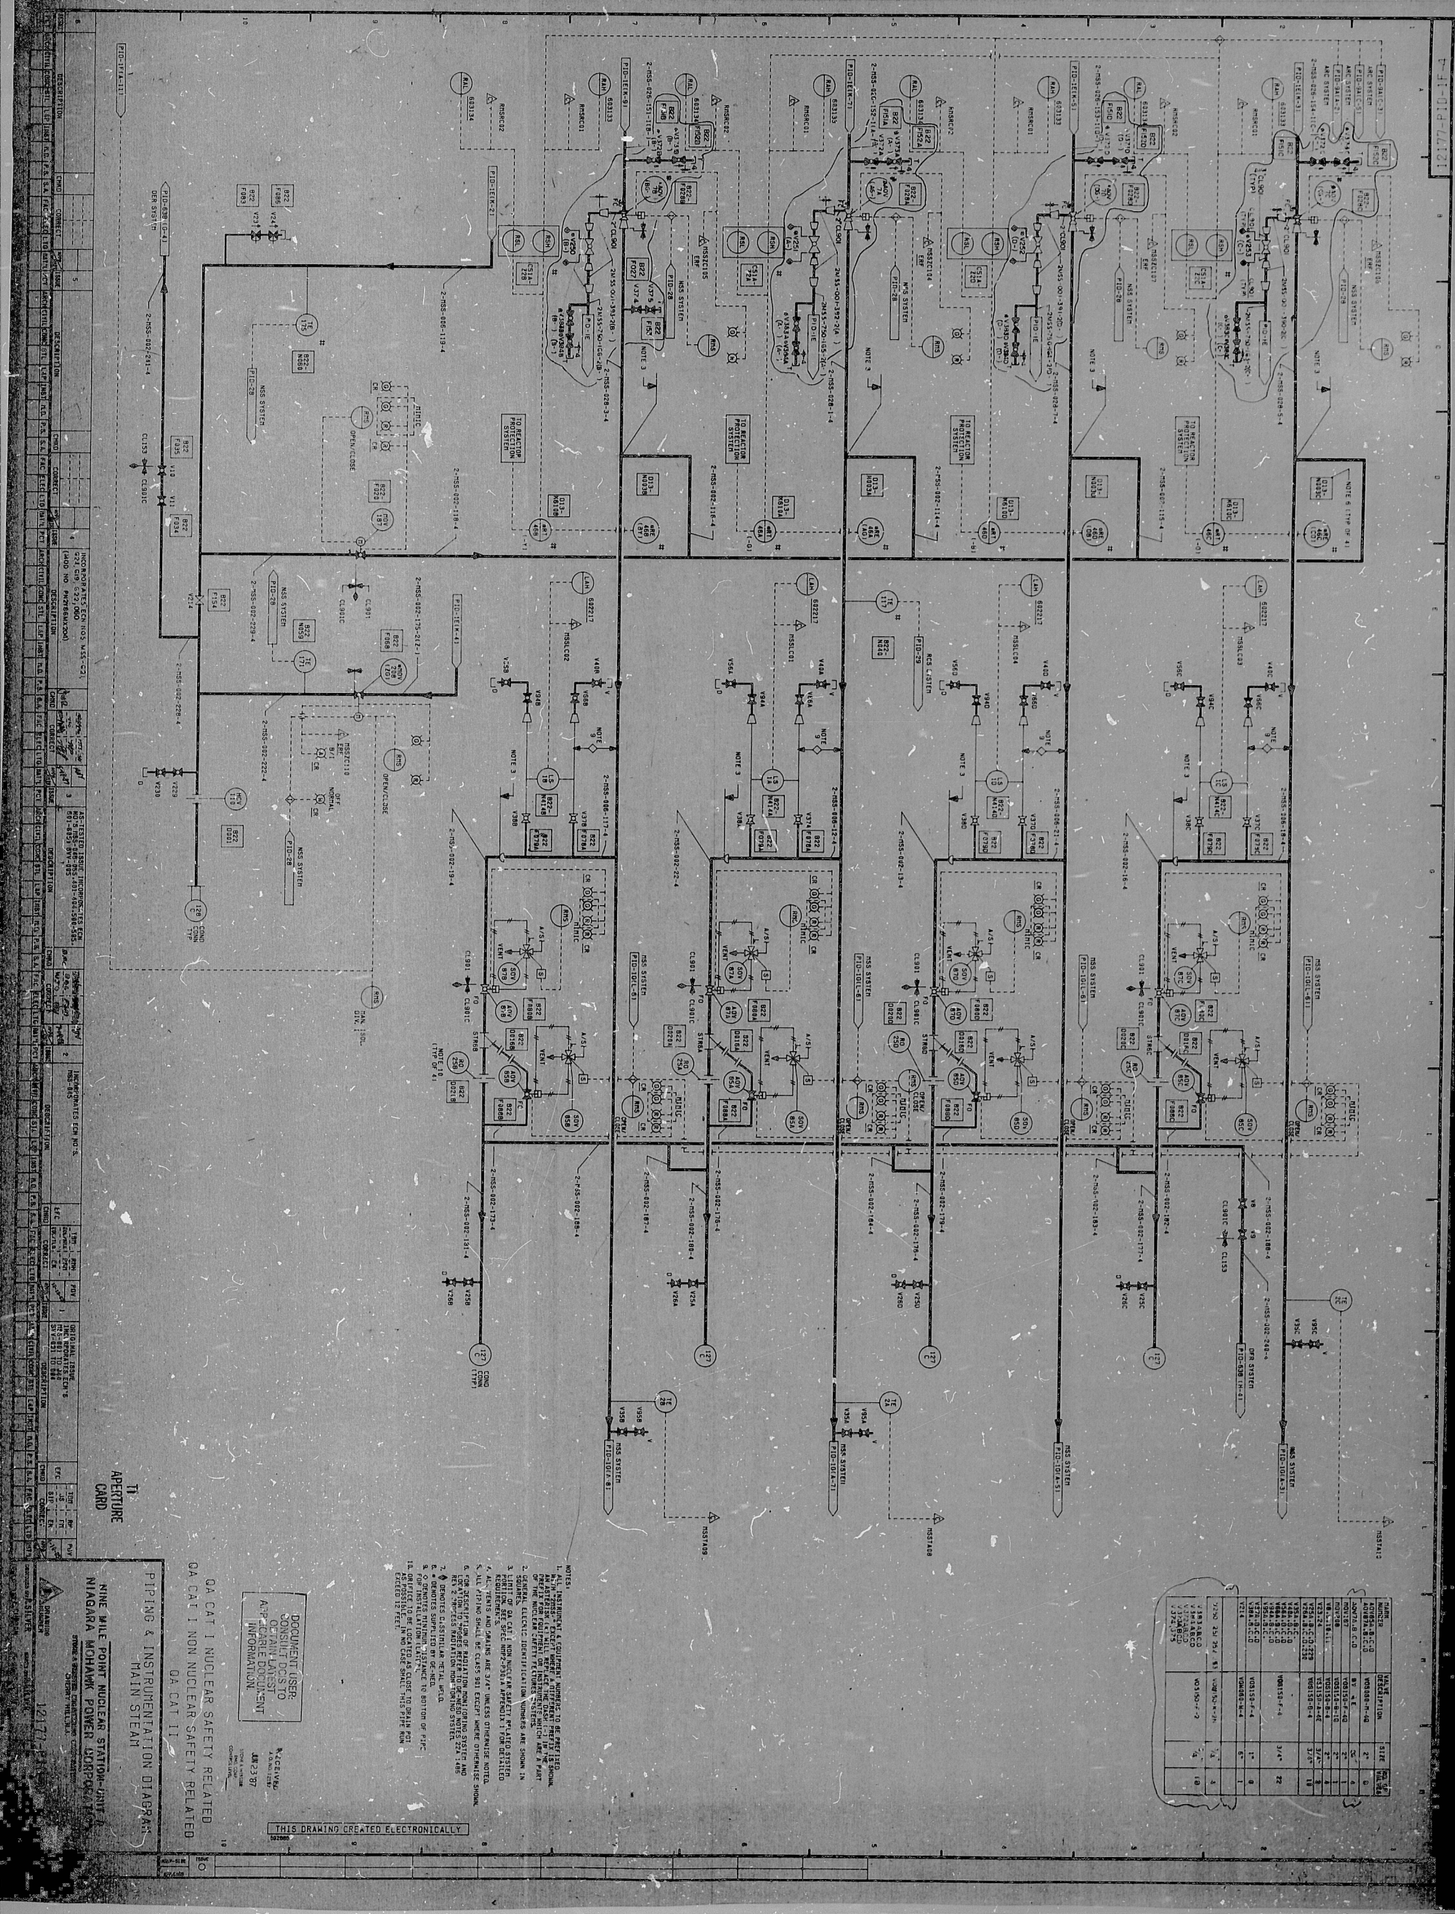
12177-P10-1F-4
NOTES:
1. ALL INSTRUMENTS & EQUIPMENT NUMBERS TO BE PREFIXED BY THE PLANT DESIGNATION NUMBER 12177 WHEN REFERRED TO OUTSIDE THE DRAWING. THIS PREFIX IS NOT SHOWN ON THE DRAWING BECAUSE IT IS PART OF THE NUCLEAR CAPITY FILTERED SYSTEMS.
2. SIGNAL ELECTRIC IDENTIFICATION NUMBERS ARE SHOWN IN BRACKETS.
3. SIGNAL ELECTRIC CABLE NUMBERS ARE NOT SHOWN.
4. ALL TERMS AND GRAINS ARE 316 UNLESS OTHERWISE NOTED.
5. ALL PIPING SHALL BE CLASS 901 EXCEPT WHERE OTHERWISE SHOWN.
6. CONNECTIONS TO HIGHER PRESSURE PORTION WITH STEPS AND CONNECTIONS TO LOWER PRESSURE PORTION WITH TRIANGLE.
7. ALL PIPING SHALL BE SCHEDULE 40.
8. ⊕ DENOTES SUPPLIED BY OE-MEN.

PDR RIDS

8709170375

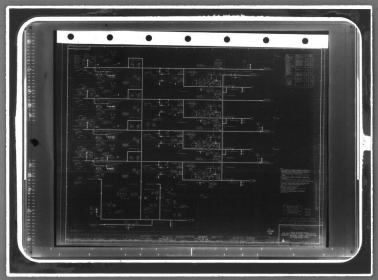

MMM 5824 FILMSORT® Brand Aperture & Camera Cards and DUPLICARD® Brand Copy Cards – Product of 3M, St. Paul, Minn.