


12177-PID-136-S

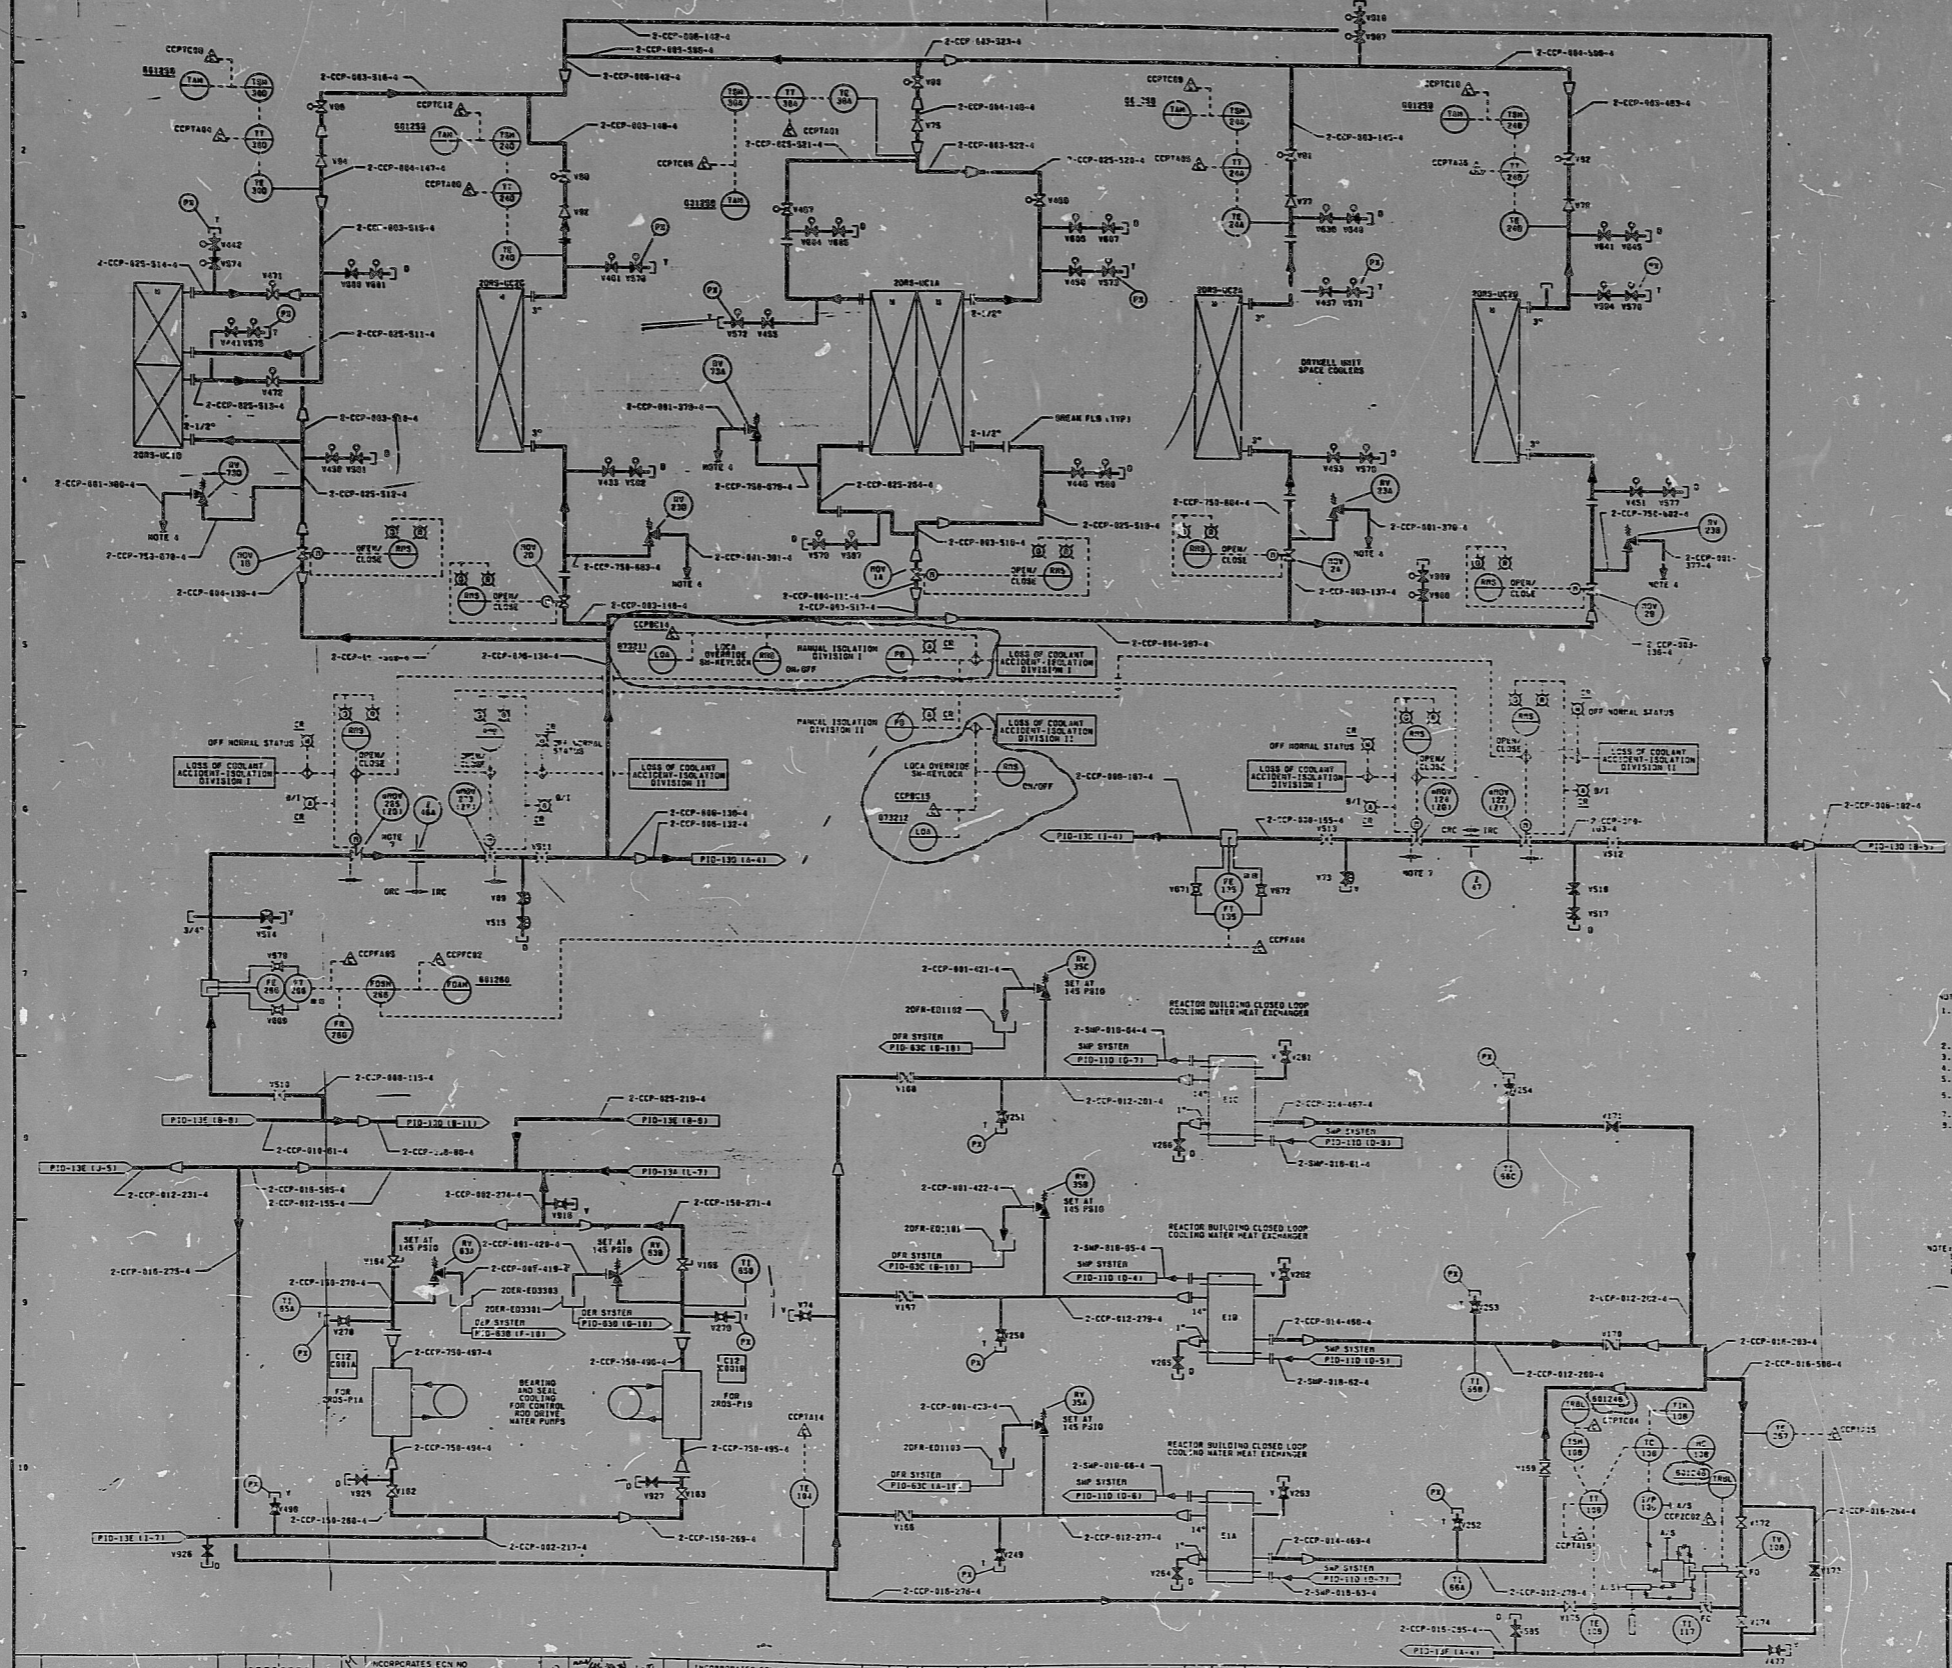

- NOTES:
1. ALL INSTRUMENTS AND EQUIPMENT NUMBERS TO BE PROVIDED WITH "CCP-100" PREFIX AND A SUFFICIENT PREFIX TO SHOW AN INSTRUMENT IS WITHIN THE DASH IN THE PREFIX FOR EQUIPMENT OR INSTRUMENTS WHICH ARE A PART OF NUCLEAR SAFETY RELATED SYSTEMS.
 2. I.E. IDENTIFICATION NUMBERS ARE SHOWN IN SQUARES.
 3. ALL PIPING TO BE CLASSIFIED AS NUCLEAR SAFETY RELATED.
 4. RELIEF VALVES SET AT 145 PSIG & CLOSED TO PLATFORM 4.00 ARE NOTED.
 7. CONTINGENT ISOLATION VALVES INSTALLED IN END OF PENETRATIONS.
 8. "M" DENOTES ANNULAR PIPING AND VALVES BY ANNULAR MANUFACTURER.

NOTE: THOSE AREAS INDICATED WITHIN THE DASHED LINES REPRESENT UNINSTALLED AND/OR UNTESTED INSTRUMENTS ON THIS DASH AND ARE NOTIFIED BY FOLLOWING:

TI
APERTURE
CARD

NUCLEAR SAFETY RELATED
SA CAT 1.11

PIPING & INSTRUMENTATION DIAGRAM
REACTOR BLDG CLOSED
LOOP COOLING WATER

NINE MILE POINT NUCLEAR STATION-UNIT 2
NIAGARA MOHAWK POWER CORPORATION


12177-PID-136-S


PDR RIDS

8709170503

