


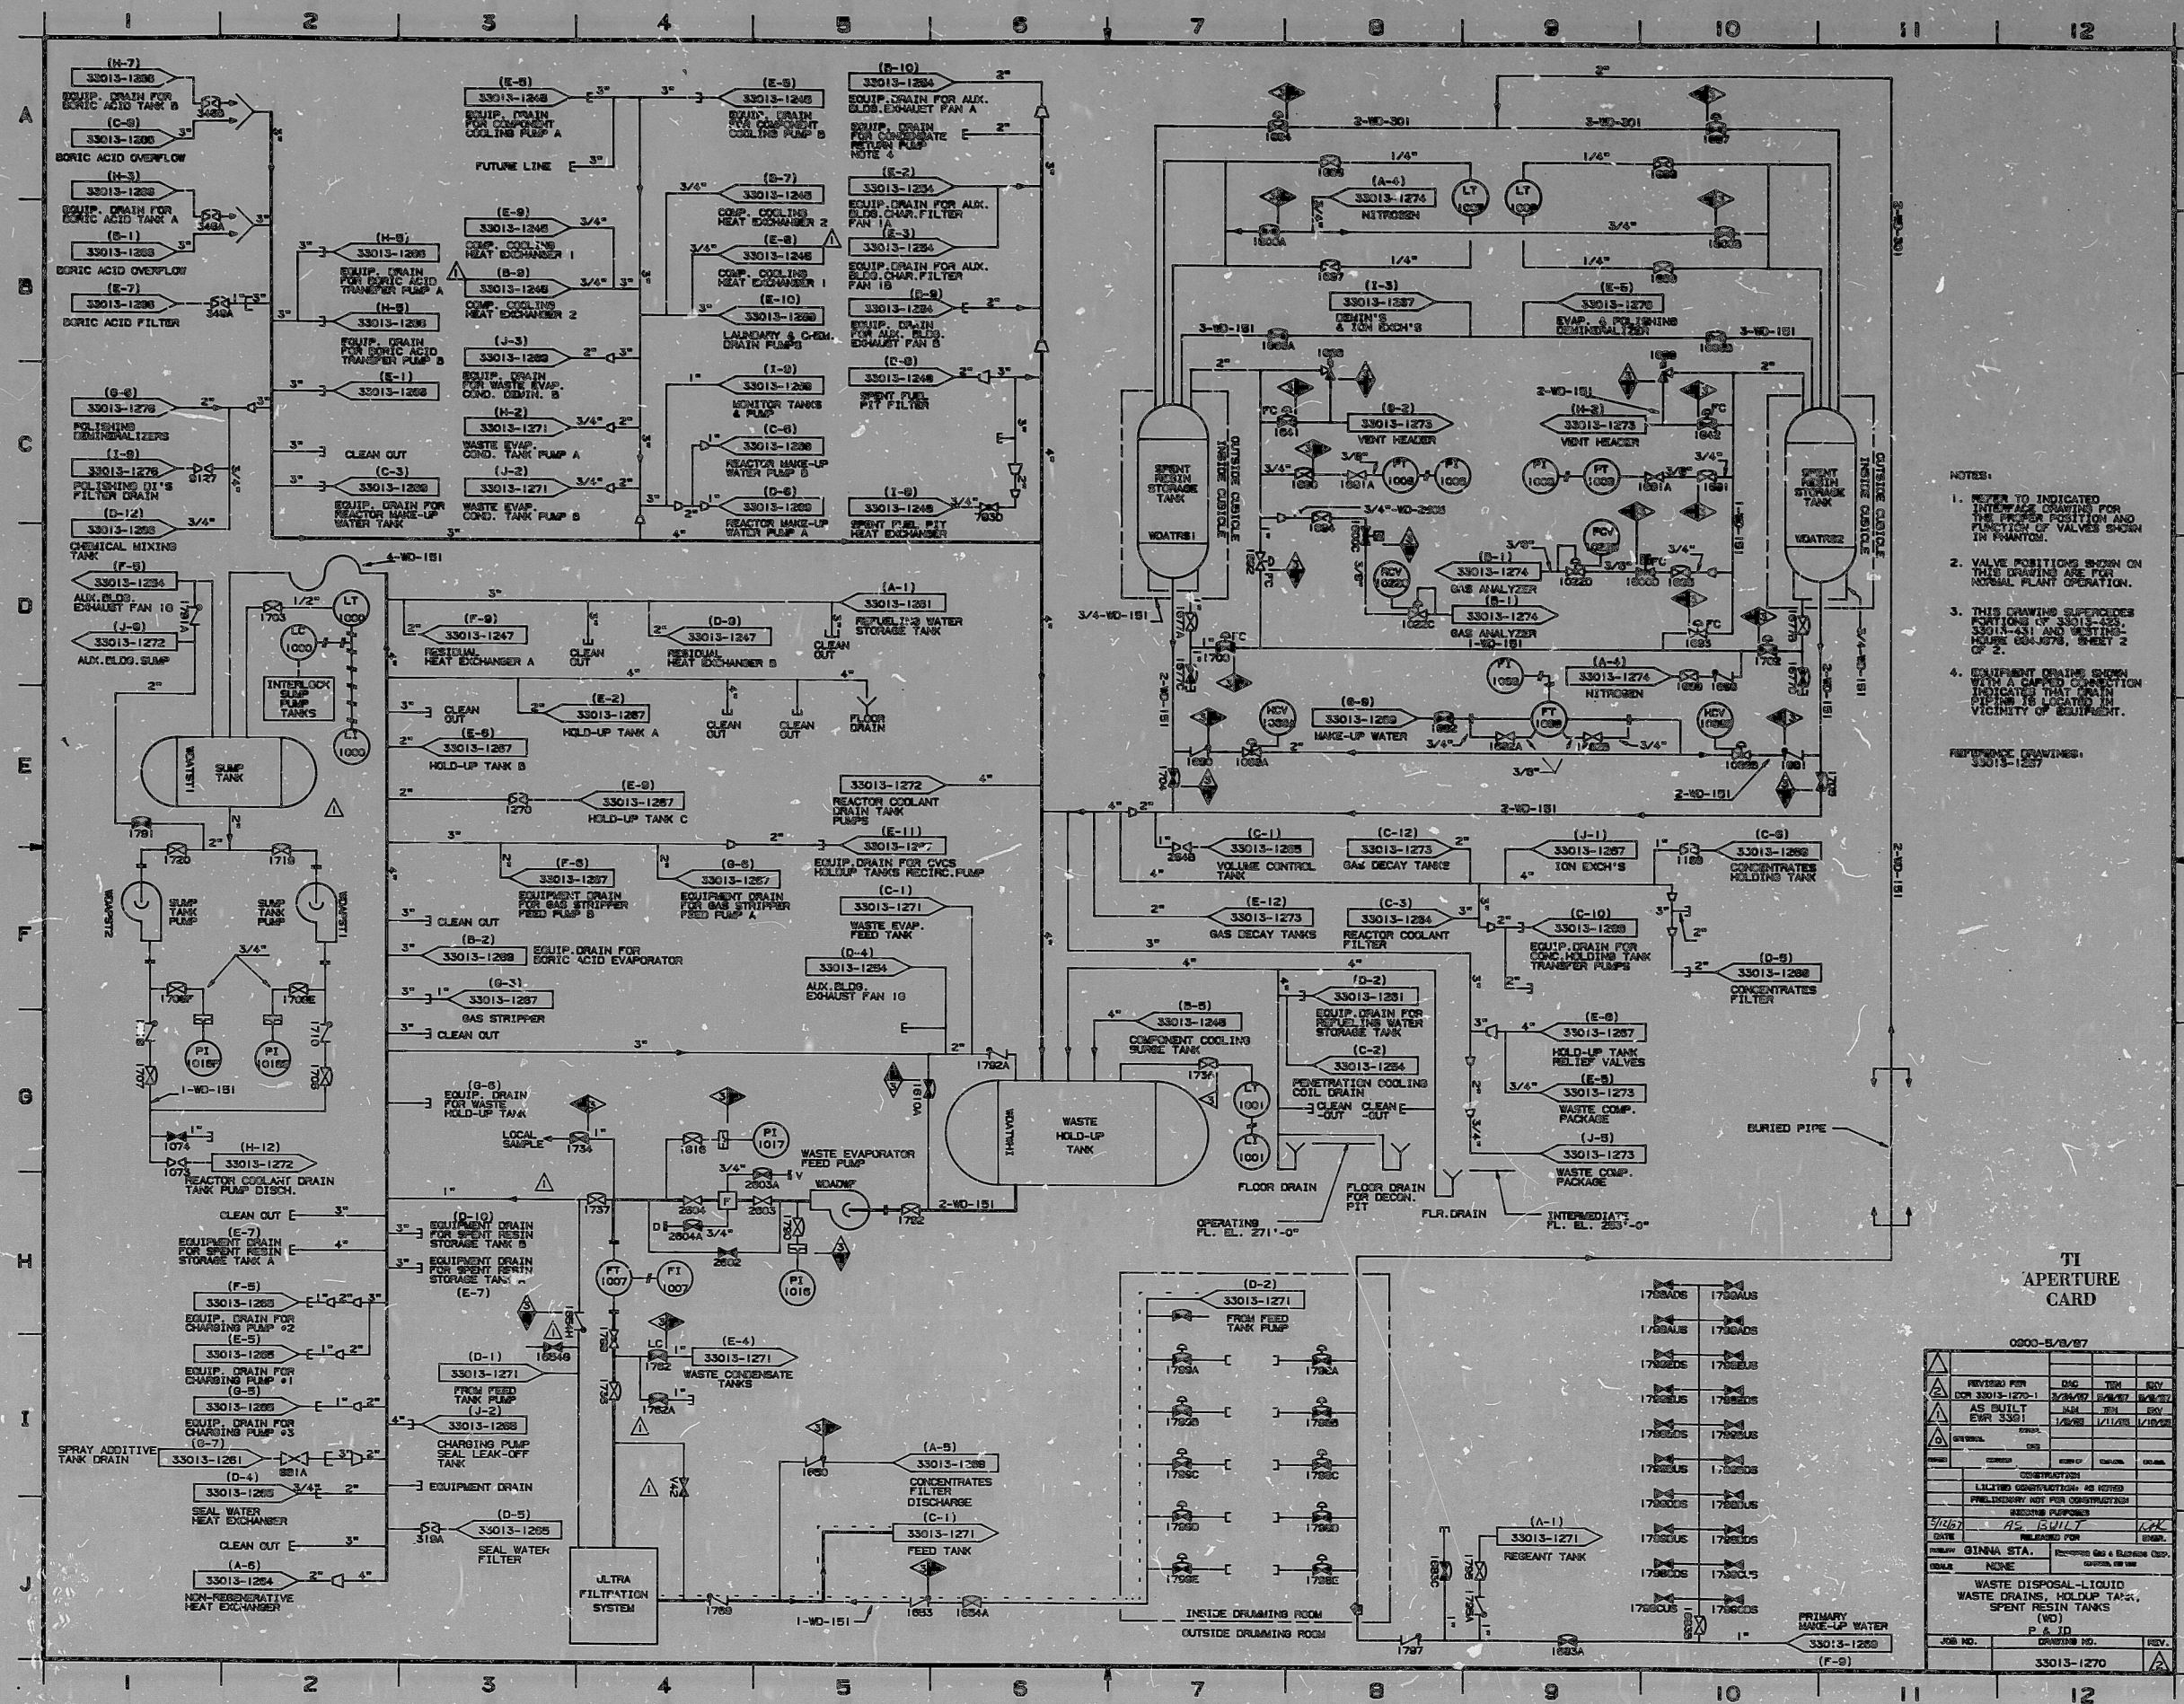

PDR RIDS

8710220342

